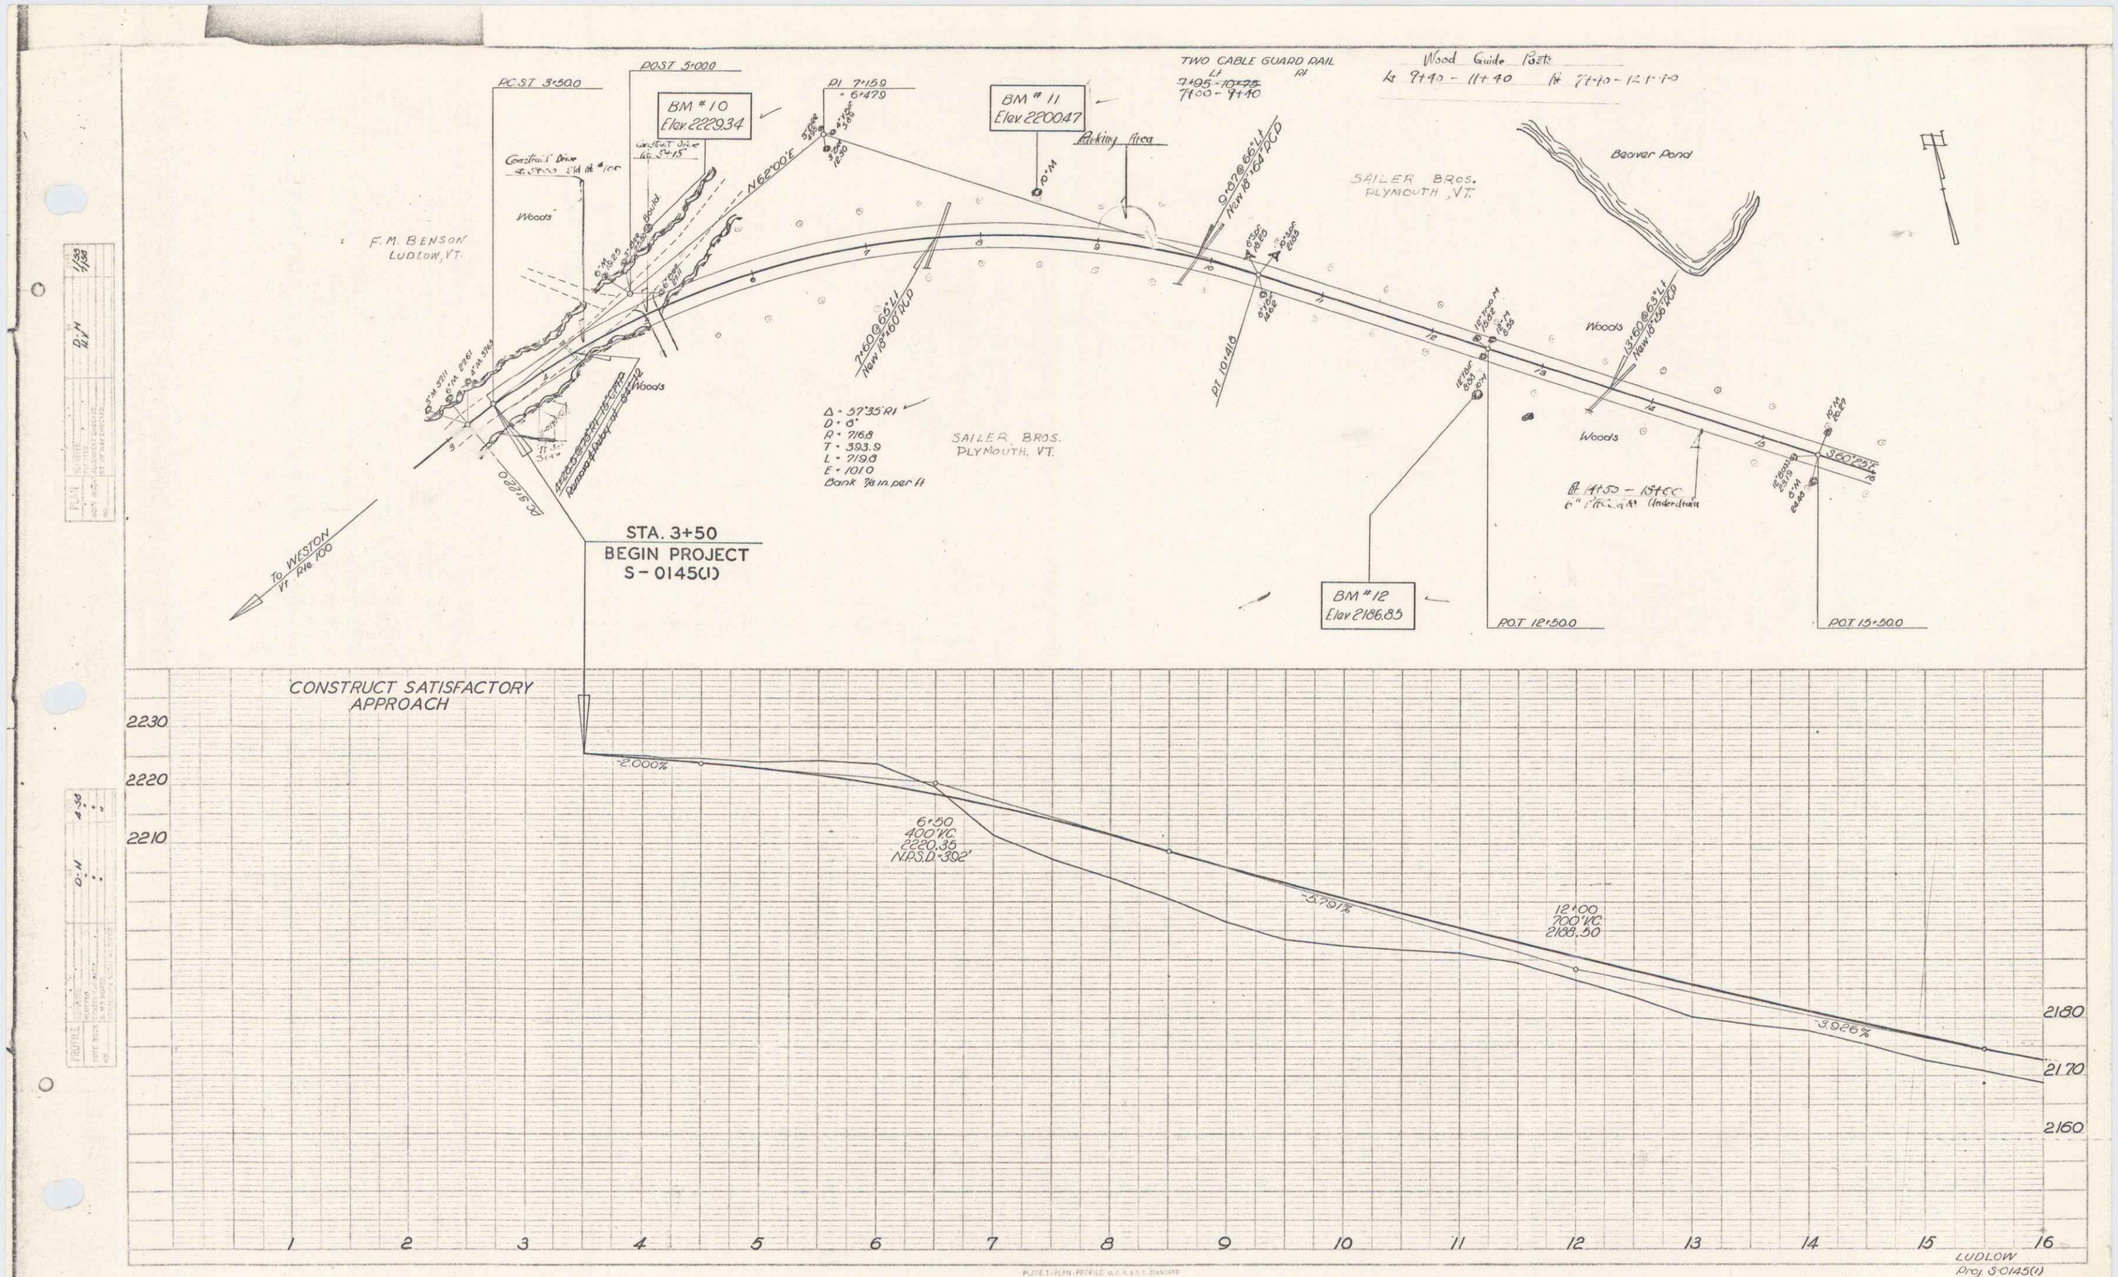

LUDLOW
Proj S-0145(1)
Sheet 15 of 36

15A

4