

PLAN  
 DATE: 2/28/60  
 DRAWN BY: D.H.  
 CHECKED BY: [Signature]

PROFILE  
 DATE: 2/28/60  
 DRAWN BY: D.H.  
 CHECKED BY: [Signature]

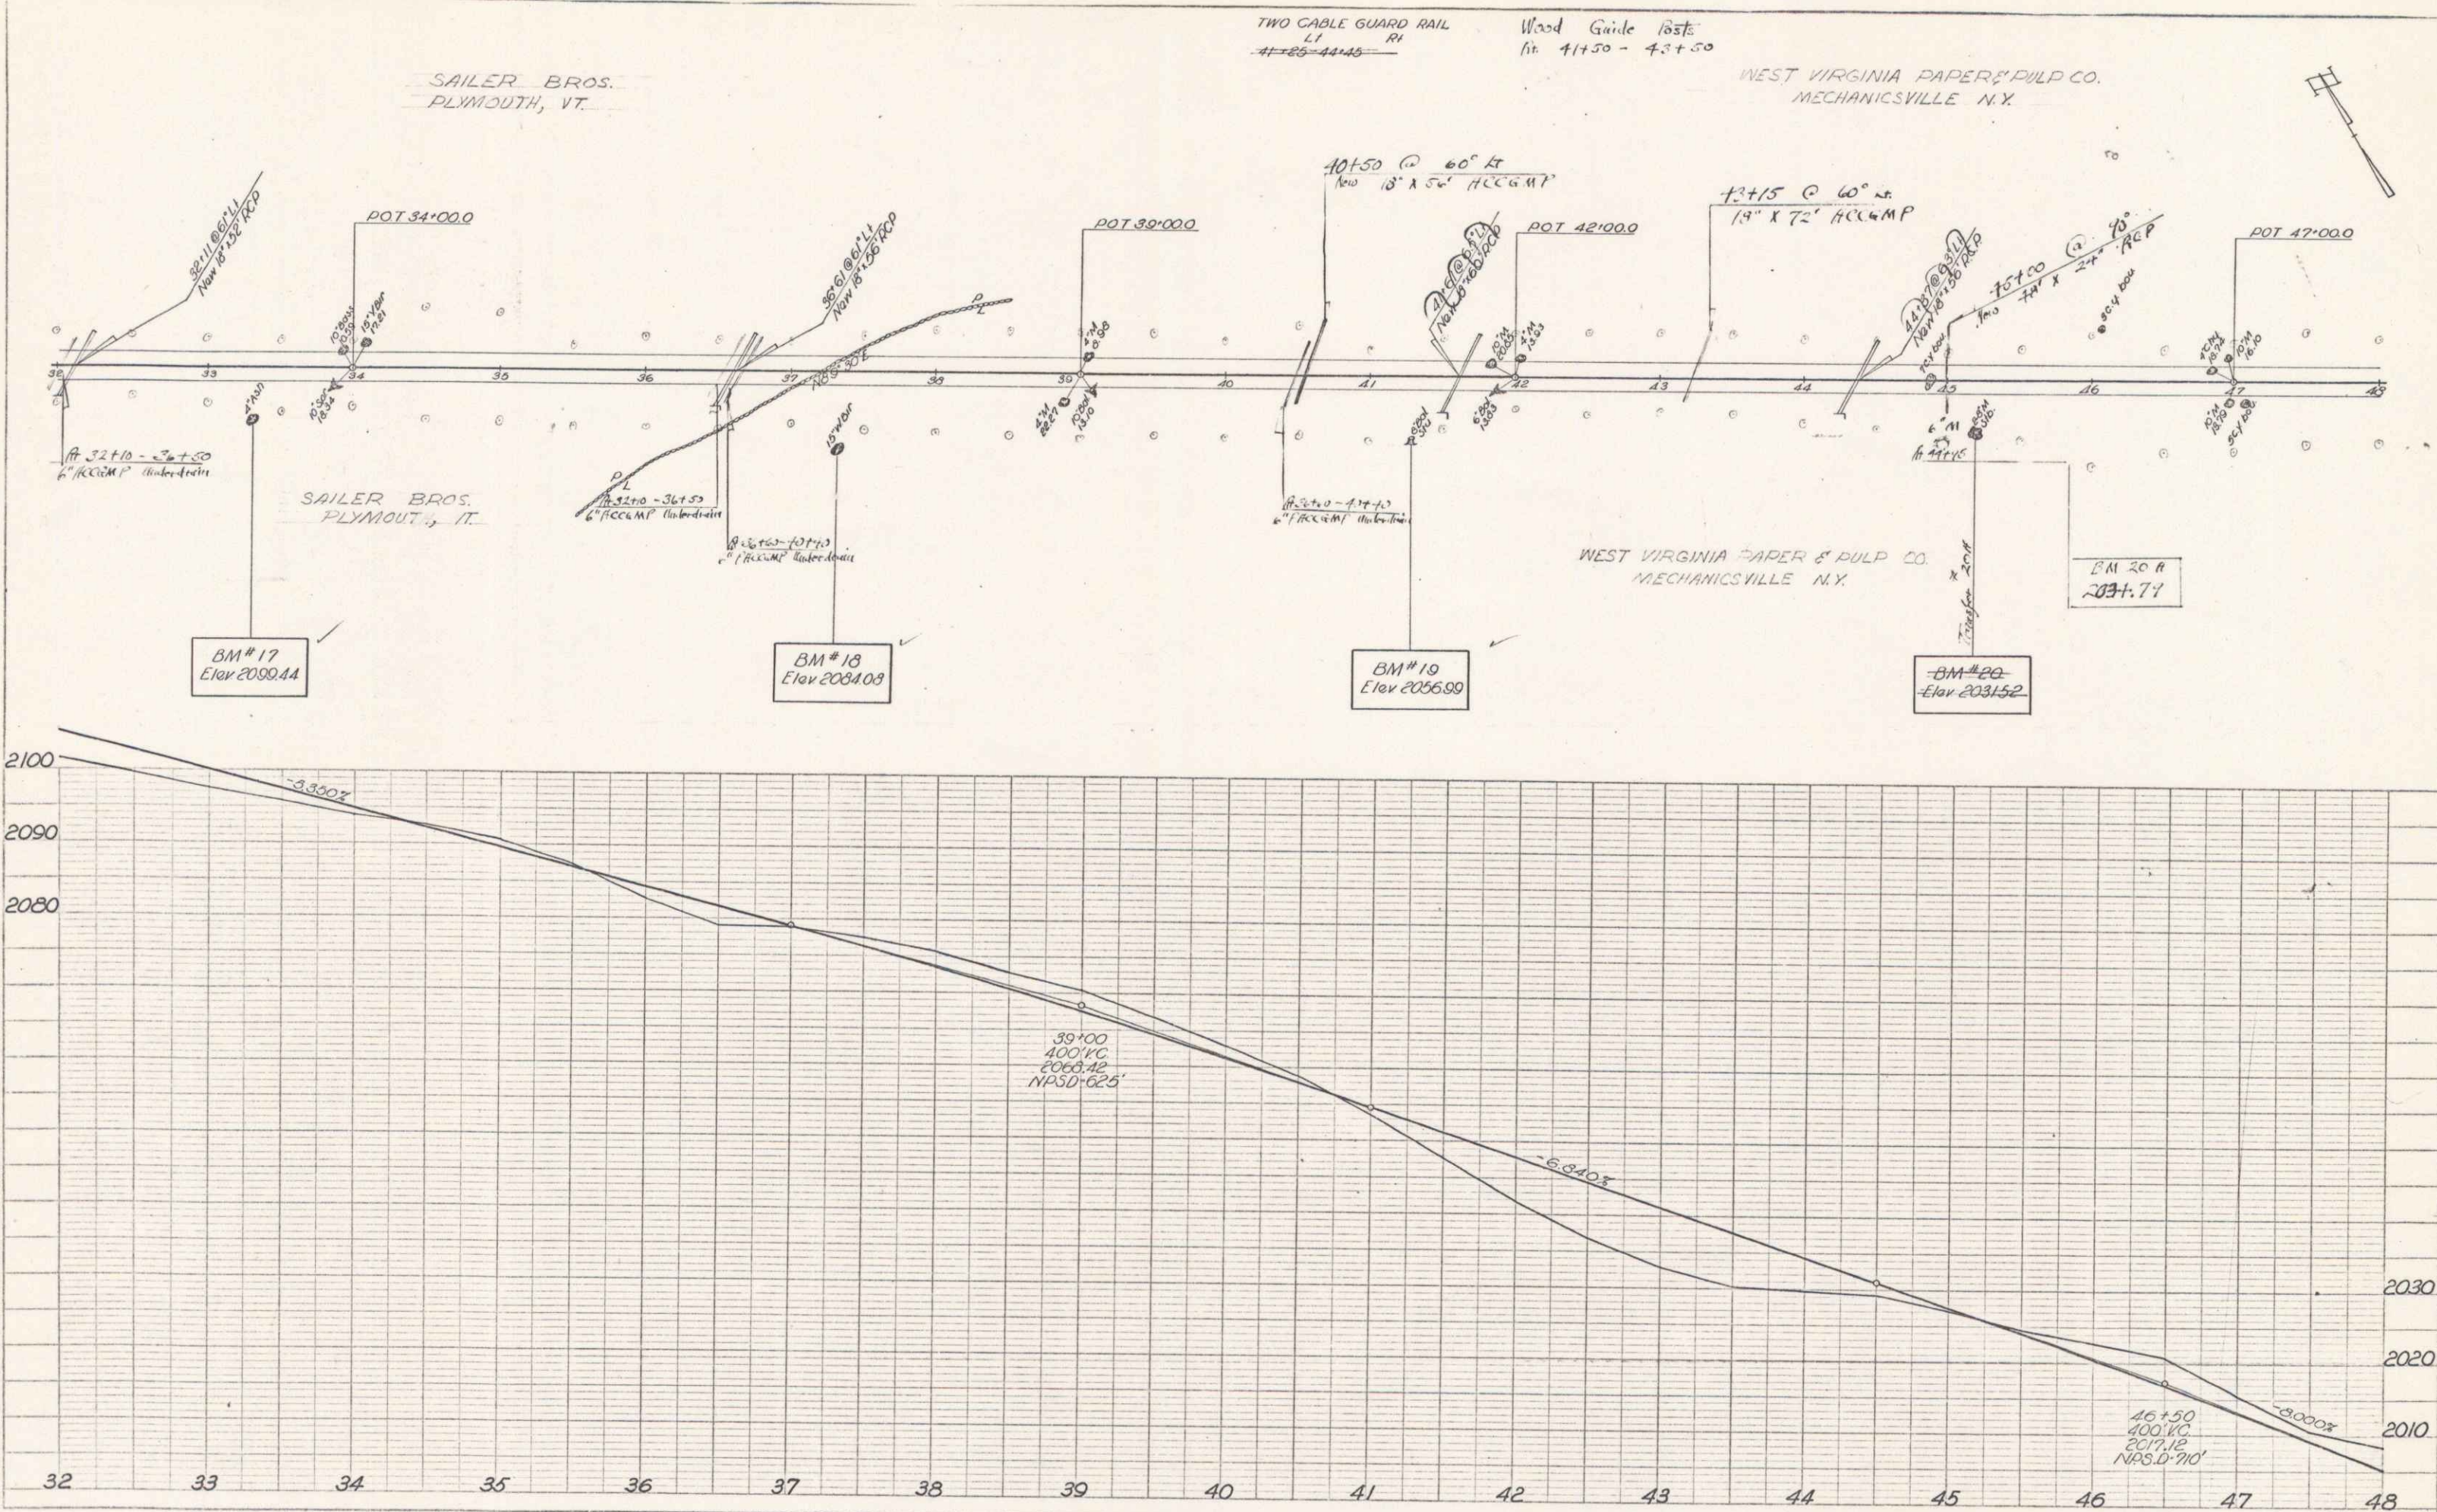



LUDLOW  
 Proj. S 0145(U)  
 Sheet/Plat 56

17A

8