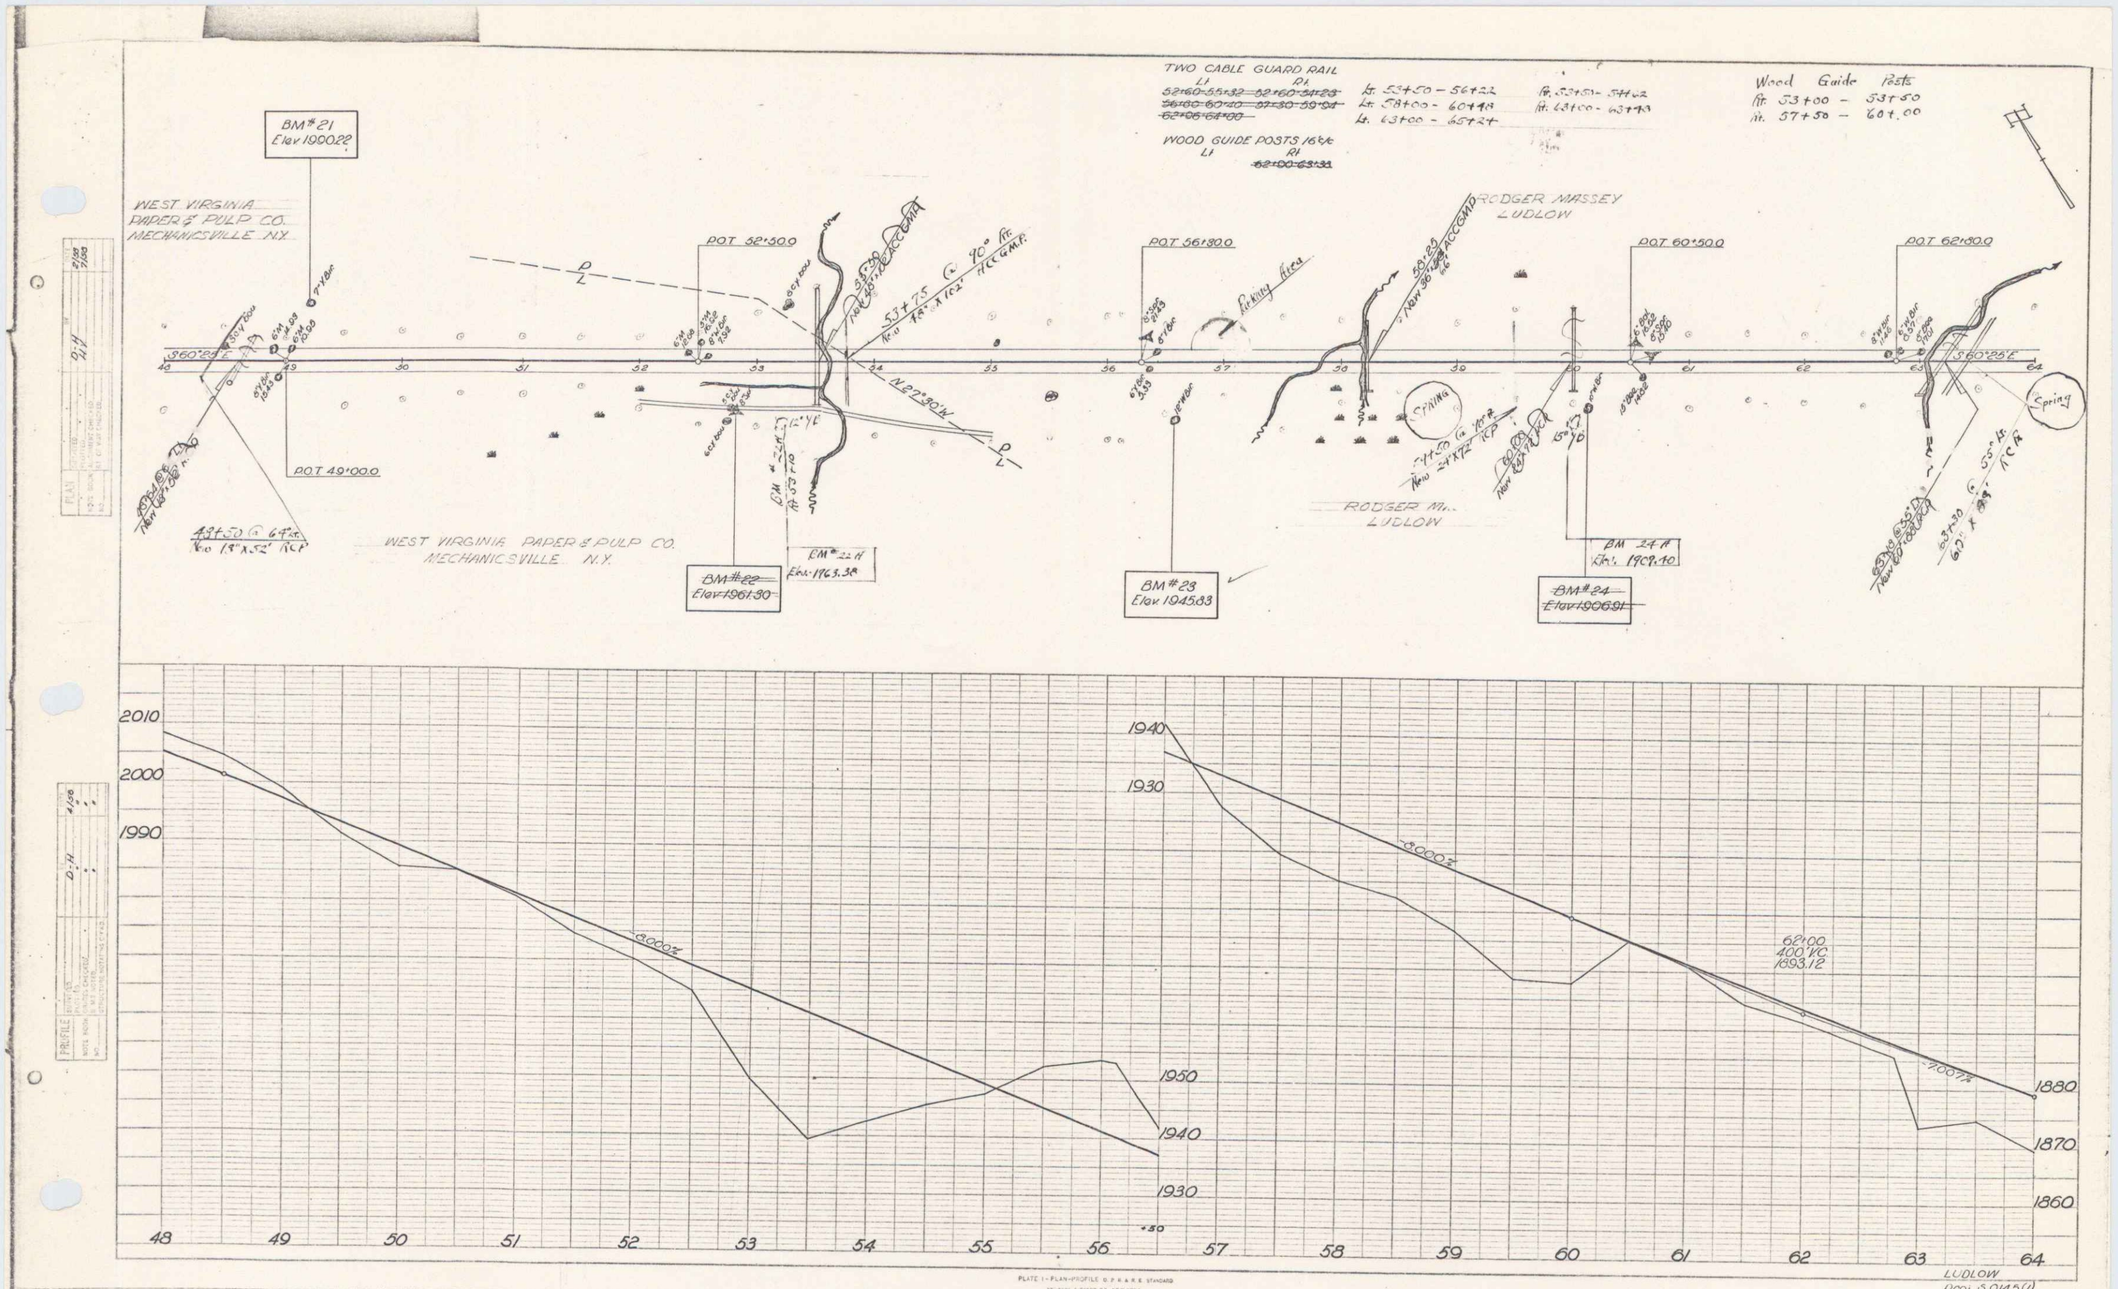

PLATE 1 - PLAN-PROFILE O. P. R. & R. E. STANDARD
NEUFFER & FISCER CO. NEW YORK
R. & E. Co. No. 248-1C

LUDLOW
Proj. S 0145(1)
Sheet 18 of 56

18A

10