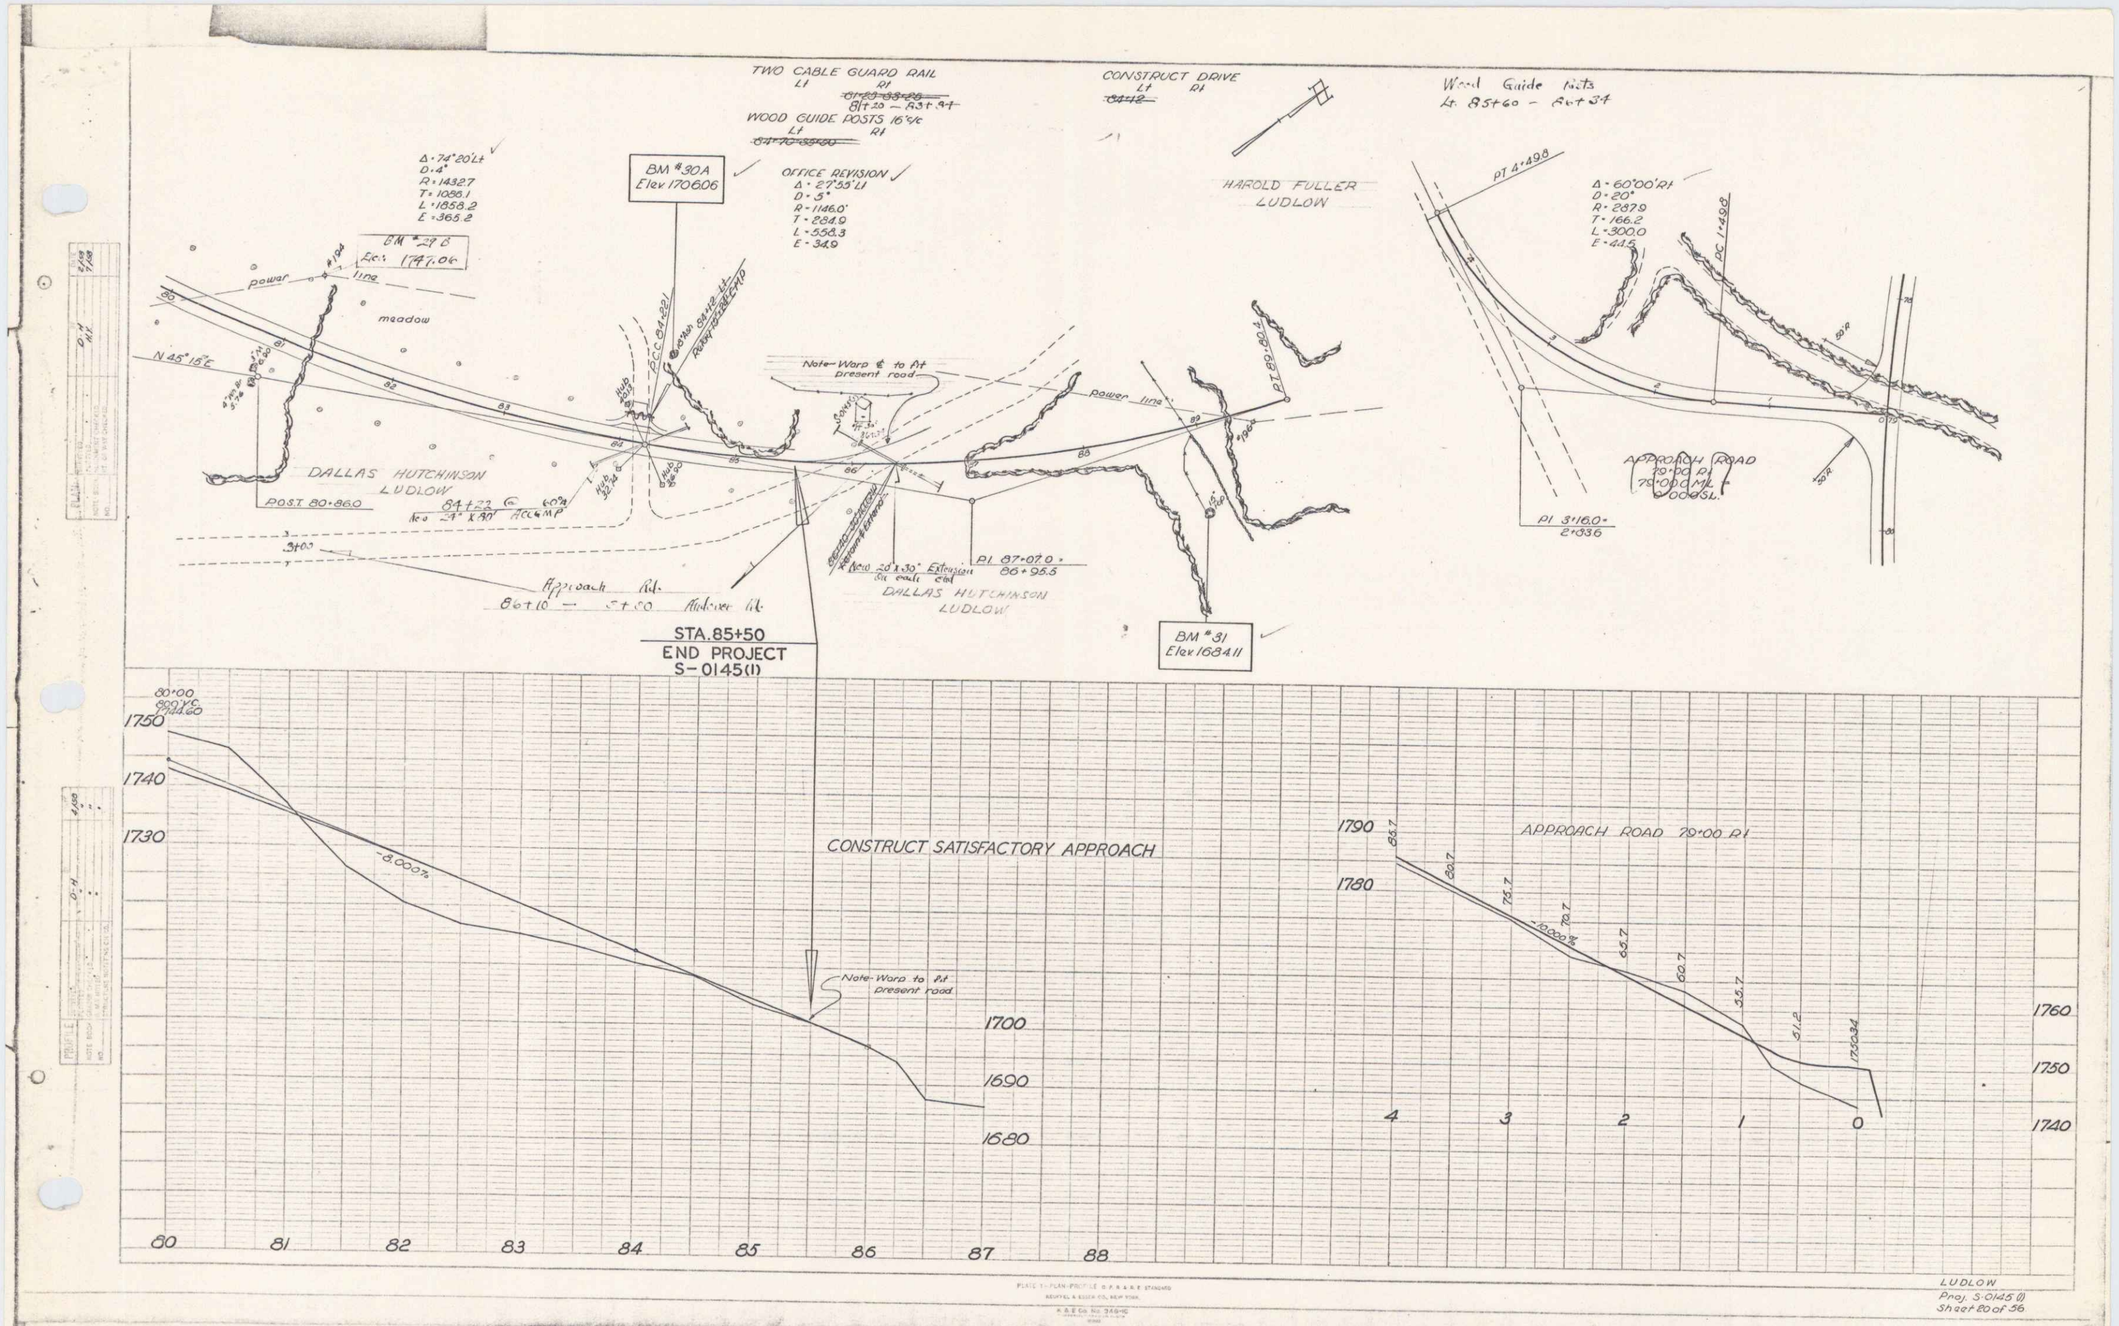

LUDLOW
Proj. S-0145(1)
Sheet 20 of 56

20A 14