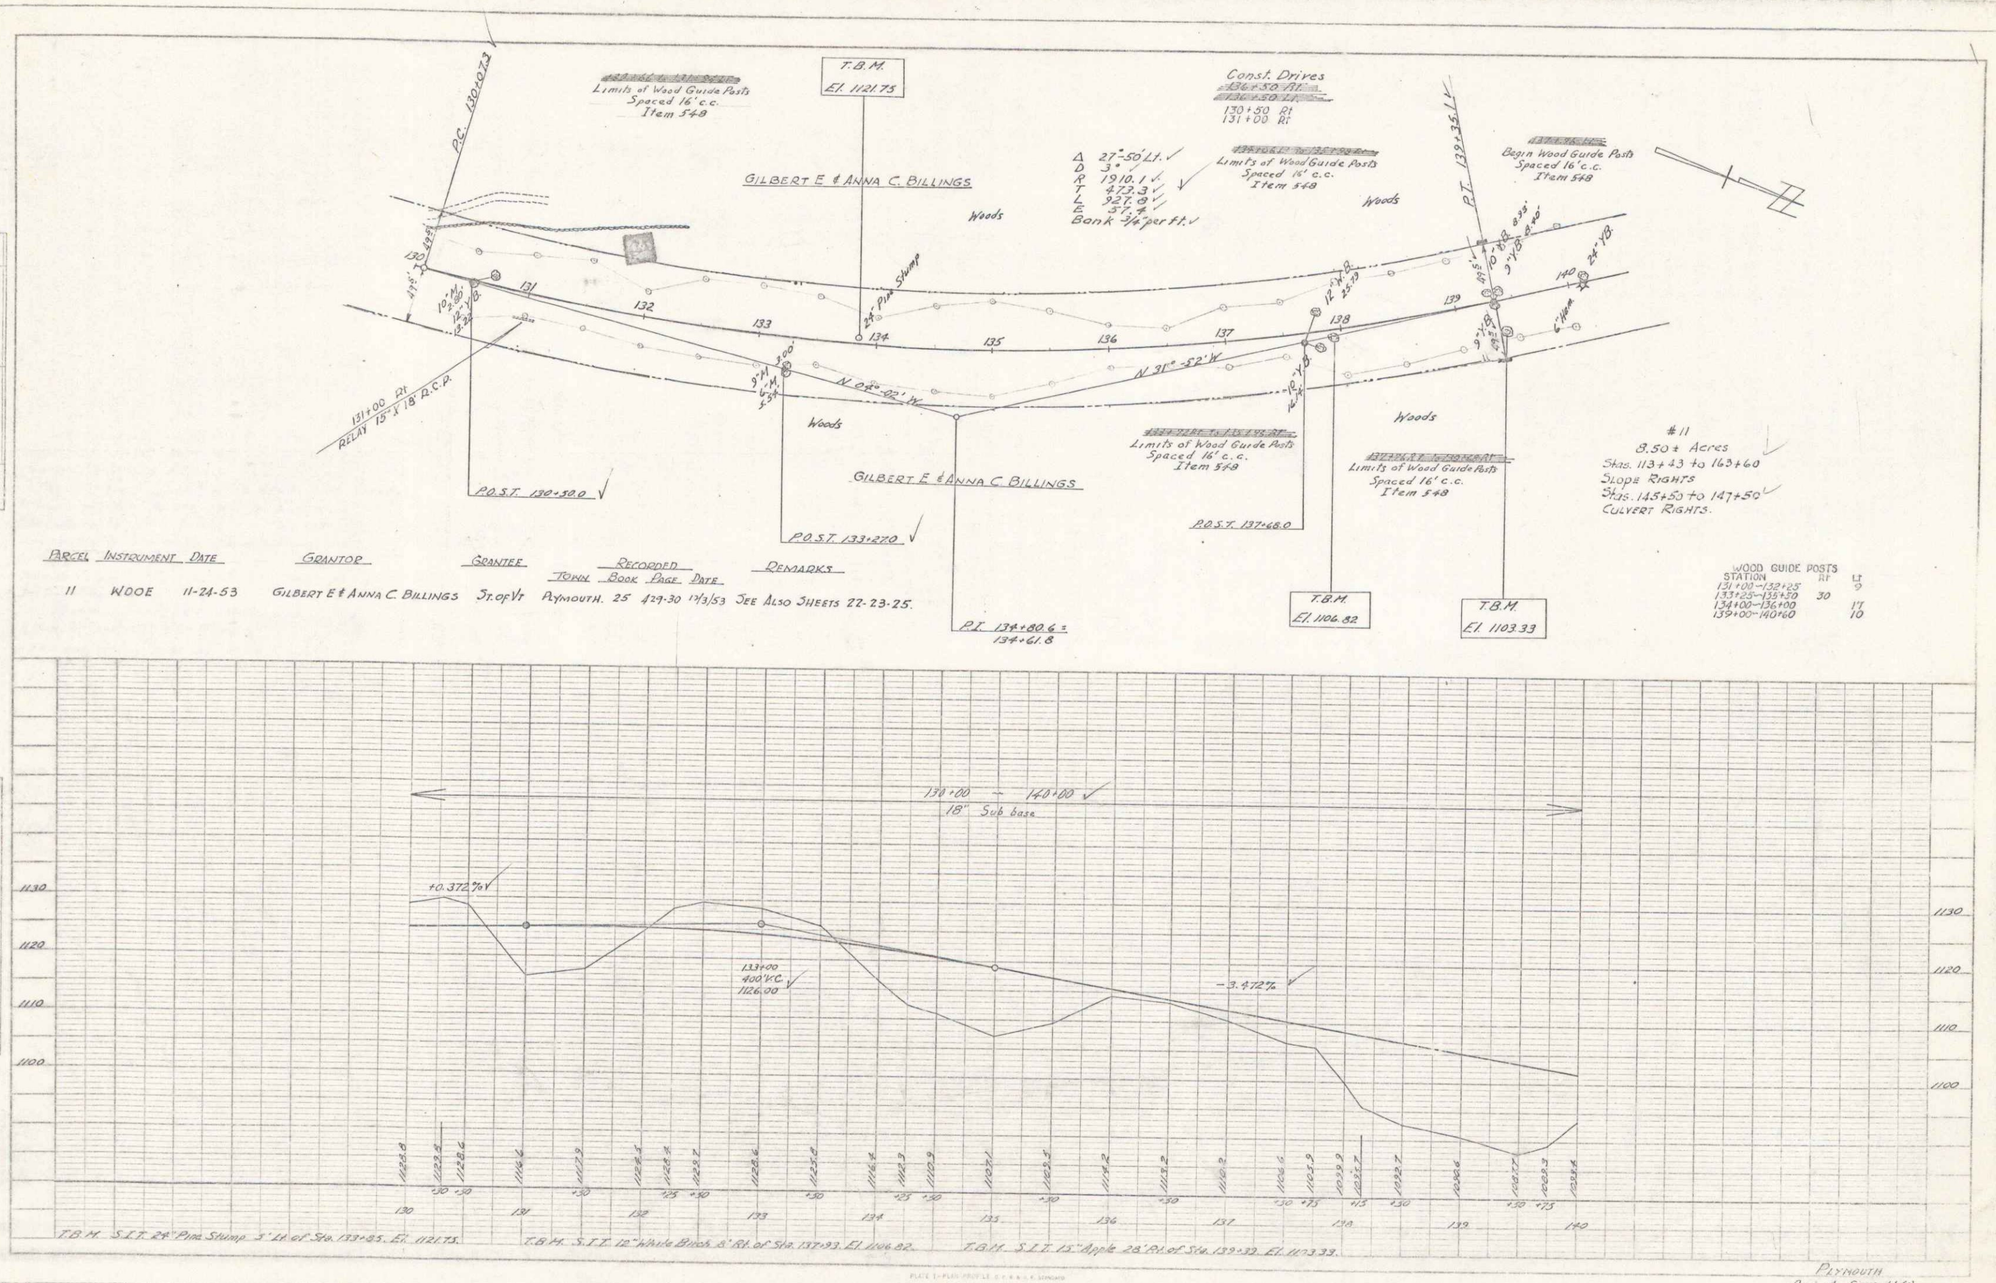

Parcel	Instrument	Date	Grantor	Grantee	Recorded Town	Book	Page	Date	Remarks
11	WOOE	11-24-53	Gilbert E & Anna C. Billings	St. of Vt	Plymouth	25	429-30	12/3/53	See Also Sheets 22-23-25.

Plymouth
Project S. No. 41(1)
Sheet 24 of 140

14