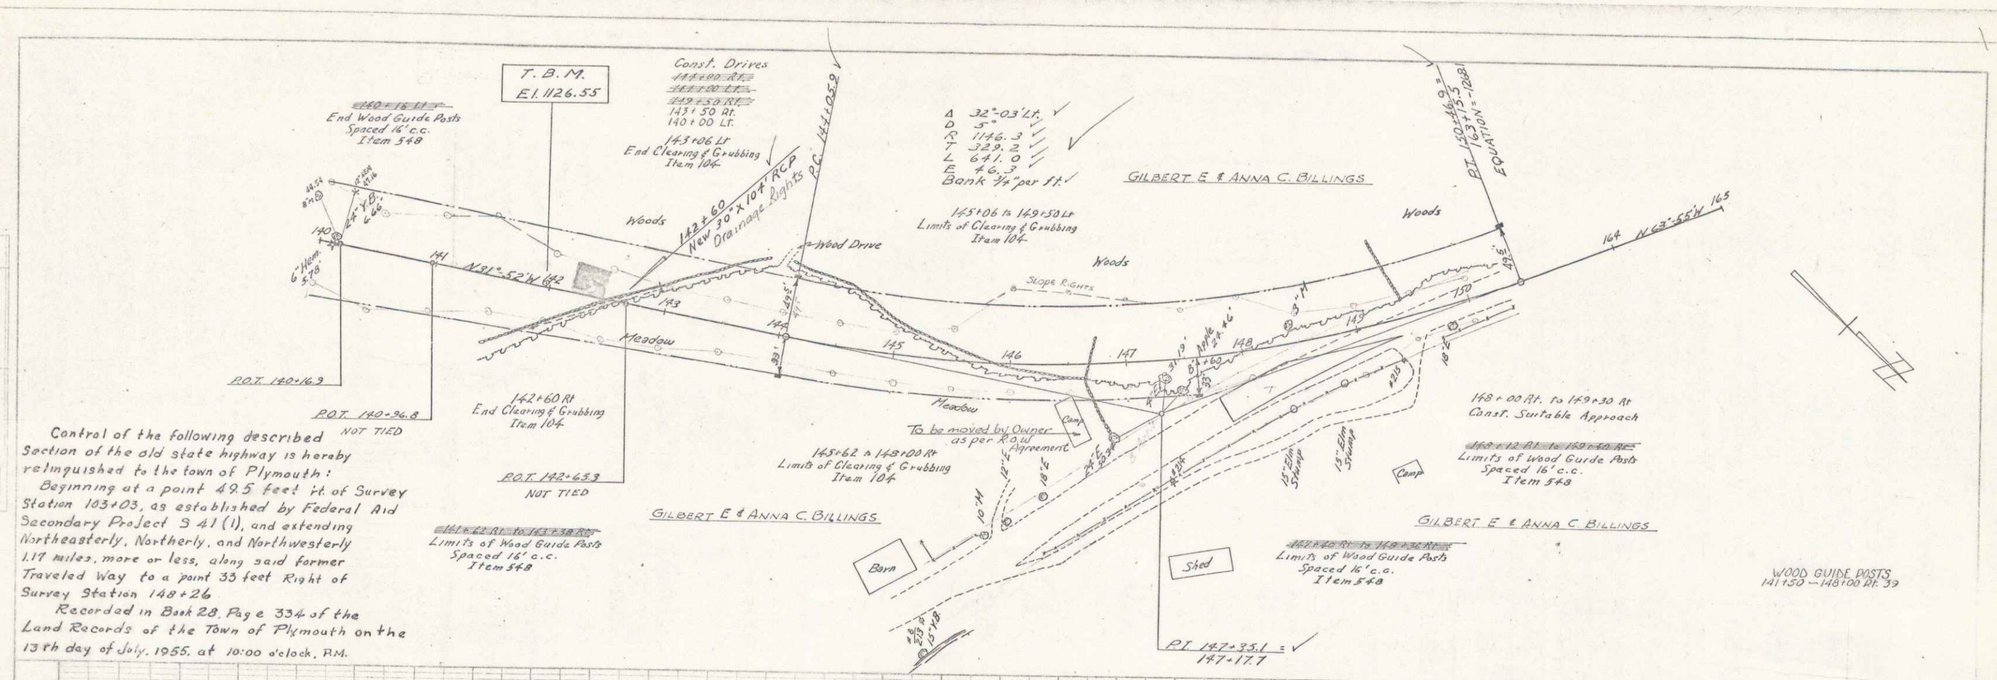

Control of the following described Section of the old state highway is hereby relinquished to the town of Plymouth:

Beginning at a point 49.5 feet rt. of Survey Station 103+03, as established by Federal Aid Secondary Project S 41 (1), and extending Northeasterly, Northerly, and Northwesterly 1.17 miles, more or less, along said former Traveled Way to a point 33 feet Right of Survey Station 148+26

Recorded in Book 28, Page 334 of the Land Records of the Town of Plymouth on the 13th day of July, 1955, at 10:00 o'clock, P.M.

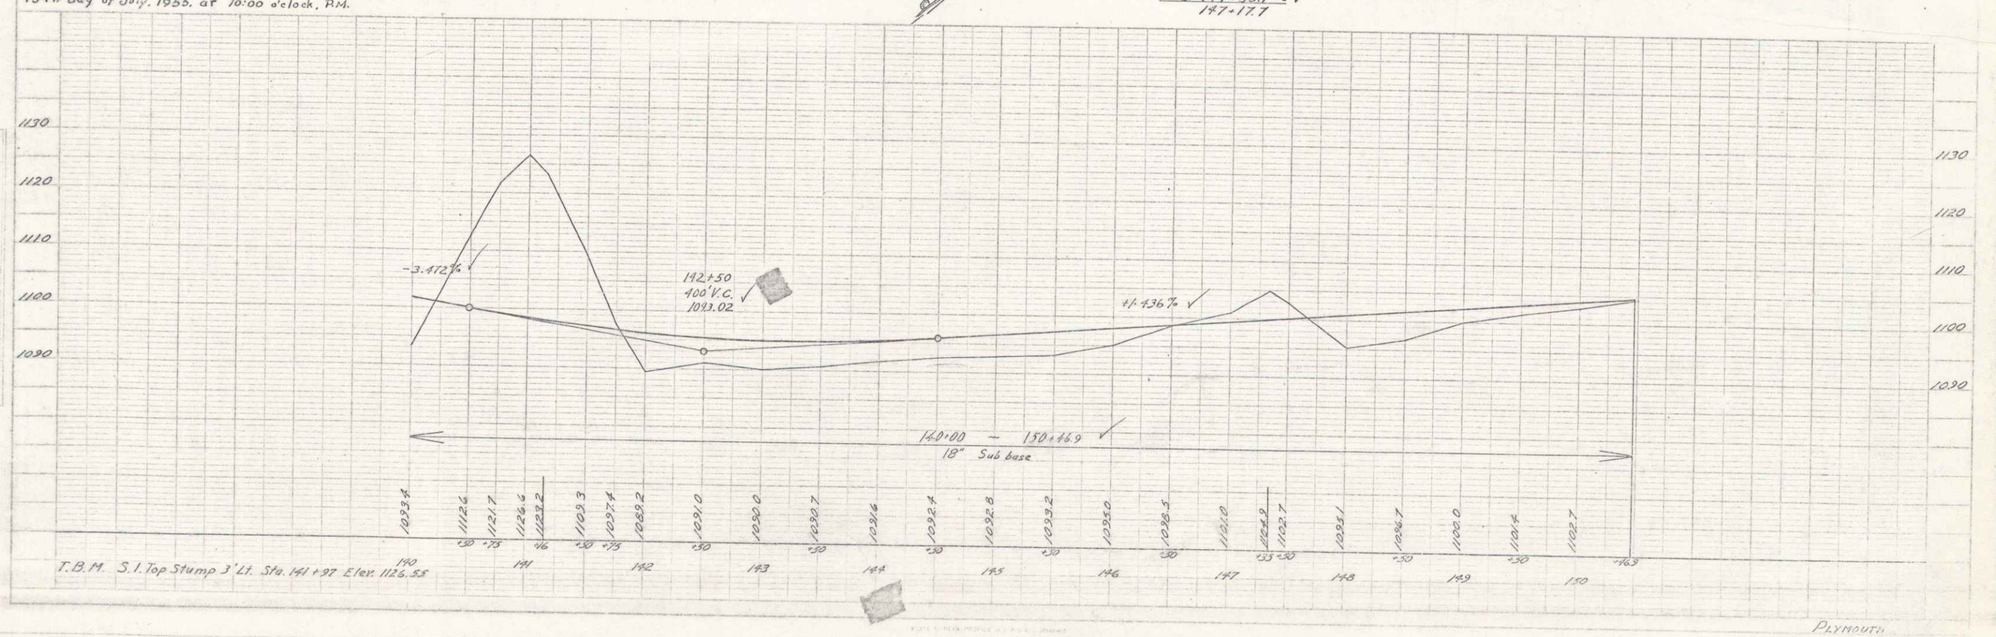

PLYMOUTH
Project S. No. 41 (1)
Sheet 25 of 140

15