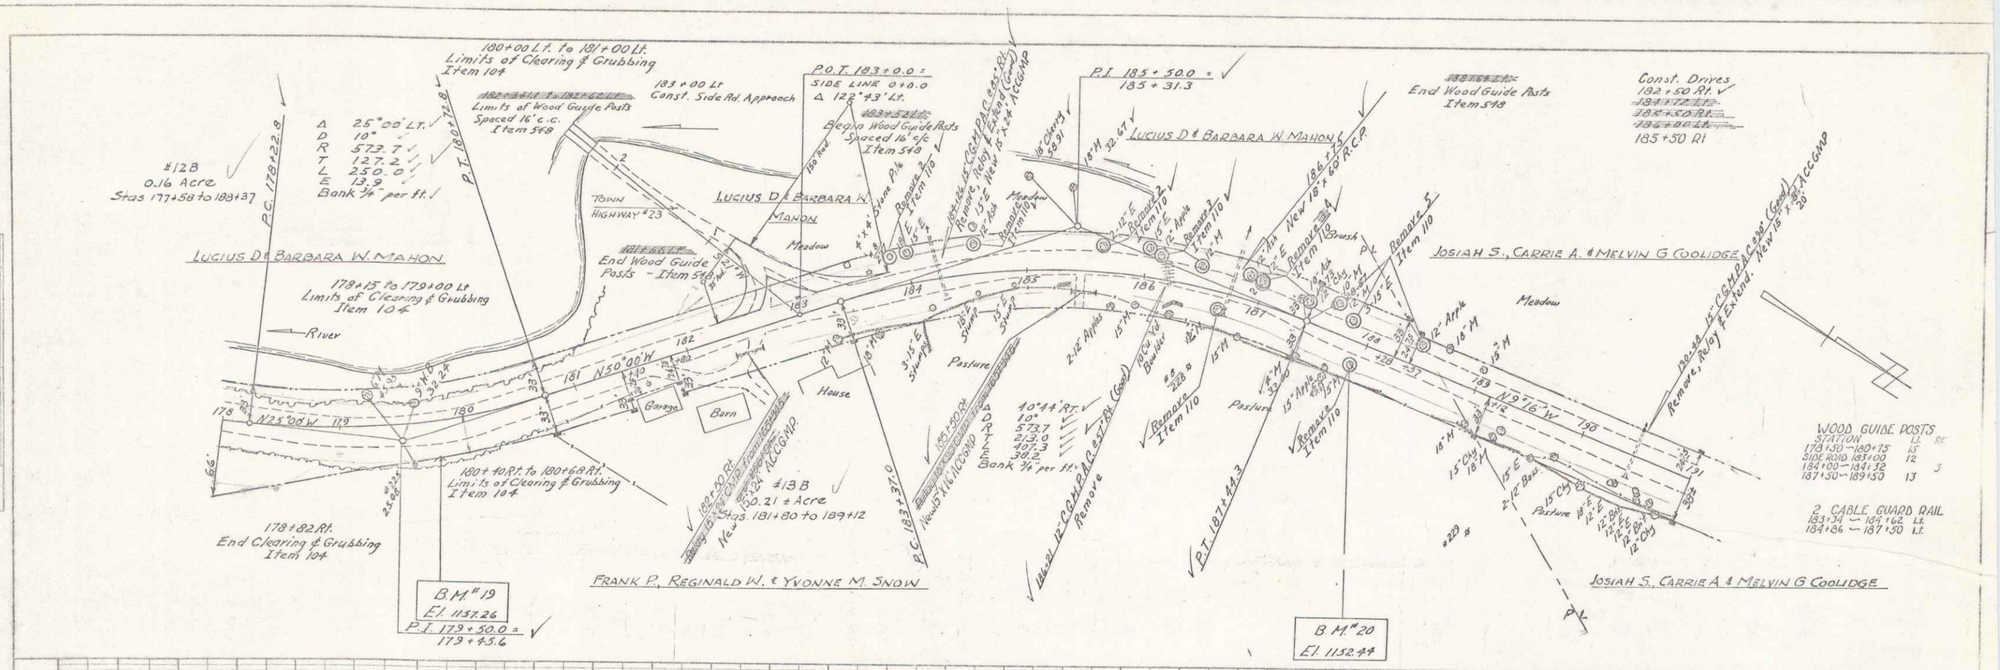

PLYMOUTH
Project S. No. 41(1)
Sheet 27 of 160

17