


| PARCEL | INSTRUMENT | DATE | GRANTOR | GRANTEE | RECORDED TOWN BOOK | RECORDED PAGE | RECORDED DATE | REMARKS |
|---|---|---|---|---|---|---|---|---|
| 14 A-B-C-D | WDDE | 12-5-53 | JOSIAH S.; CARRIE A.; & MELVIN G. COOLIDGE | Jr. of Vt | PLYMOUTH | 25 | 443-4-5 | 12/23/53 SEE ALSO SHEETS 27 & 29. |

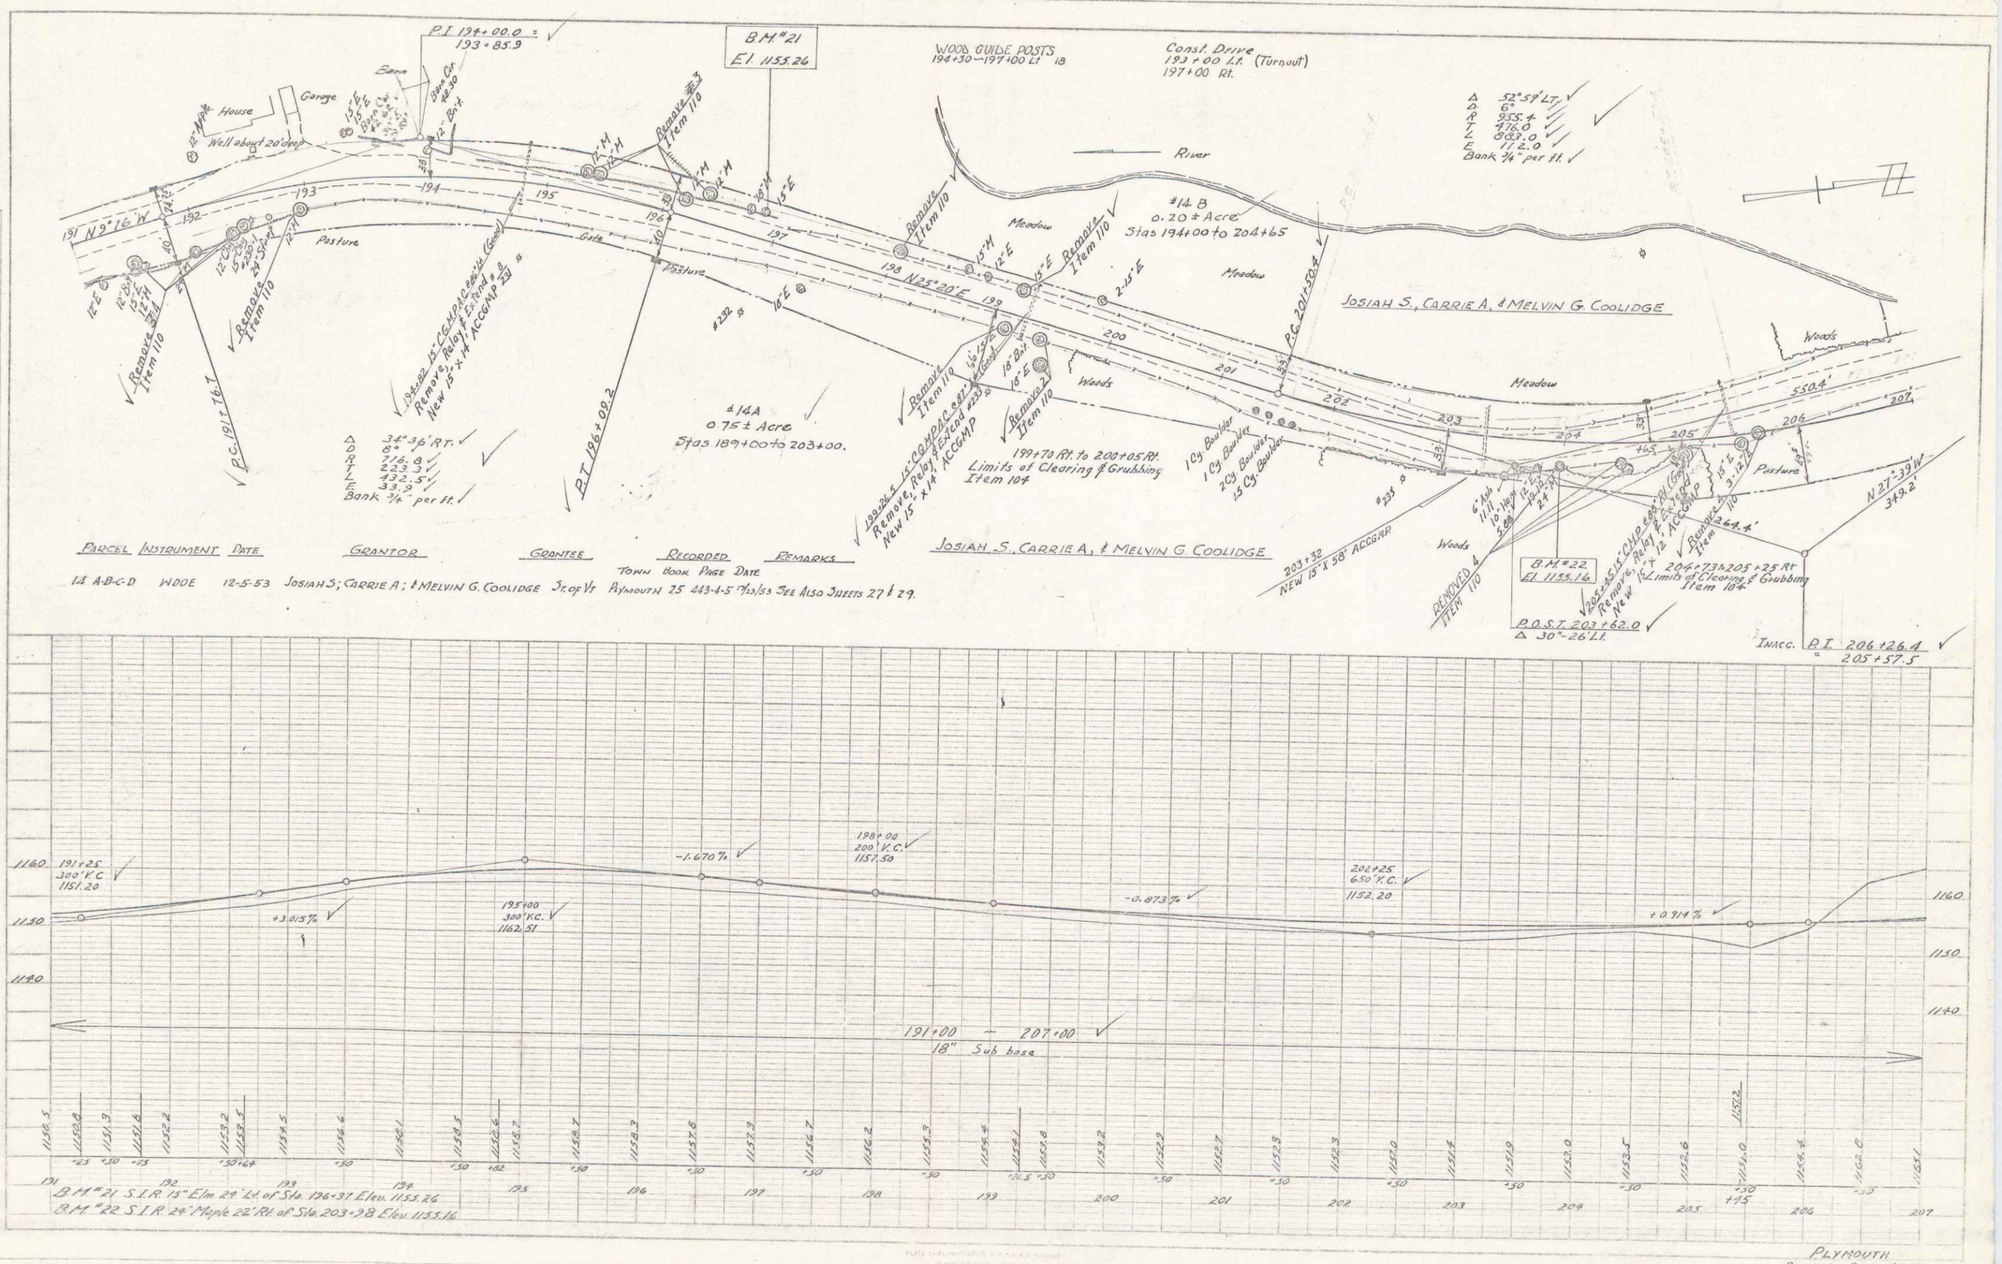


PLYMOUTH
Project S. NH 41 (1)
Sheet 28 of 146

18