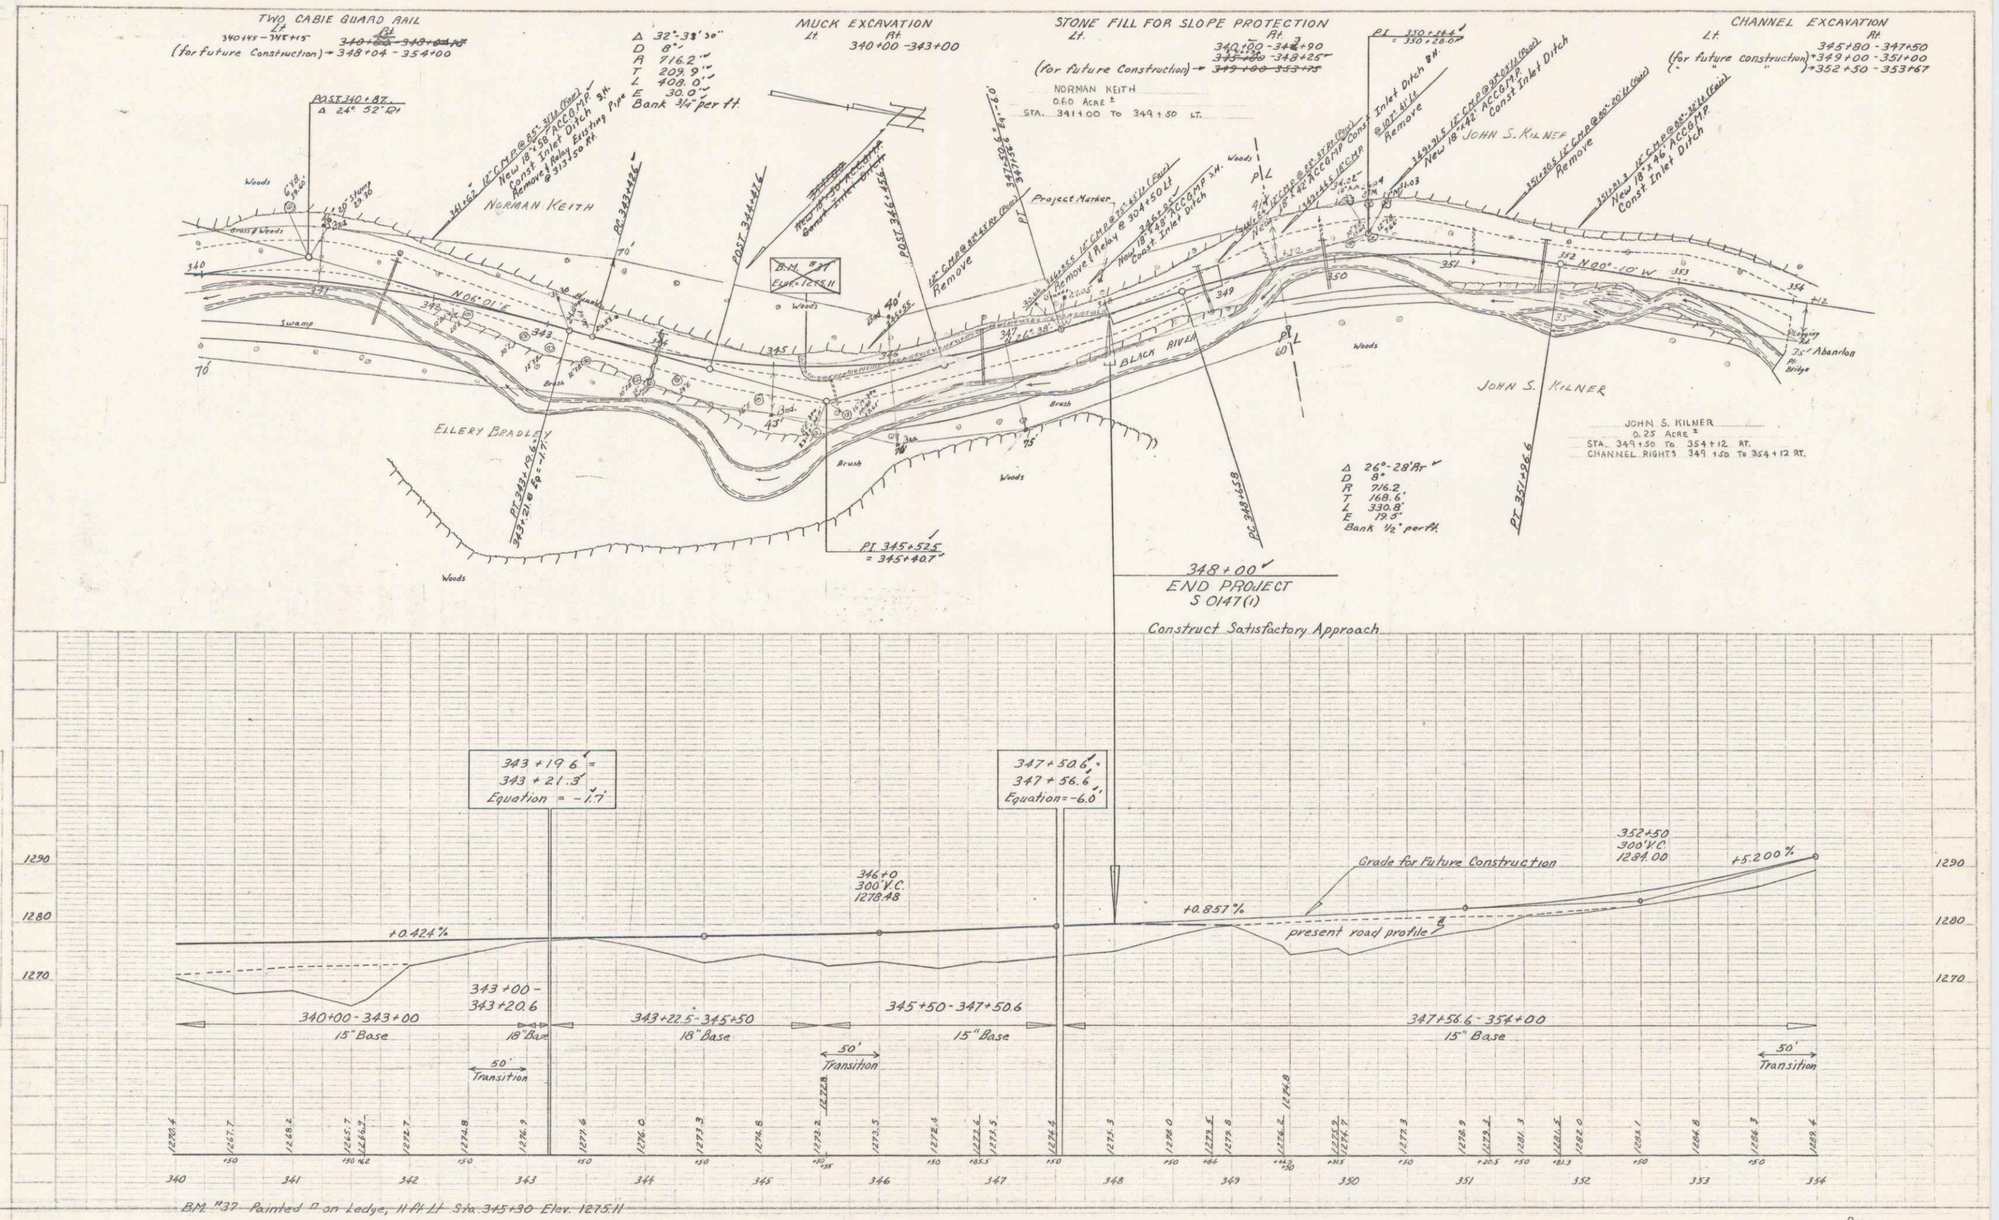

BM #37 Painted □ on Ledge, 11 Ft Lt Sta. 345+30 Elev. 1275.11

PLYMOUTH
Project S № 0147(1) SA
Sheet 11 of 48 Sheets