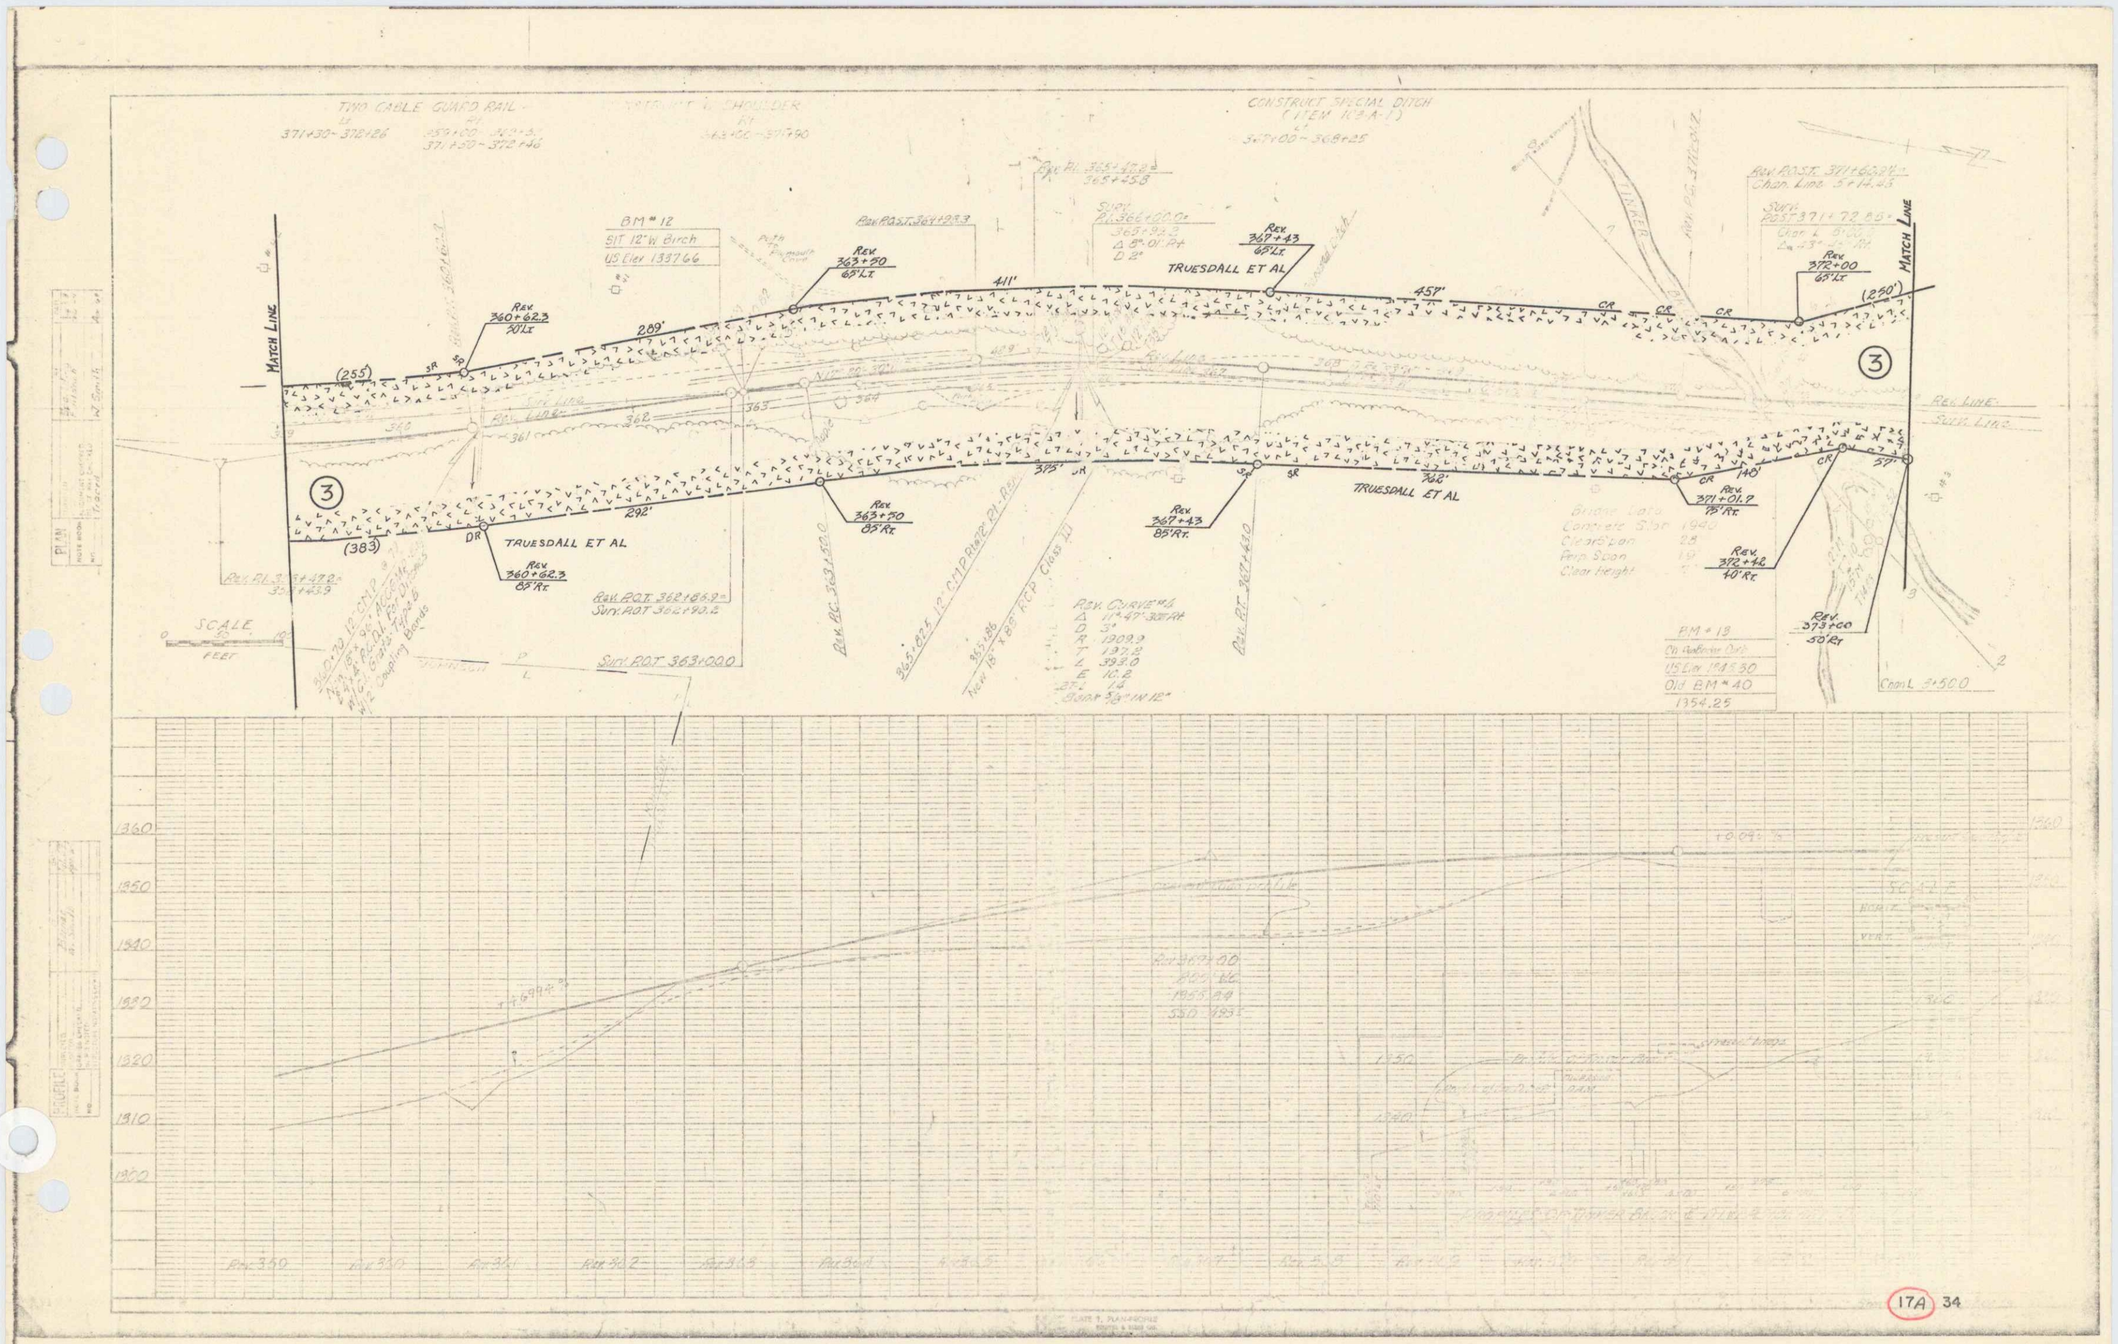
TWO CABLE GUARD RAIL
CONSTRUCT SPECIAL DITCH
BM # 12
SIT 12" W. Birch
US Elev 1337.66
MATCH LINE
TRUESDALL ET AL
SCALE
FEET
BM # 13
Old BM # 40
1354.25
17A 34