


PLAN  
 DRAWN BY  
 W. Smith  
 DATE  
 Apr 64

FILE  
 DRAWN BY  
 W. Smith  
 DATE  
 Apr 64

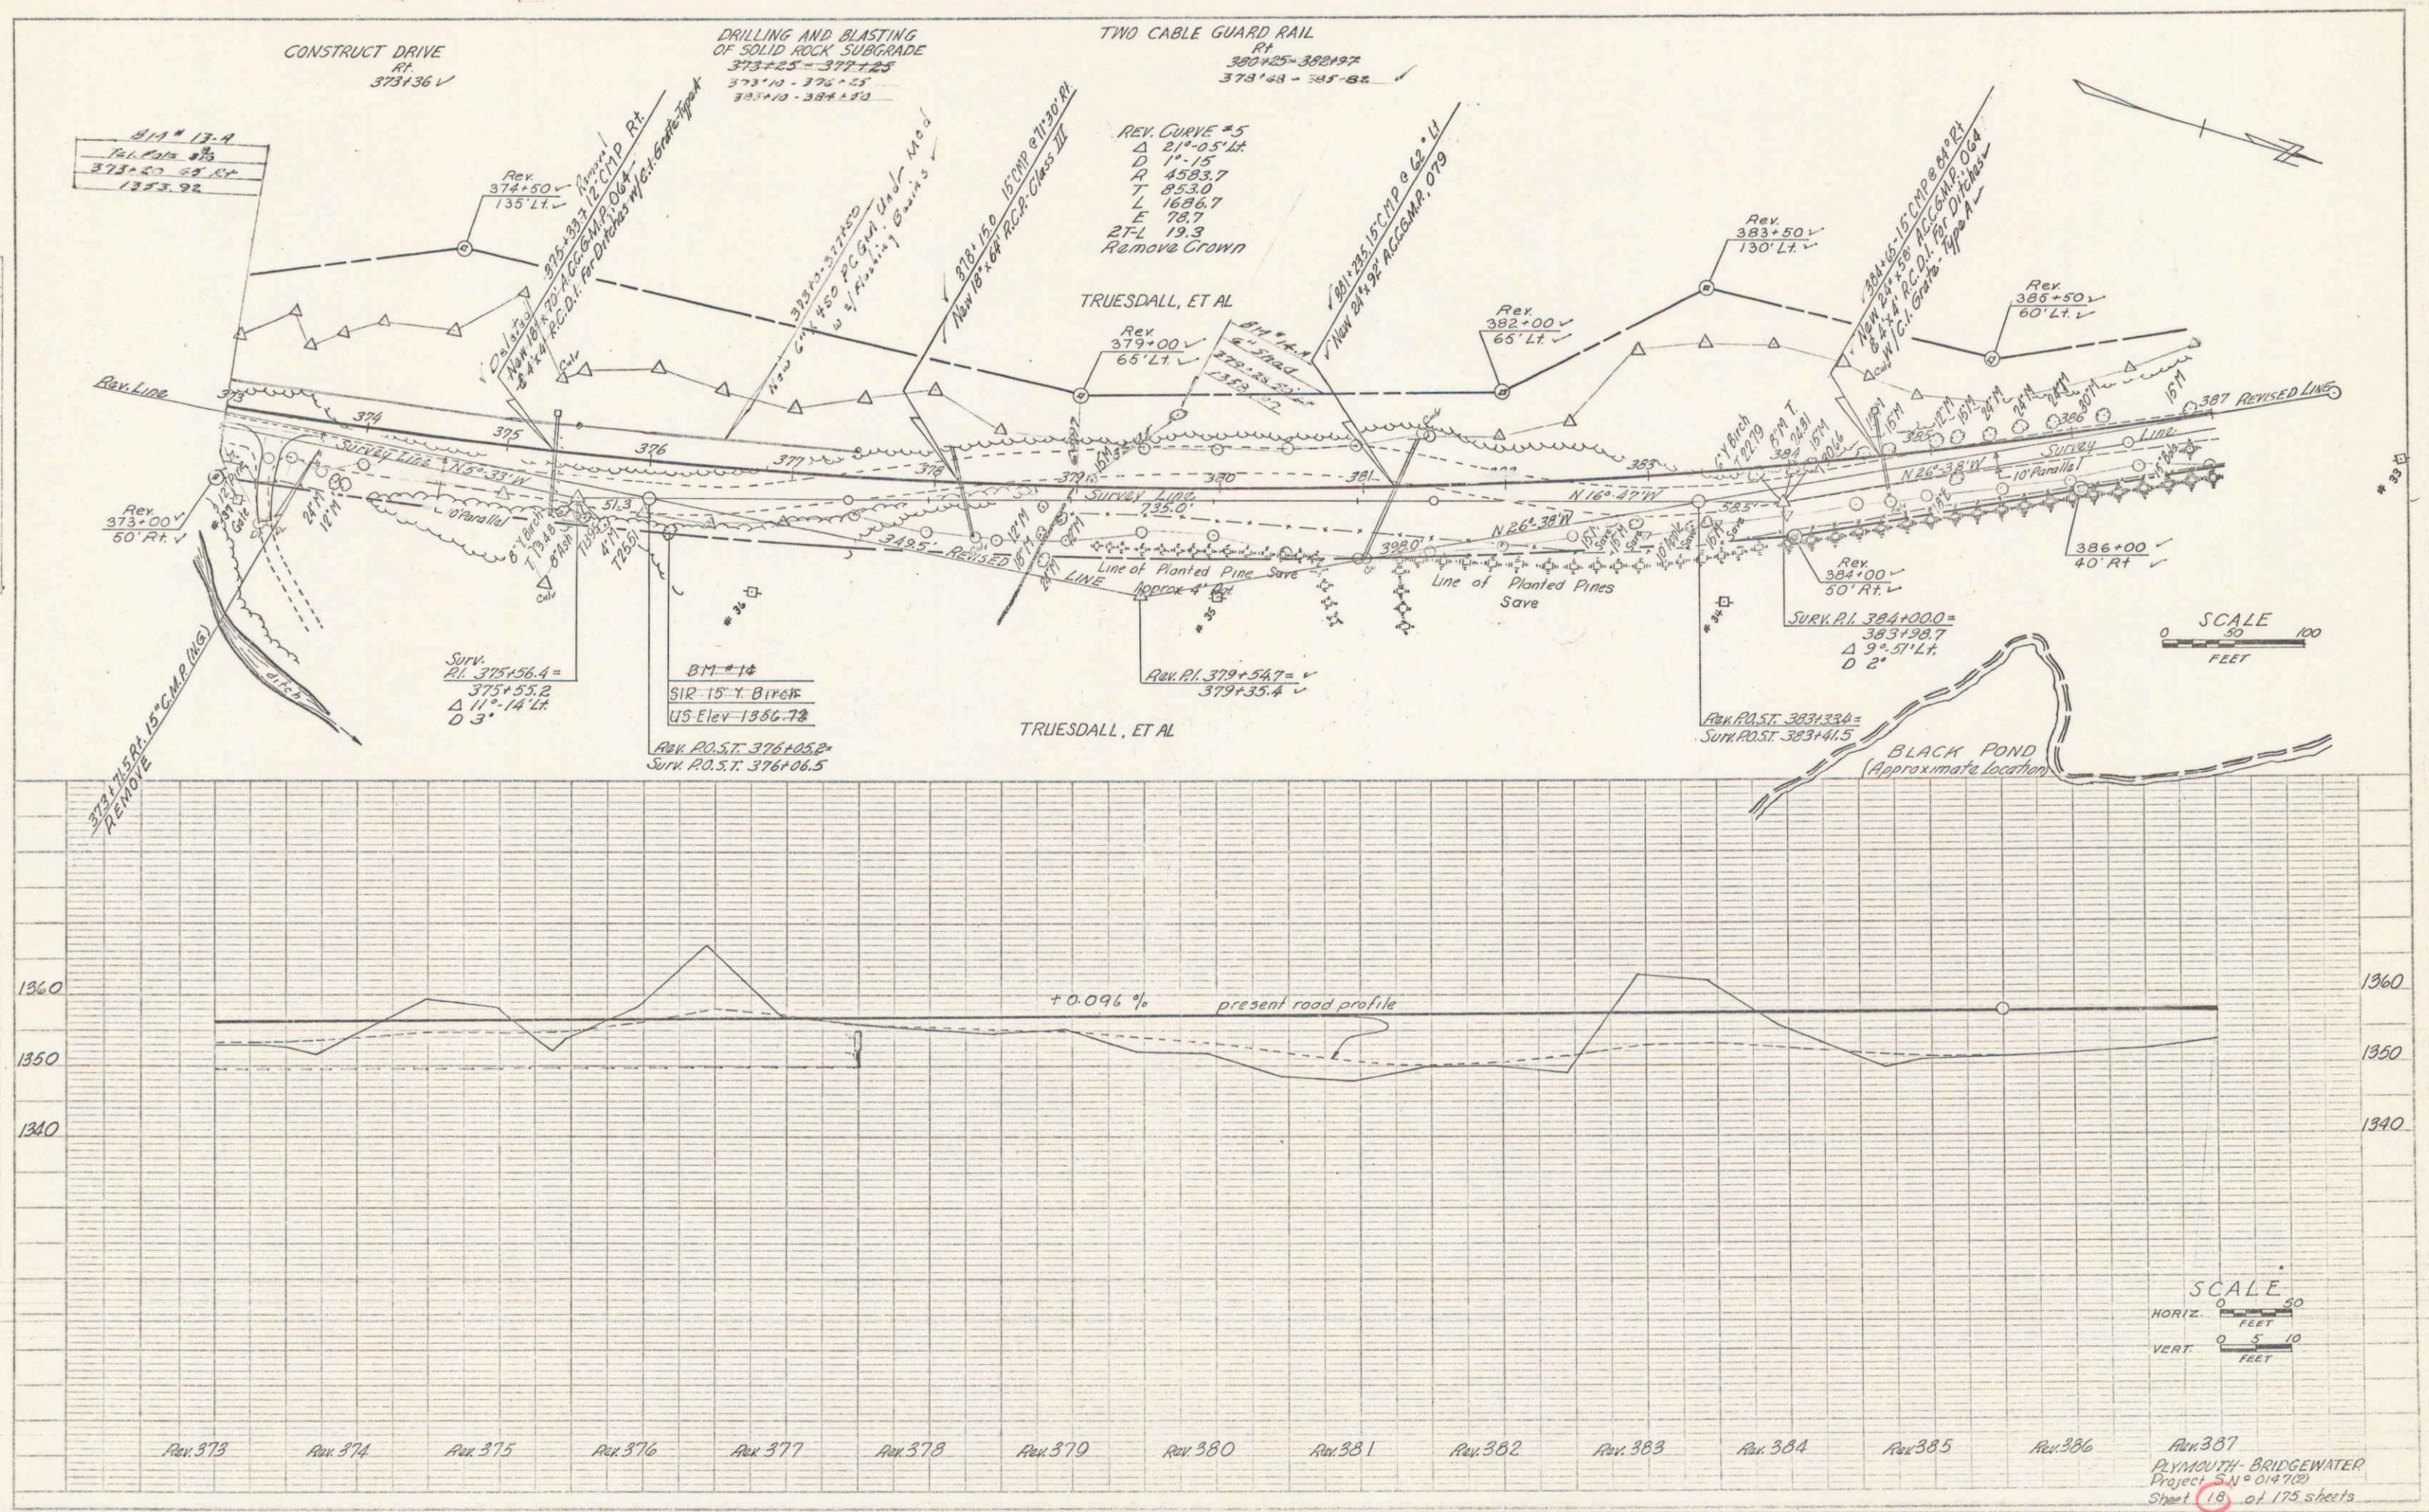

SCALE  
 1" = 50'  
 FEET

SCALE  
 HORIZ. 1" = 50' FEET  
 VERT. 1" = 5' FEET

Rev. 387  
 PLYMOUTH BRIDGEWATER  
 Project 5-N-014700  
 Sheet 18 of 175 sheets