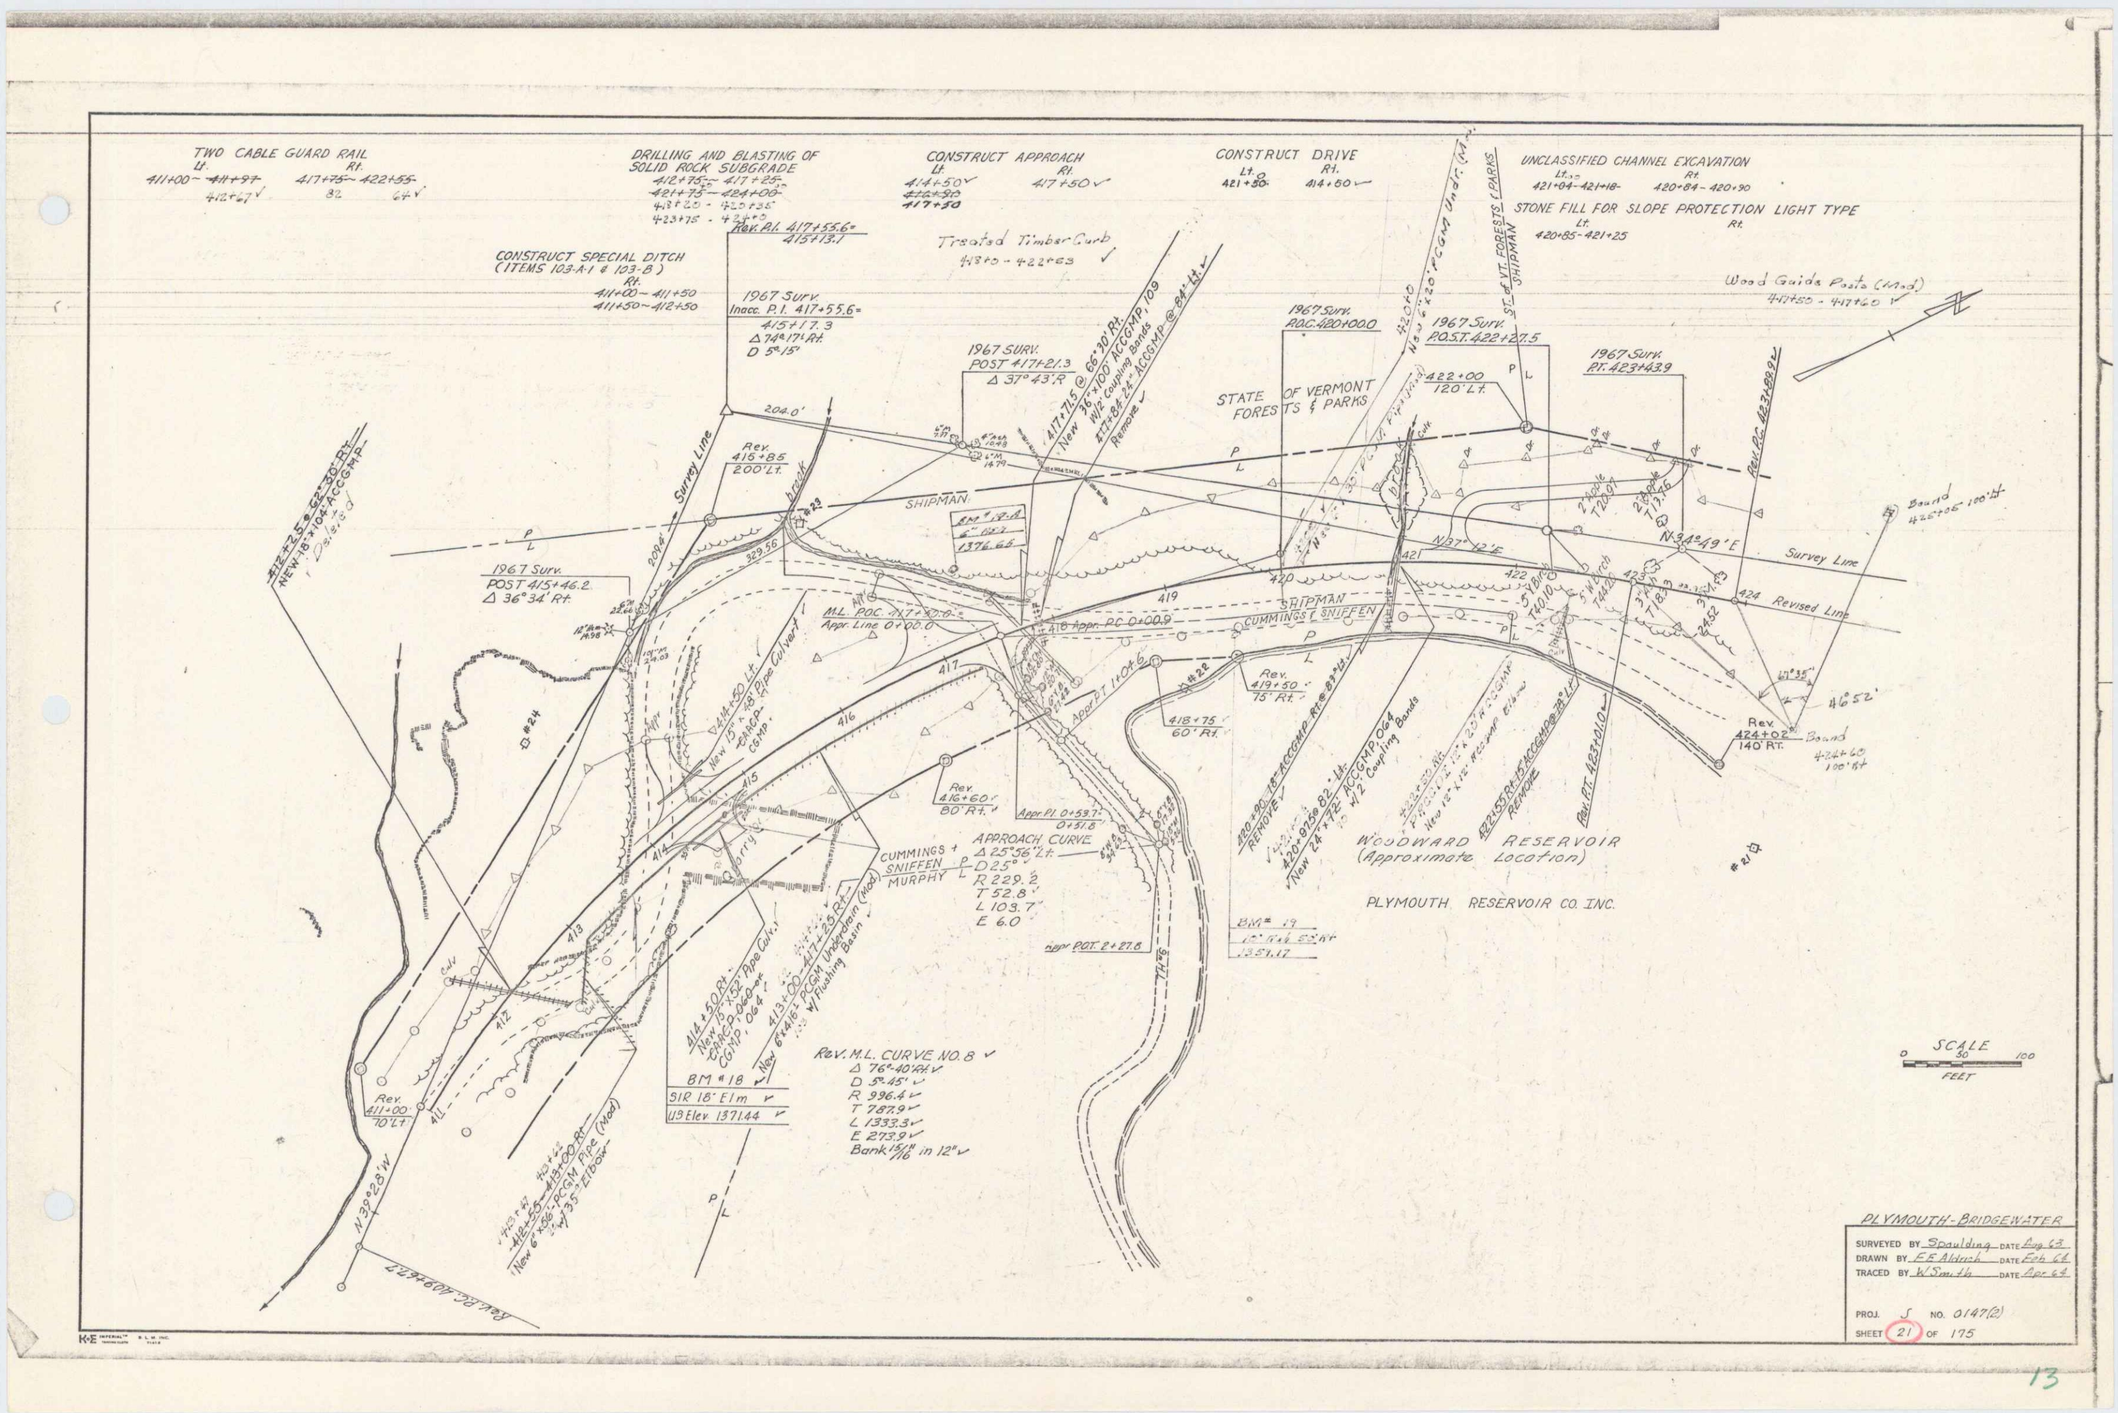
TWO CABLE GUARD RAIL
Lt. 411+00 - 411+97
Rt. 417+75 - 422+55
DRILLING AND BLASTING OF SOLID ROCK SUBGRADE
CONSTRUCT APPROACH
CONSTRUCT DRIVE
UNCLASSIFIED CHANNEL EXCAVATION
STONE FILL FOR SLOPE PROTECTION LIGHT TYPE
Treated Timber Curb
CONSTRUCT SPECIAL DITCH (ITEMS 103-A-1 & 103-B)
Wood Guide Posts (Mod)
1967 Surv. Inacc. P.I. 417+55.6
1967 SURV. POST 417+21.3
1967 Surv. ROC 420+00.0
1967 Surv. P.O.S.T. 422+27.5
1967 Surv. PT. 423+43.9
STATE OF VERMONT FORESTS & PARKS
ST. OF VT. FORESTS & PARKS
SHIPMAN
Survey Line
Revised Line
1967 Surv. POST 415+46.2
Rev. 416+85 200' Lt.
Rev. 411+00 70' Lt.
Rev. 419+50 15' Rt.
Rev. 416+60 80' Rt.
Rev. 418+75 60' Rt.
Rev. 424+02 140' Rt.
CUMMINGS & SNIFFEN
CUMMINGS & SNIFFEN MURPHY
APPROACH CURVE
Δ 25°56' Lt.
D 25°
R 229.2
T 52.8
L 103.7
E 6.0
WOODWARD RESERVOIR (Approximate Location)
PLYMOUTH RESERVOIR CO. INC.
Rev. M.L. CURVE NO. 8
Δ 76°40' Rt.
D 5°45'
R 996.4
T 787.9
L 1333.3
E 273.9
Bank 15/16" in 12"
BM #18
SIR 18" Elm
U.S. Elev. 1371.44
SCALE
0 50 100
FEET
PLYMOUTH-BRIDGEWATER
SURVEYED BY Spaulding DATE Aug 63
DRAWN BY E.E. Aldrich DATE Feb 64
TRACED BY W.Smith DATE Apr 64
PROJ. S NO. 0147(2)
SHEET 21 OF 175

13