

TWO CABLE GUARD RAIL
 LI RT
 411+00 - 411+97 417+75 - 422+55

DRILLING AND BLASTING OF
 SOLID ROCK SUBGRADE
 LI RT
 412+75 - 417+25 414+50 417+50
 421+75 - 424+00 416+50

CONSTRUCT DRIVE
 RT
 414+50


UNCLASSIFIED CHANNEL EXCAVATION
 LI RT
 421+04 - 421+18 420+84 - 420+90
 STONE FILL FOR SLOPE PROTECTION LIGHT TYPE
 LI RT
 420+55 - 421+75

CONSTRUCT SPECIAL DITCH
 (ITEMS 103-A1 & 103-E)
 RT
 411+50 - 411+50
 411+50 - 412+50

BEGIN EASEMENT No. 1
 STA. 417+50 11' LT.
 LENGTH (64'±)

STATE OF VERMONT
 FORESTS-PARKS

WOODWARD RESERVOIR
 (Approximate Location)
 PLYMOUTH RESERVOIR Co. Inc.

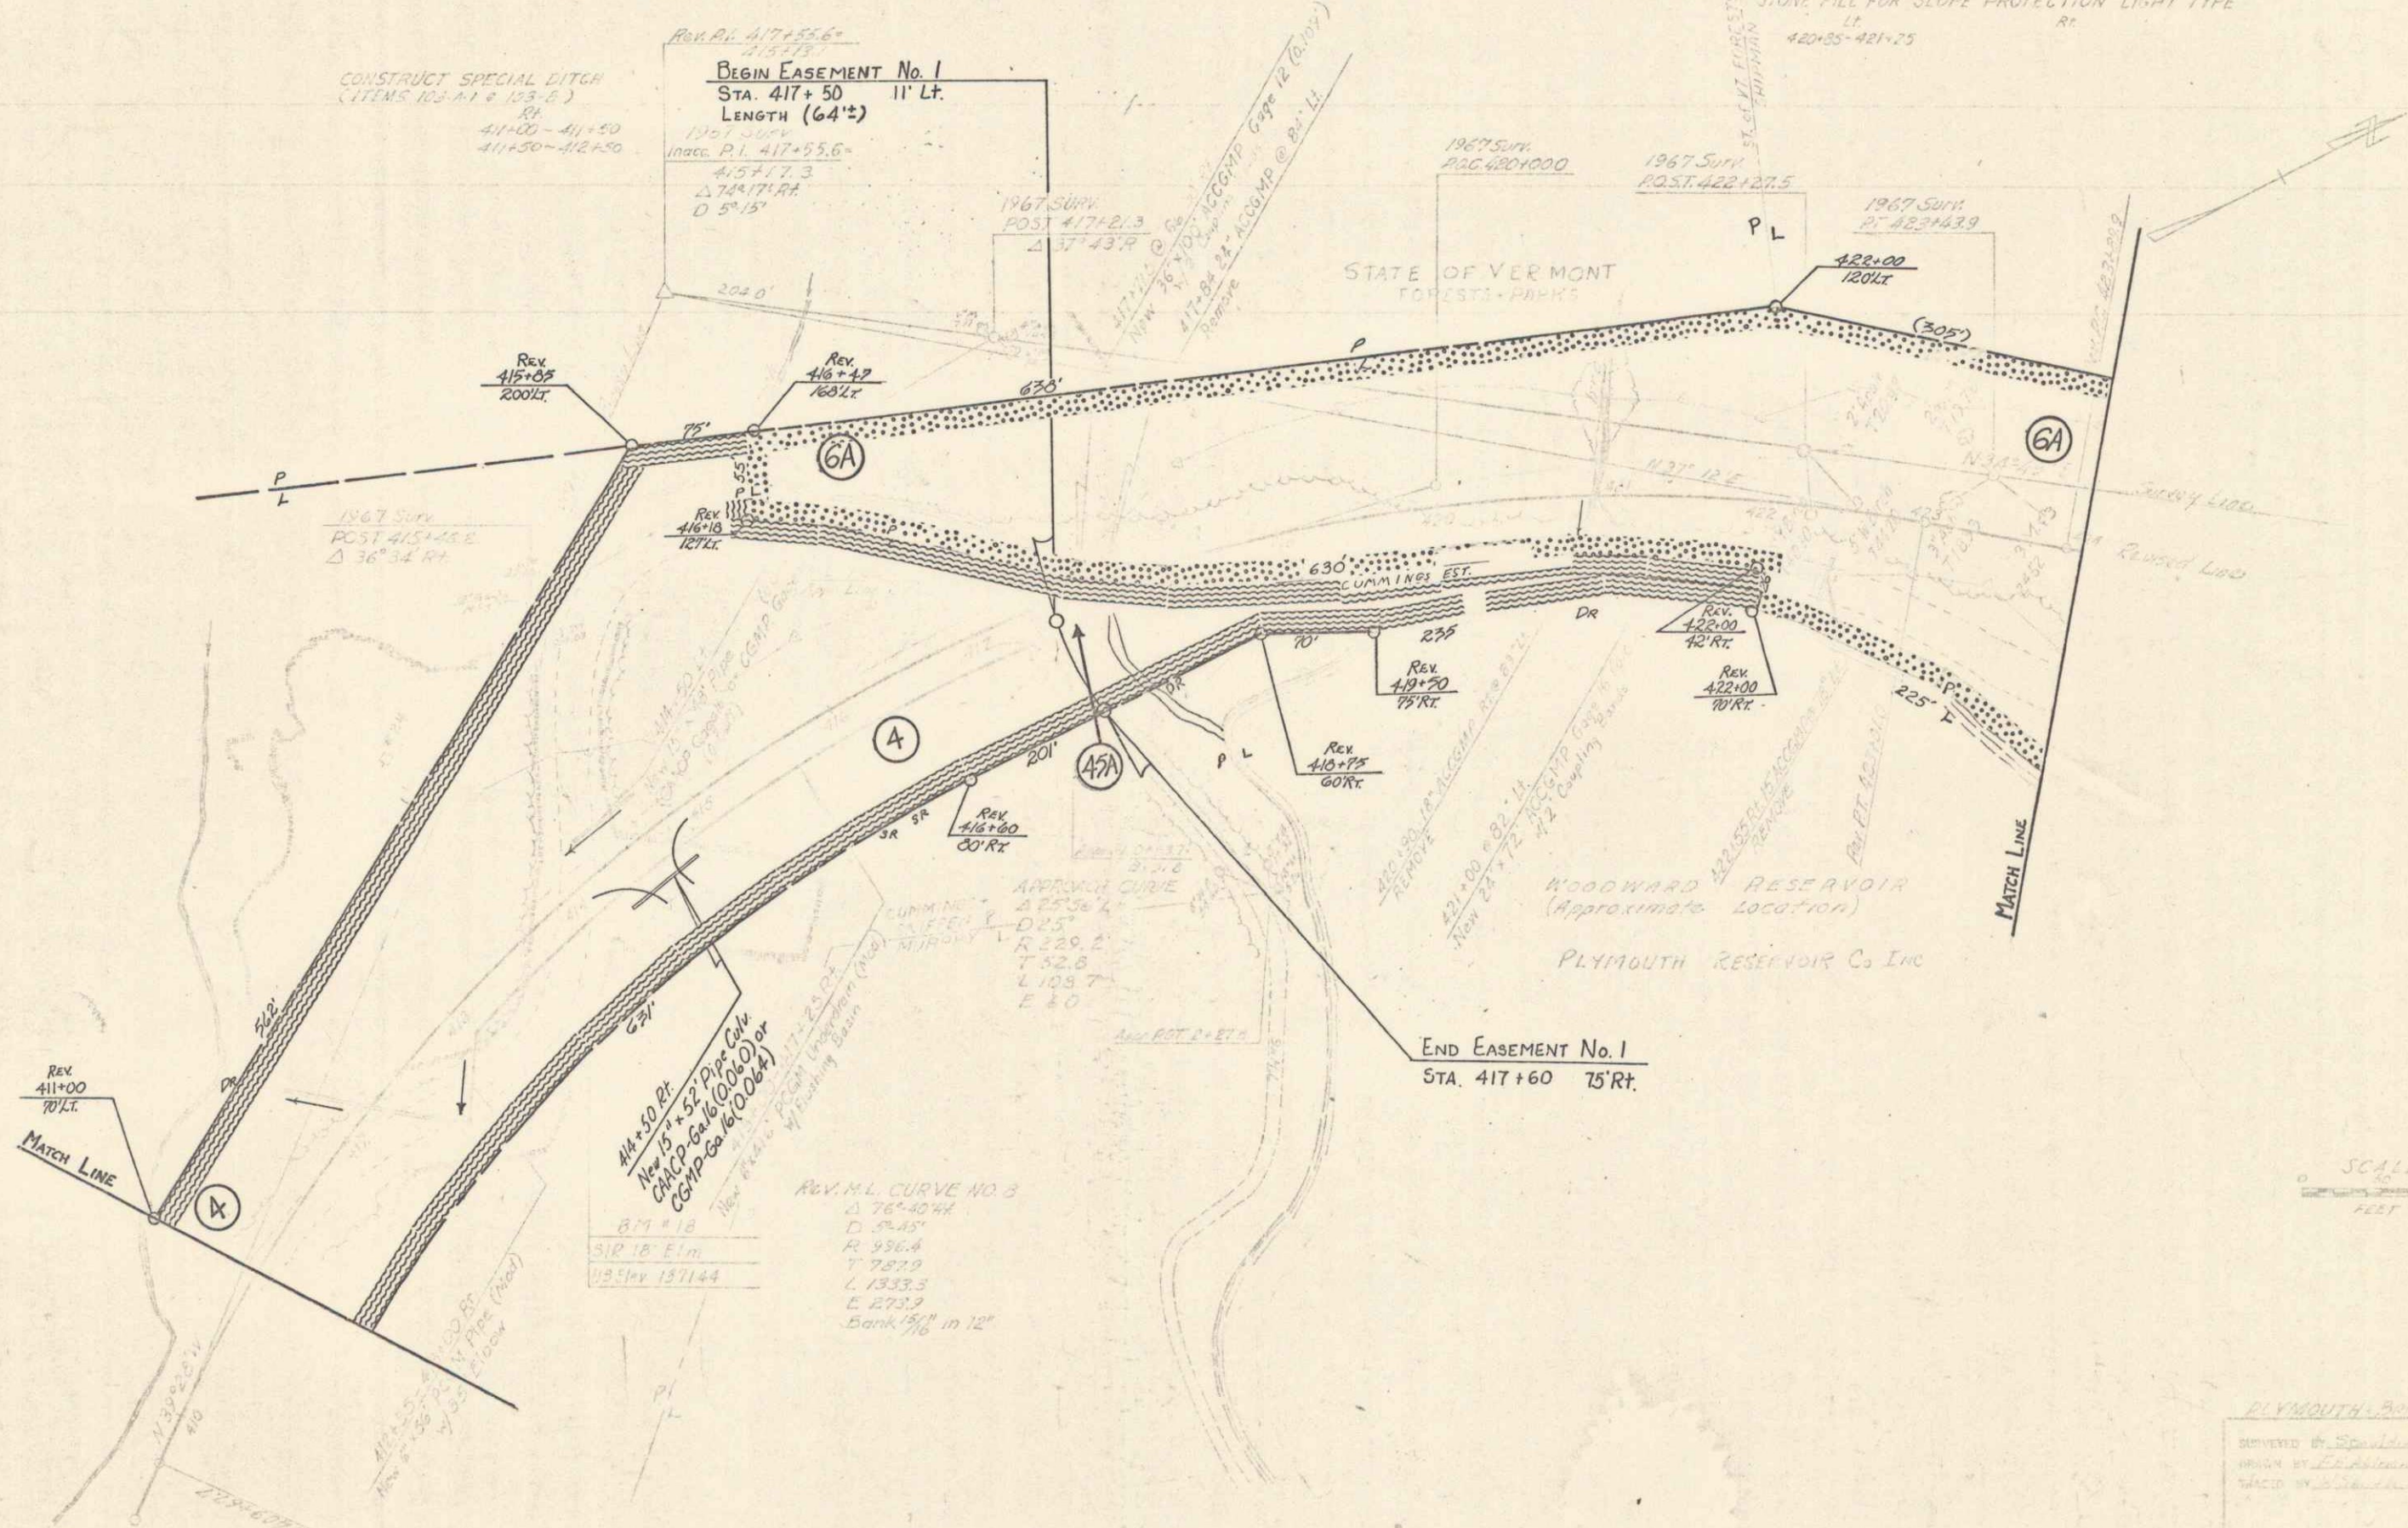

SCALE
 1" = 40'
 FEET

PLYMOUTH RESERVOIR
 DESIGNED BY
 DRAWN BY
 CHECKED BY

21A 34