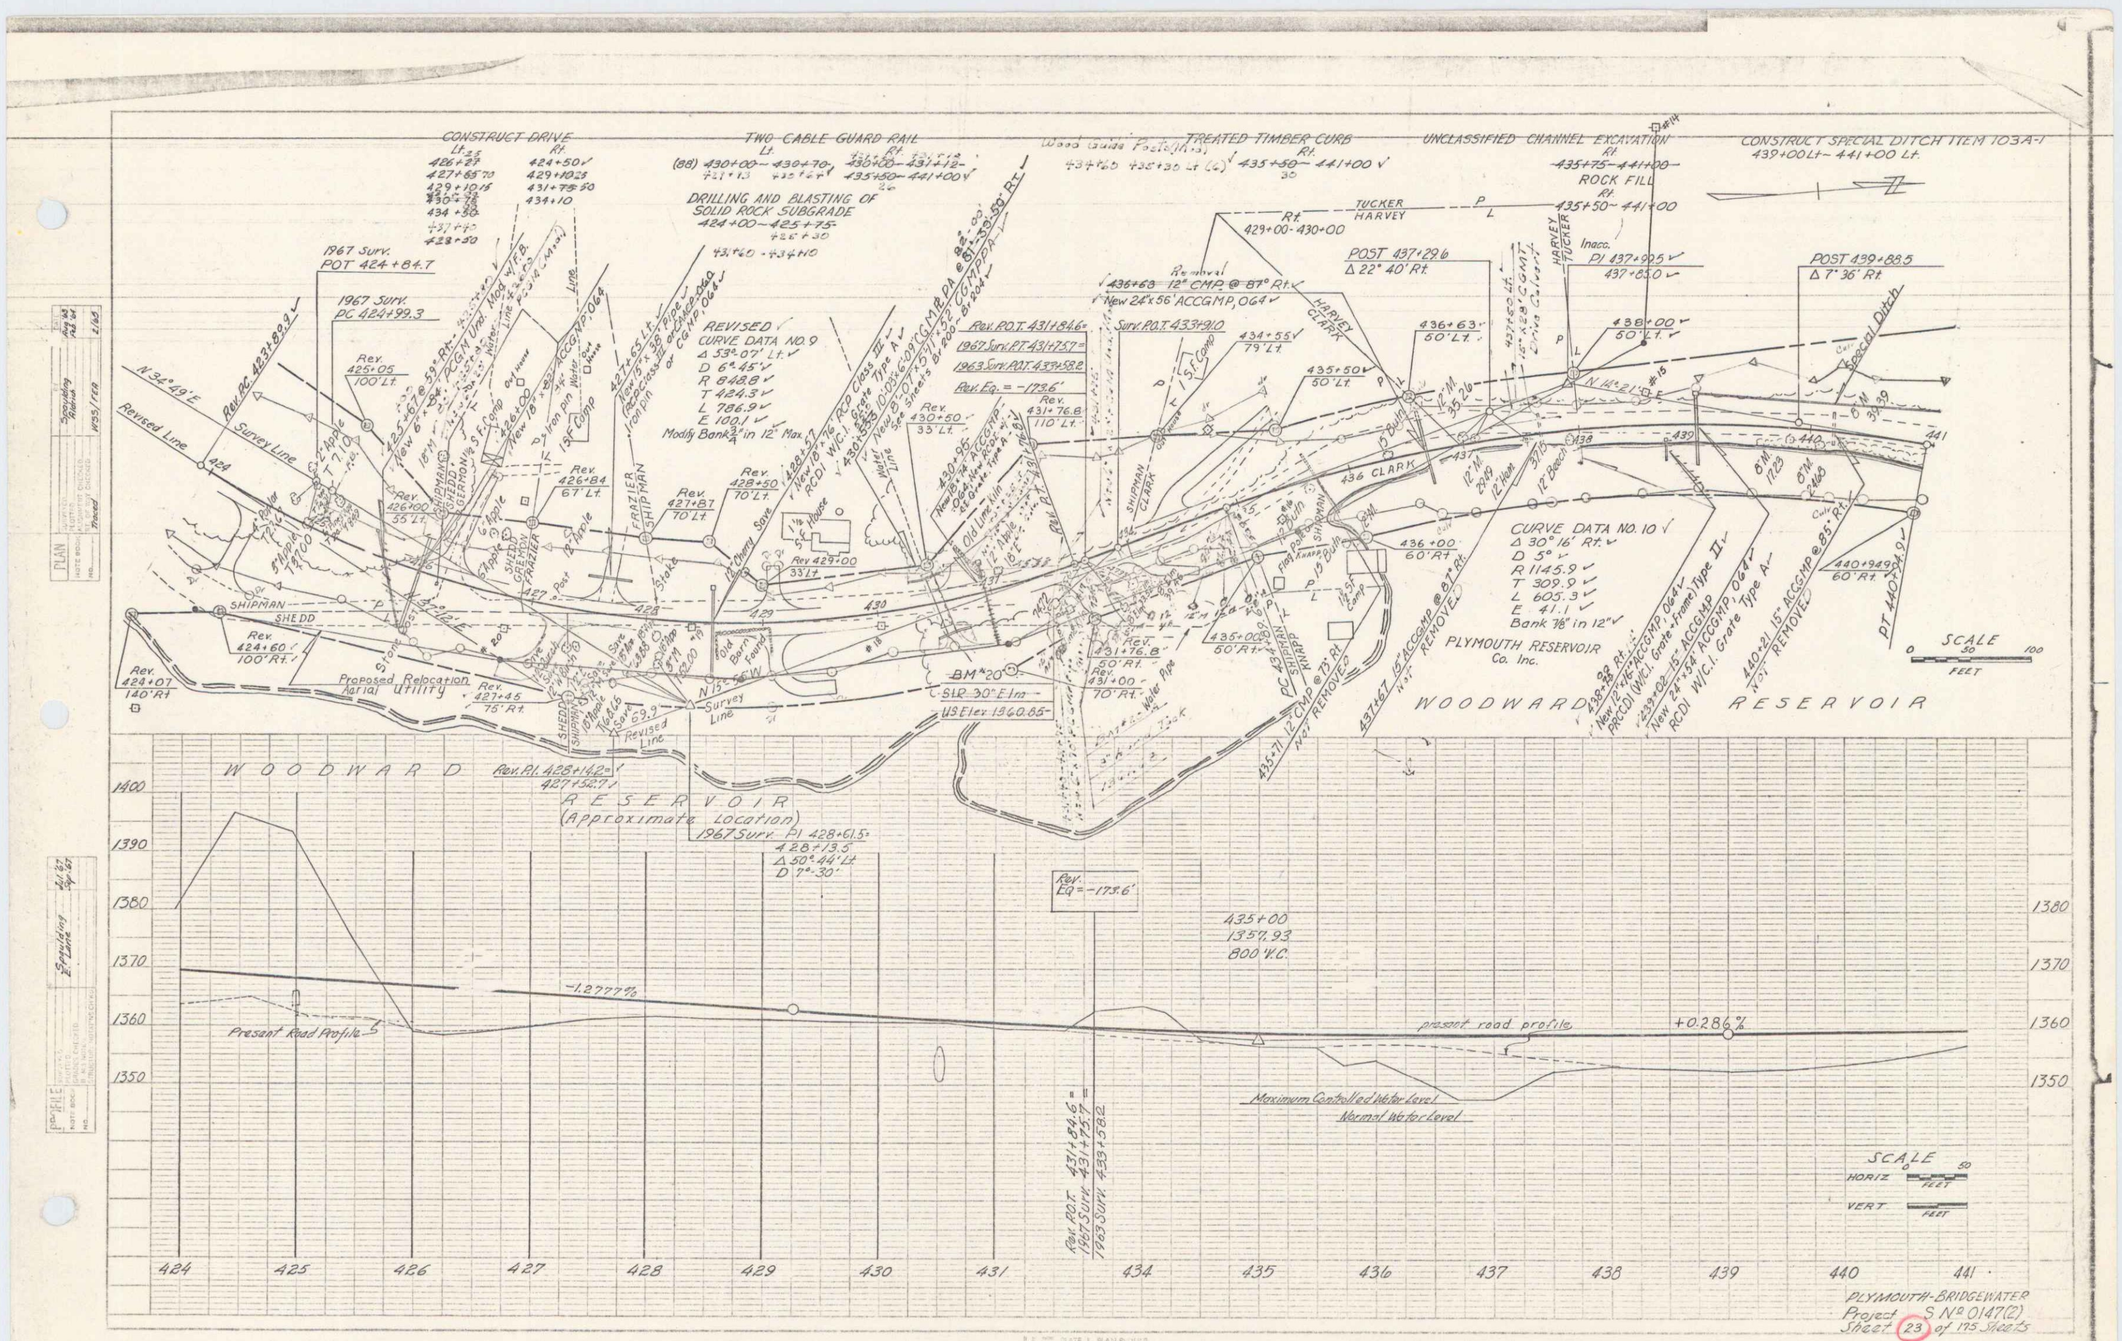
CONSTRUCT DRIVE
TWO CABLE GUARD RAIL
TREATED TIMBER CURB
UNCLASSIFIED CHANNEL EXCAVATION
CONSTRUCT SPECIAL DITCH ITEM 103A-1
DRILLING AND BLASTING OF SOLID ROCK SUBGRADE
REVISED CURVE DATA NO. 9
CURVE DATA NO. 10
POST 437+29.6
POST 439+88.5
PLYMOUTH RESERVOIR Co. Inc.
WOODWARD RESERVOIR
Proposed Relocation Aerial Utility
Present Road Profile
Maximum Controlled Water Level
Normal Water Level
SCALE
HORIZ
VERT
PLYMOUTH-BRIDGEWATER
Project S № 0147(2)
Sheet 23 of 175 Sheets

15