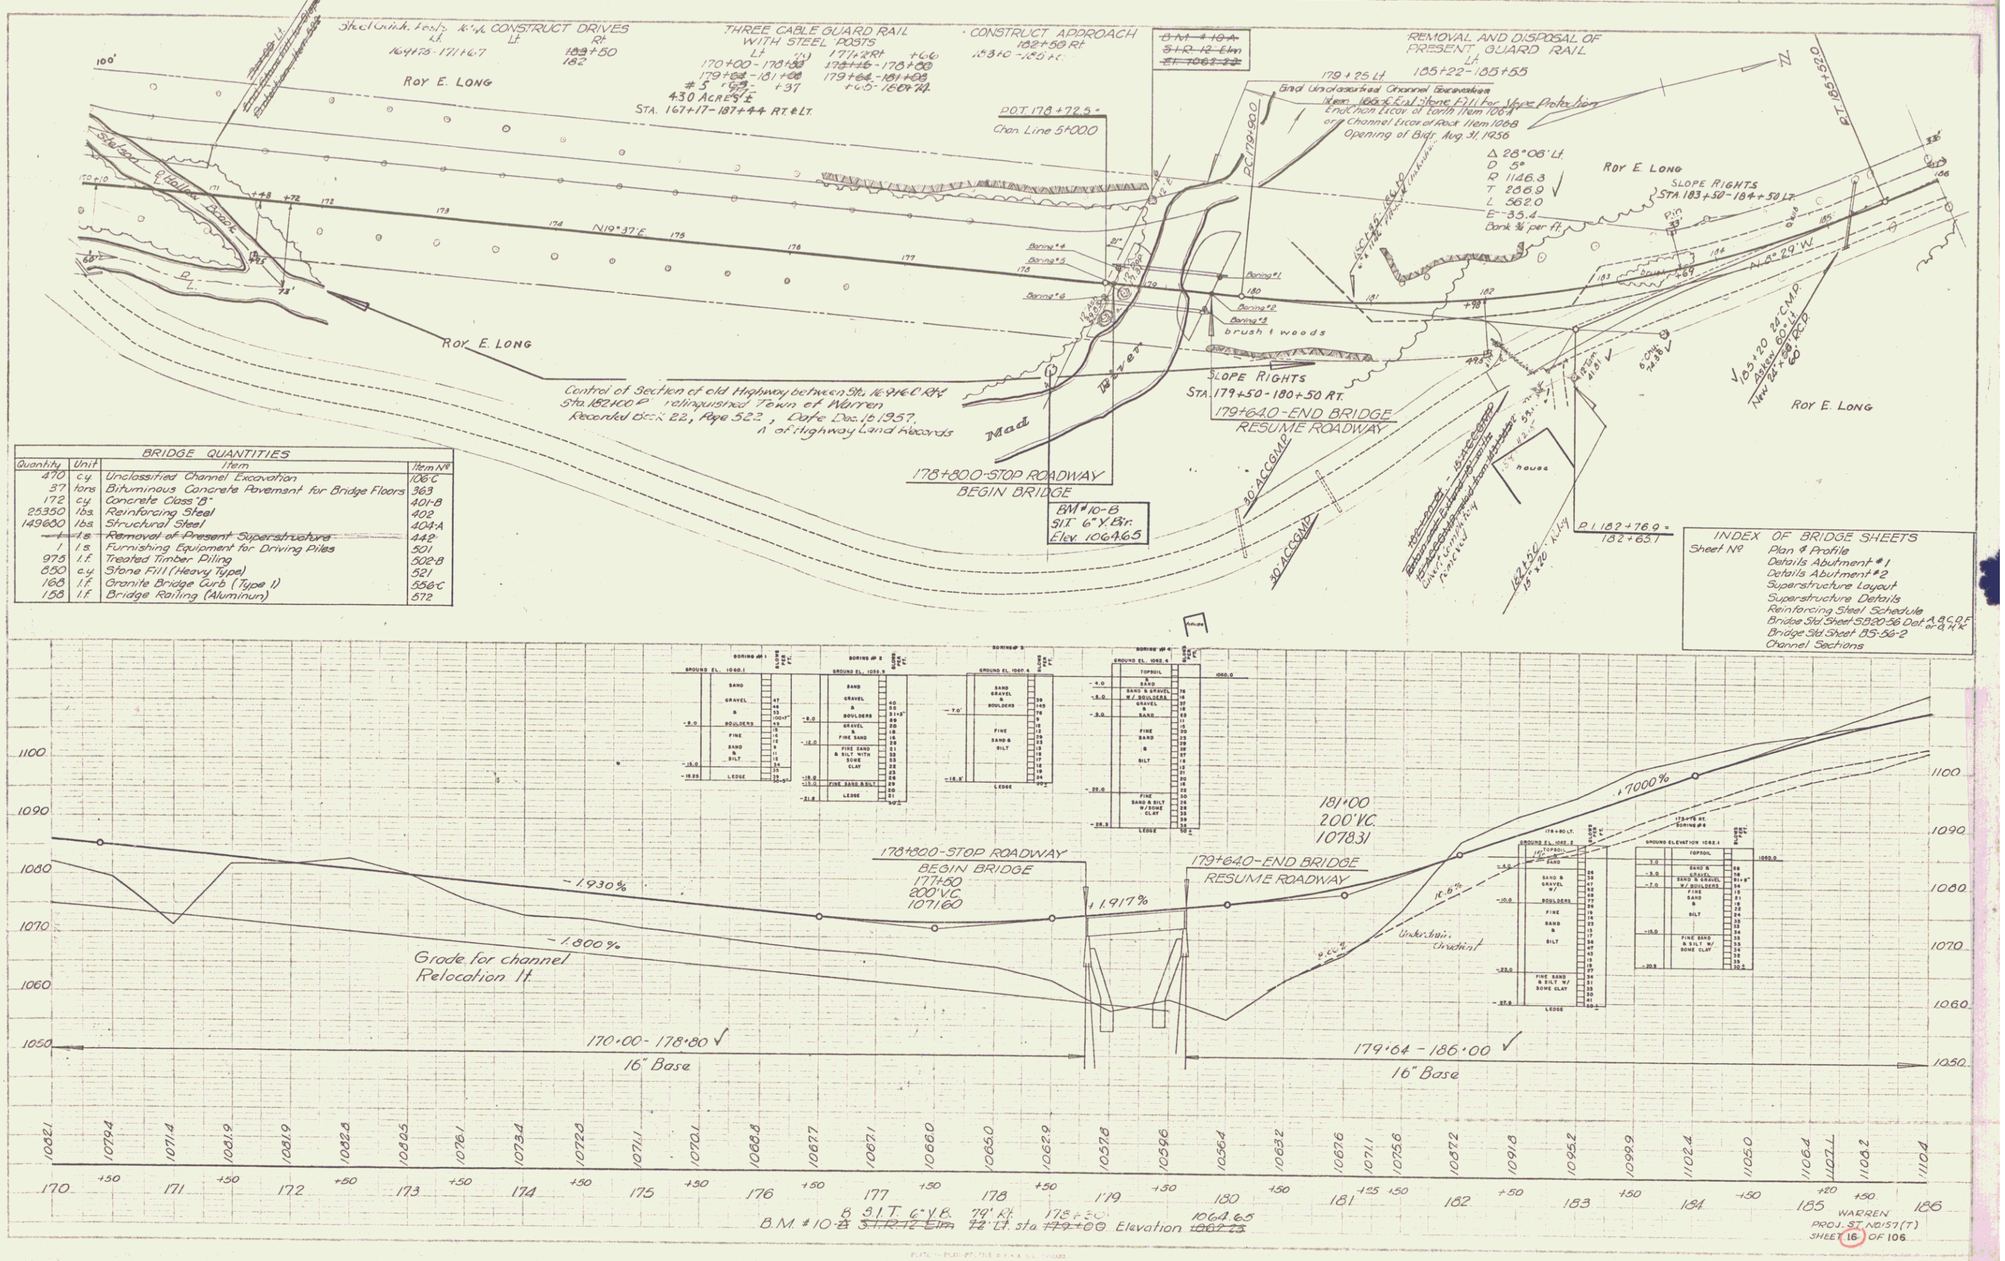

BRIDGE QUANTITIES			
Quantity	Unit	Item	Item No.
470	c.y.	Unclassified Channel Excavation	108-C
87	tons	Bituminous Concrete Pavement for Bridge Floors	363
172	c.y.	Concrete Class "B"	401-B
25350	lbs.	Reinforcing Steel	402
149600	lbs.	Structural Steel	404-A
~~1~~	~~l.s.~~	~~Removal of Present Superstructure~~	442
1	l.s.	Furnishing Equipment for Driving Piles	501
975	l.f.	Treated Timber Piling	502-B
650	c.y.	Stone Fill (Heavy Type)	521
168	l.f.	Granite Bridge Curb (Type I)	556-C
158	l.f.	Bridge Railing (Aluminum)	572