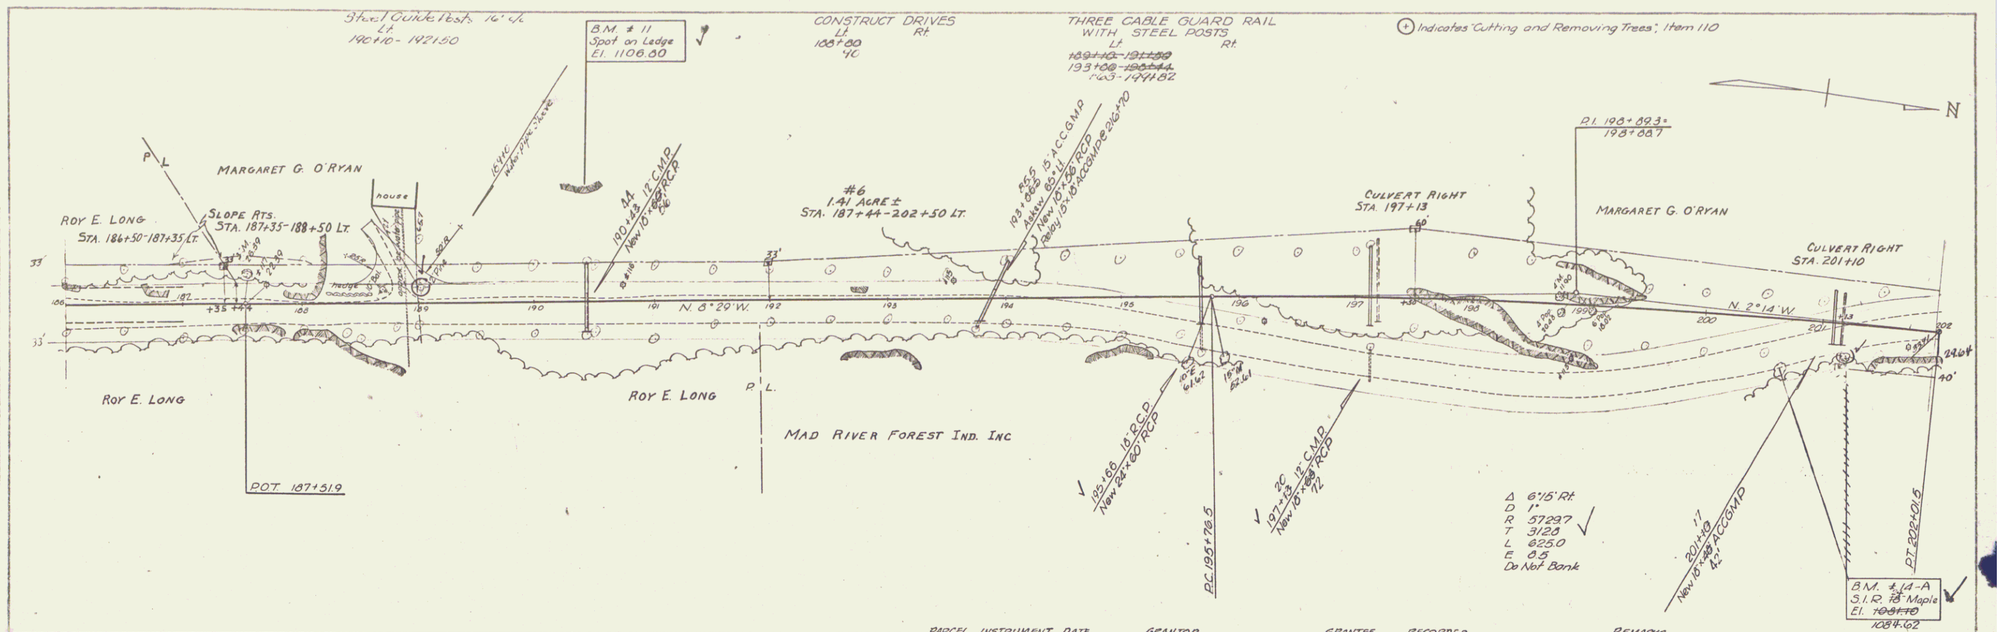
Steel Guide Posts 16' c/c
Lt.
190+10 - 192+50
B.M. # 11
Spot on Ledge
El. 1106.80
CONSTRUCT DRIVES
Lt
Rt
188+00
YC
THREE CABLE GUARD RAIL
WITH STEEL POSTS
Lt
Rt
193+00 - 199+44
193 - 199+82
Indicates Cutting and Removing Trees; Item 110
N
P.I. 198+89.3
198+88.7
MARGARET G. O'RYAN
ROY E. LONG
STA. 186+50-187+35 Lt.
SLOPE RTS.
STA. 187+35-188+50 Lt.
house
barn
hedge
Well
44
190+48 12" CMP
New 10" RCP
#6
1.41 ACRE ±
STA. 187+44-202+50 Lt.
193+65 15" ACCGMP
Rebuild 80'11"
New 15" RCP
Rebuild 15" ACCGMP 196+90
CULVERT RIGHT
STA. 197+13
60'
CULVERT RIGHT
STA. 201+10
N. 8° 29' W.
N. 2° 14' W.
ROY E. LONG
MAD RIVER FOREST IND. INC
P.L.
POT. 187+51.9
195+60 18" CCP
New 24" x 80' RCP
P.C. 195+78.5
197+13 30" 12" CMP
New 18" x 48' RCP
72
Δ 6°15' Rt
D 1°
R 572.97
T 31.23
L 62.50
E 0.5
Do Not Bank
201+49 17
New 18" x 48' ACCGMP
42"
P.T. 202+01.5
B.M. # 14-A
S.I.R. 18" Maple
El. 1084.62
PARCEL INSTRUMENT DATE GRANTOR GRANTEE RECORDED TOWN OF BOOK PAGE DATE REMARKS
6 Cond. 7-2-54 Margaret G. O'Ryan St. of Vt. Warren 18 367-372 7-6-54 See also sheet 18
7 Corp deed 6-15-56 Mad River Forest Industries, Inc. St. of Vt. Warren 15 358-359 6-29-56
+7.000%
-4.094%
-1.375%
Underdrain Gradient
187+50
700' VC
1123.81
N.P.S.D. = 288'
196+25
300' VC
1087.99
186+00 - 202+00
16" Base
1120
1110
1100
1090
1080
1070
1110.4 1113.7 1117.4 1120.2 1119.8 1117.5 1114.8 1112.7 1111.7 1109.5 1108.3 1107.7 1107.6 1108.8 1104.5 1103.2 1101.8 1099.7 1097.6 1096.0 1095.6 1093.3 1086.3 1085.5 1082.3 1082.7 1081.1 1079.9 1081.1 1079.3 1080.3 1087.1 1093.8 1096 1083.8 1081.0 1080.3 1080.4 1078.5
186 +50 187 +50 188 +28 +50 +80 189 +50 190 +43 +50 191 +50 192 +50 193 +50 194 +66.5 +50 195 +50 +68 196 +50 197 +13 +50 198 +50 199 +50 200 +50 201 +50 202
B.M. # 11 Spot on Ledge 93' Lt. sta. 190+39 Elevation 1106.80
B.M. # 14-A S.I.R. 18" Maple 28' Rt. Sta. 201+21 Elev. 1084.62
24" 47'
:00165 :28462 PROJ. STR. NO. 157(7)
WARREN
SHEET 17 OF 106