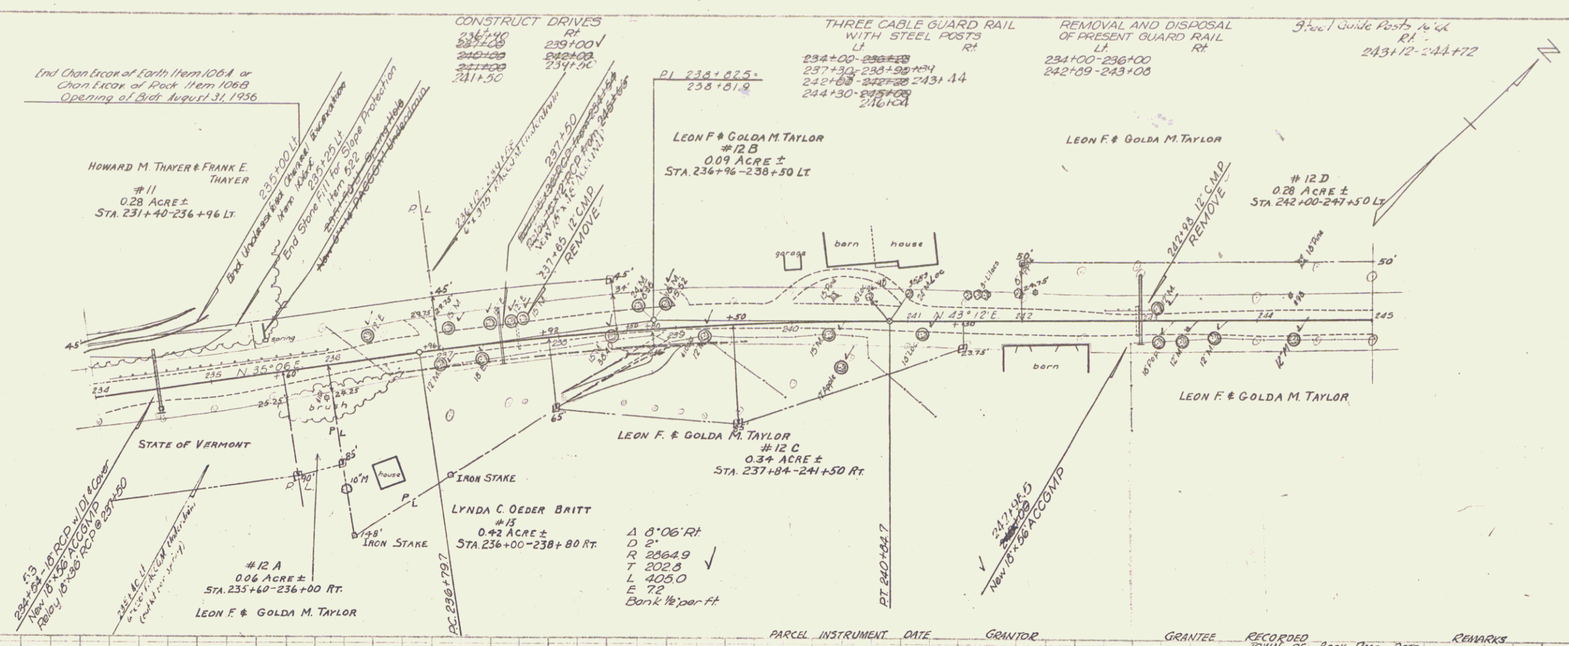


| PARCEL | INSTRUMENT | DATE | GRANTOR | GRANTEE | RECORDED TOWN OF | BOOK | PAGE | DATE | REMARKS |
|---|---|---|---|---|---|---|---|---|---|
| 12A,B,C, D,E | W D & E | 9-13-56 | Leon F. & Golda M. Taylor | St. of Vt. | Warren | 13 | 389-391 | 11-1-56 | See also sheet 21 |
| 13 | W D | 6-8-56 | Lynda C. Oeder Britt | St. of Vt. | Warren | 13 | 373 | 9-9-56 | |

WARREN
PROJ. ST. NO. 157(7)
SHEET 20 OF 106