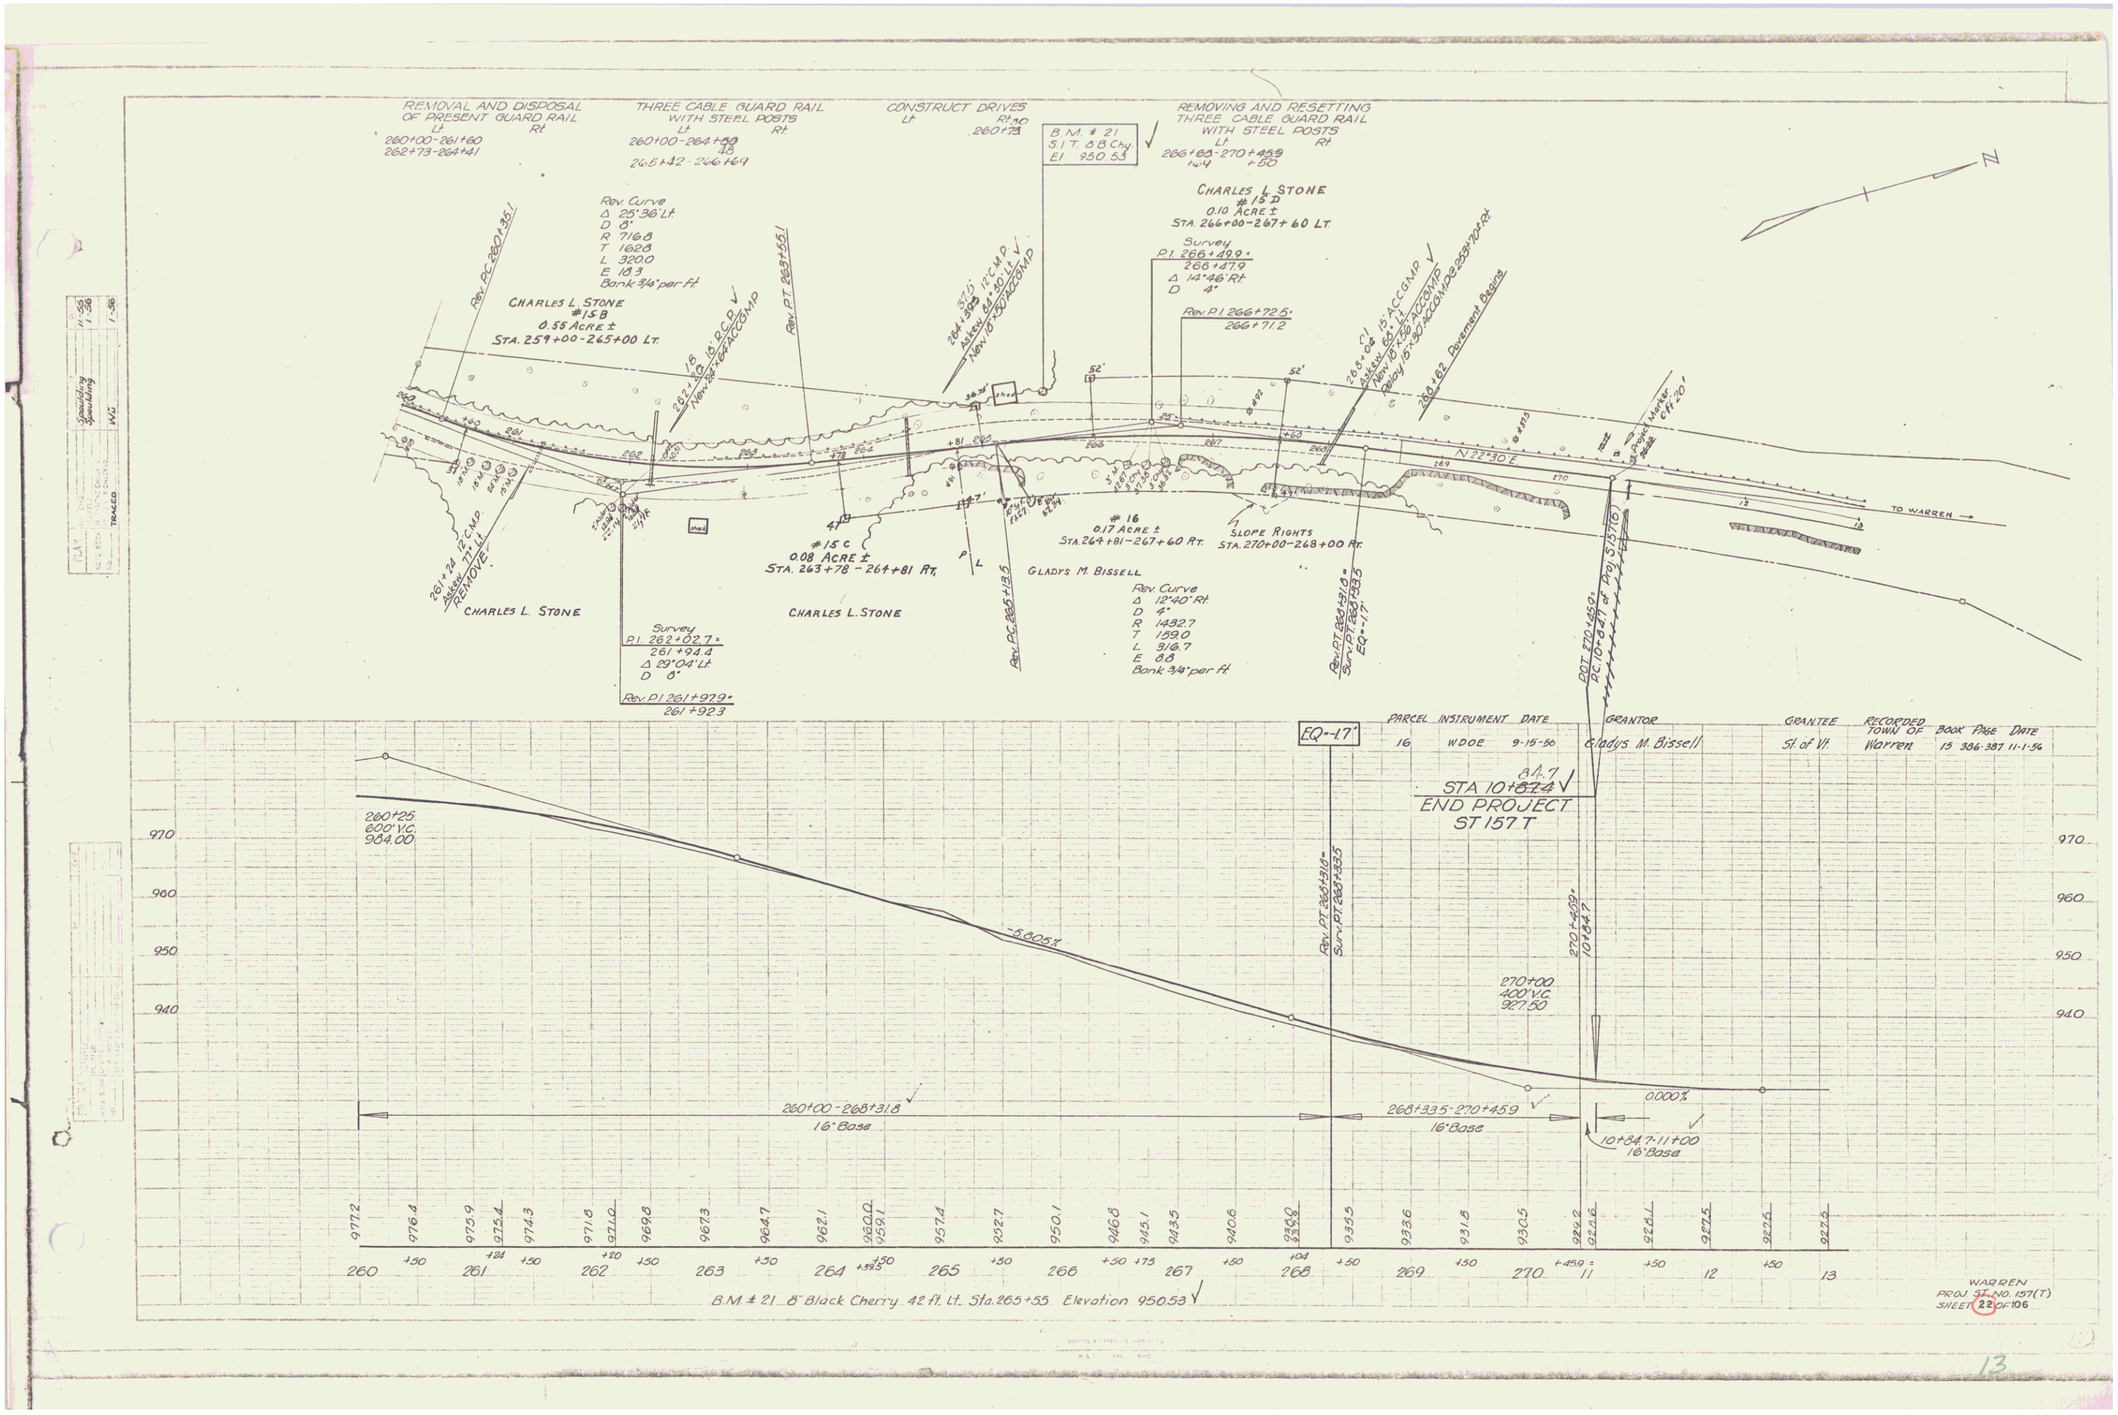
REMOVAL AND DISPOSAL OF PRESENT GUARD RAIL
Lt. Rt.
260+00-261+60
262+73-264+41
THREE CABLE GUARD RAIL WITH STEEL POSTS
Lt. Rt.
260+00-264+69
265+42-266+69
CONSTRUCT DRIVES
Lt. Rt.
REMOVING AND RESETTING THREE CABLE GUARD RAIL WITH STEEL POSTS
Lt. Rt.
266+68-270+459
B.M. # 21
S.1.T. 8" Chy.
El 950.53
Rev. Curve
Δ 25°36' Lt.
D 8°
R 716.8
T 162.8
L 320.0
E 10.3
Bank 3/4" per ft.
CHARLES L. STONE
#15B
0.55 Acre ±
STA. 259+00-265+00 LT.
CHARLES L. STONE
#15D
0.10 Acre ±
STA. 266+00-267+60 LT.
Survey
P.I. 266+49.9
266+47.9
Δ 14°46' Rt.
D 4°
Rev. P.I. 266+72.5
266+71.2
Rev. P.C. 260+35.1
Rev. P.T. 263+55.1
Rev. P.C. 265+13.5
Rev. P.T. 268+31.8
Sur. P.T. 268+33.5
EQ=17'
Pavement Begins
N 22°30' E
TO WARREN
CHARLES L. STONE
Survey
P.I. 262+02.7
261+94.4
Δ 29°04' Lt.
D 8°
Rev. P.I. 261+97.9
261+92.3
#15C
0.08 Acre ±
STA. 263+78-264+81 Rt.
CHARLES L. STONE
#16
0.17 Acre ±
STA. 264+81-267+60 Rt.
SLOPE RIGHTS
STA. 270+00-268+00 Rt.
GLADYS M. BISSELL
Rev. Curve
Δ 12°40' Rt.
D 4°
R 1432.7
T 159.0
L 316.7
E 8.8
Bank 3/4" per ft.
PARCEL INSTRUMENT DATE GRANTOR GRANTEE RECORDED TOWN OF BOOK PAGE DATE
16 WDOE 9-15-56 Gladys M. Bissell St. of Vt. Warren 13 386-387 11-1-56
STA 10+84.7
END PROJECT
ST 157 T
260+25
600' V.C.
904.00
270+00
400' V.C.
927.50
-5.805%
0.000%
260+00-268+31.8
16' Base
268+33.5-270+45.9
16' Base
10+84.7-11+00
16' Base
B.M. # 21 8" Black Cherry 42 ft. Lt. Sta. 265+55 Elevation 950.53
WARREN
PROJ. ST. NO. 157(T)
SHEET 22 OF 106

13