


PARCEL	KIND	DATE	GRANTOR	GRANTEE	RECORDED WARREN BOOK	PAGE	DATE	REMARKS
16A	W.D.O.E.	3-13-53	E.H. & Myrtle M. Richardson	State of Vermont	15	328-329	4-11-53	
16B	"	12-3-53	"	"	15	324	12-7-53	Ditch Rights
17	"	3-13-53	Roy E. & Mildred J. Long	"	15	303-304	3-20-53	
18	"	3-24-53	Florence M. & Edgar L. Edmonds	"	15	325-326	4-4-53	
19	"	3-12-53	Mildred M. Kenyon	"	15	301-302	3-20-53	
20	G.C.D.	3-24-53	Y. Pierre & Catherine Brundin	"	15	324-325	4-4-53	

FED. ROAD DIST. NO.	STATE	C	FISCAL YEAR	SHEET NO.	TOTAL SHEETS
9	Vt.	157(6)	1953	19	135

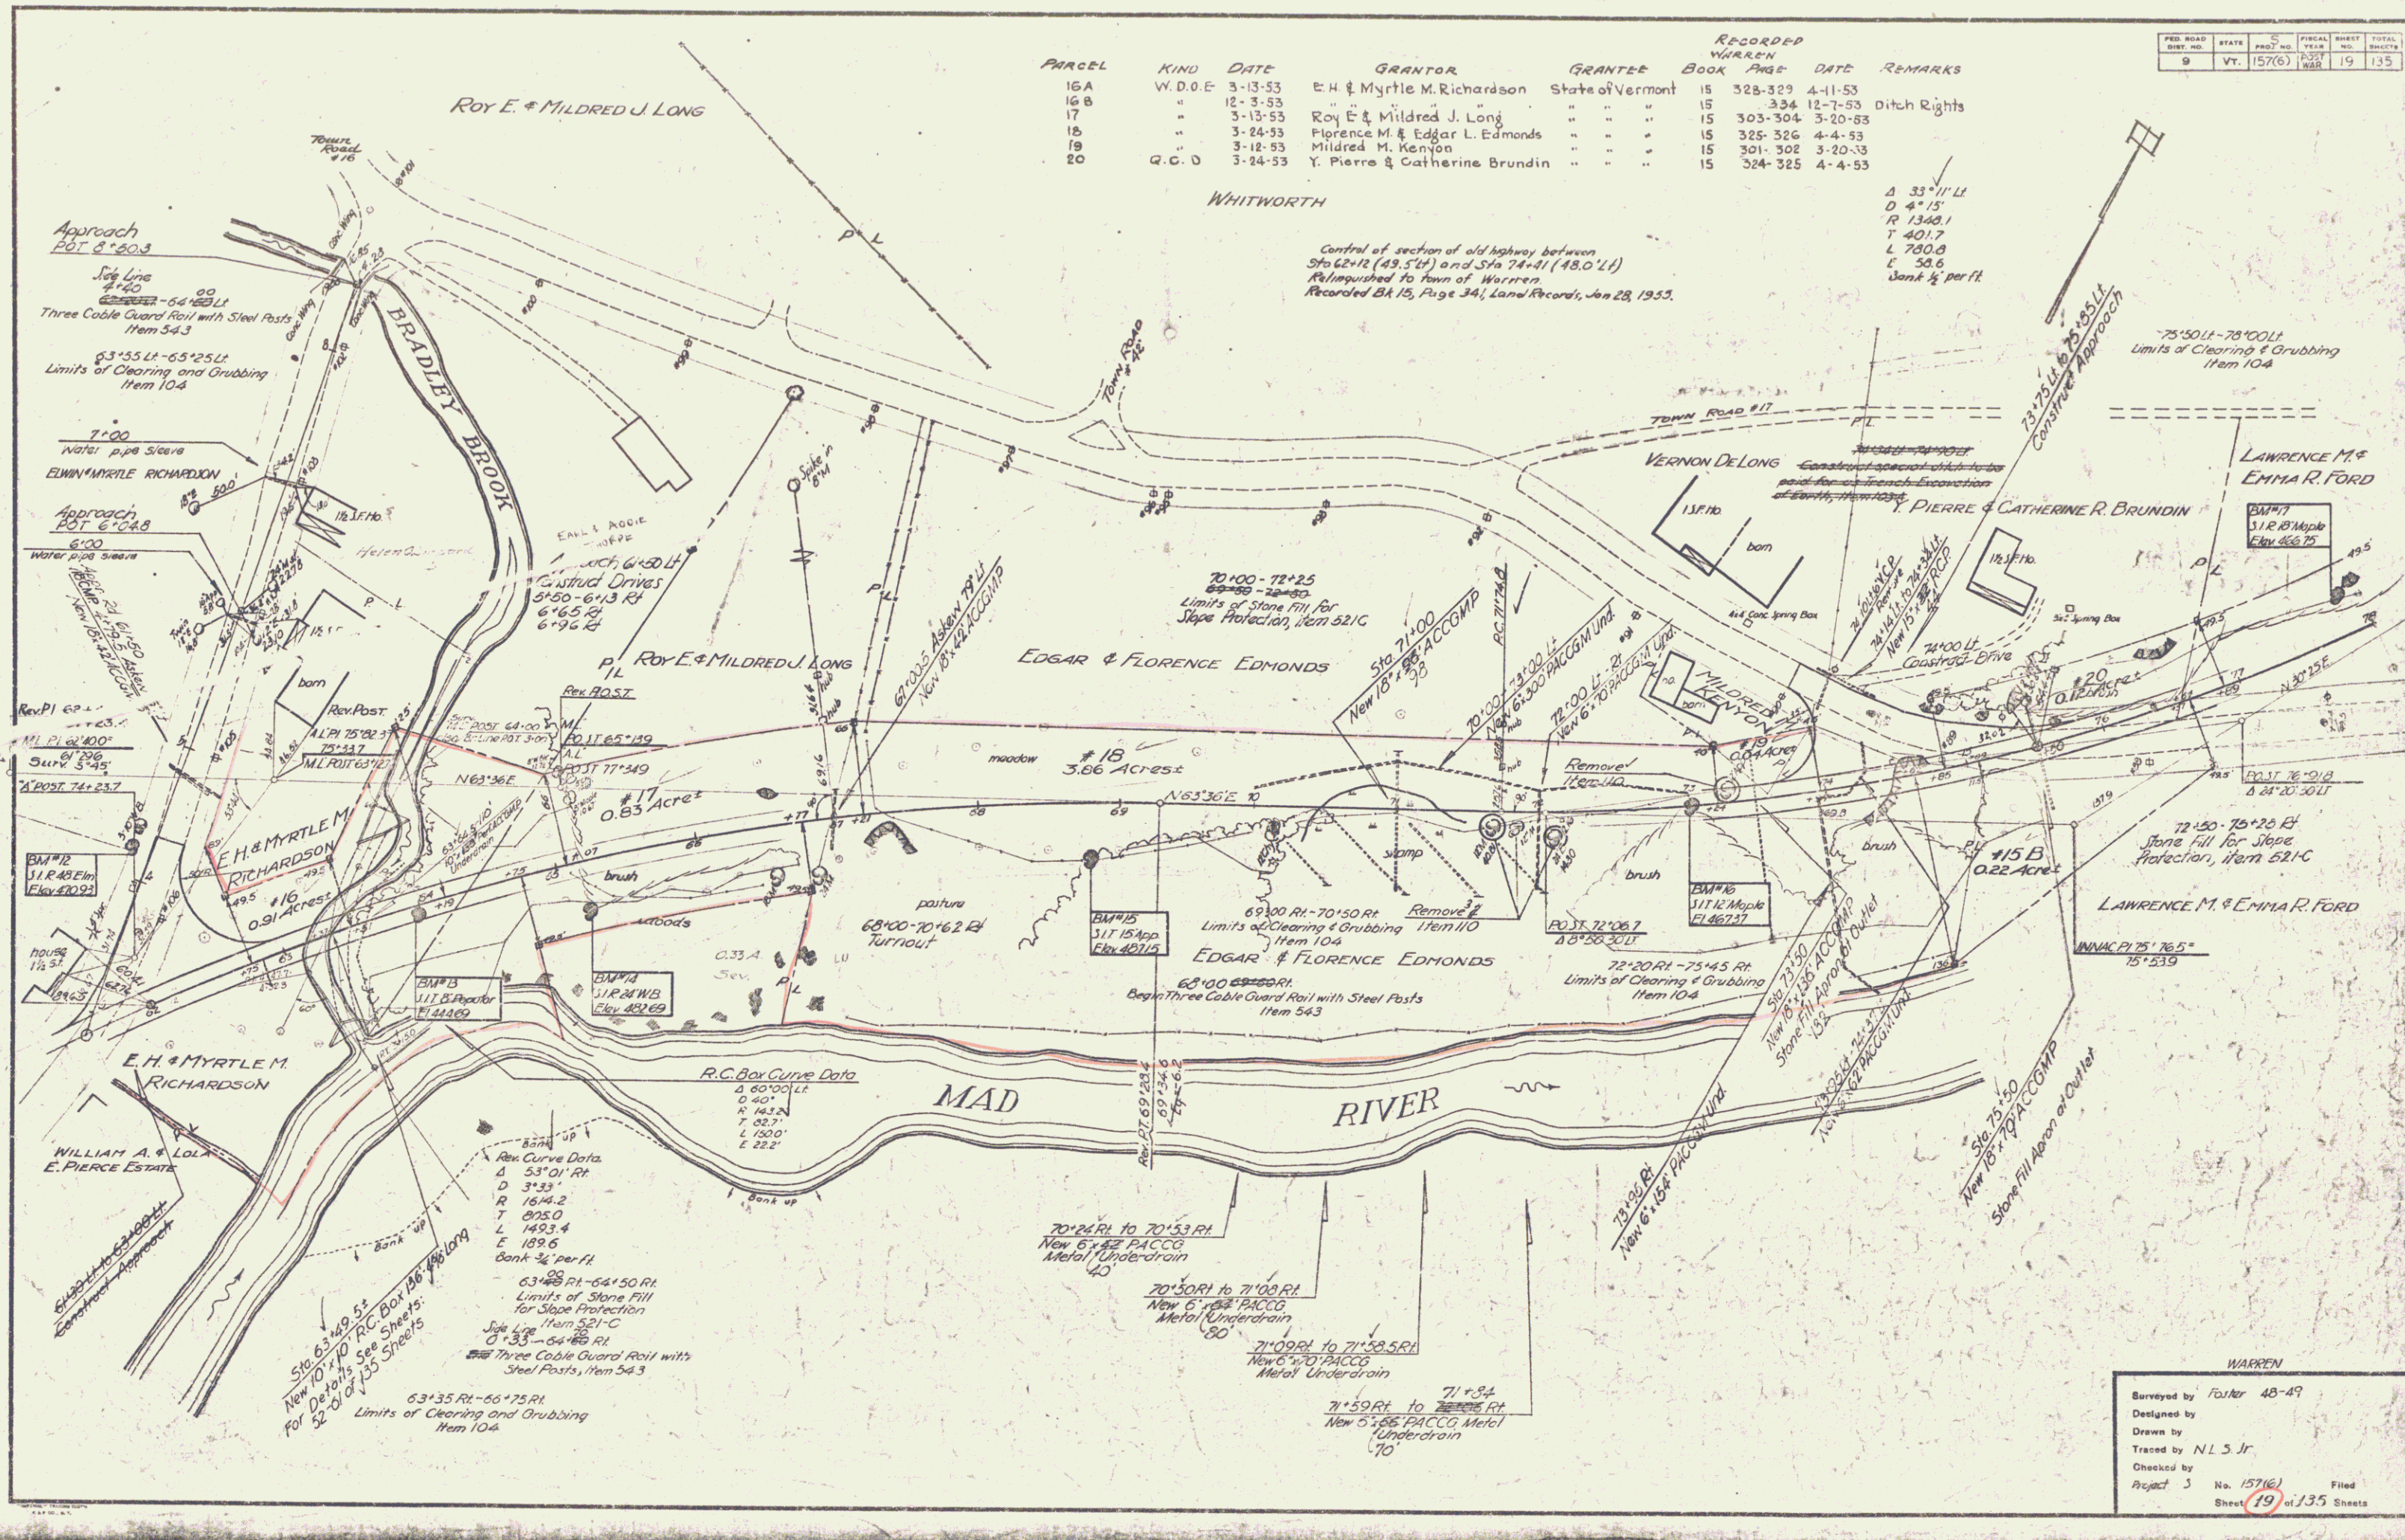

WARREN
 Surveyed by Foster 48-49
 Designed by
 Drawn by
 Traced by N.L.S. Jr.
 Checked by
 Project 3 No. 157(6) Filed
 Sheet 19 of 135 Sheets