FED. ROAD DIST. NO.	STATE	PROJ. NO.	FISCAL YEAR	SHEET NO.	TOTAL SHEETS
9	VT.	S 157(6)	1954 MAR	21	135

PARCEL	KIND	DATE	GRANTOR	GRANTEE	RECORDED WARREN Book	PAGE	DATE	REMARKS
15C	W.D.O.E	3-13-53	Lawrence H. & Emma R. Ford	State of Vermont	15	299-300-301	3-20-53	See Sheets 19 & 23.

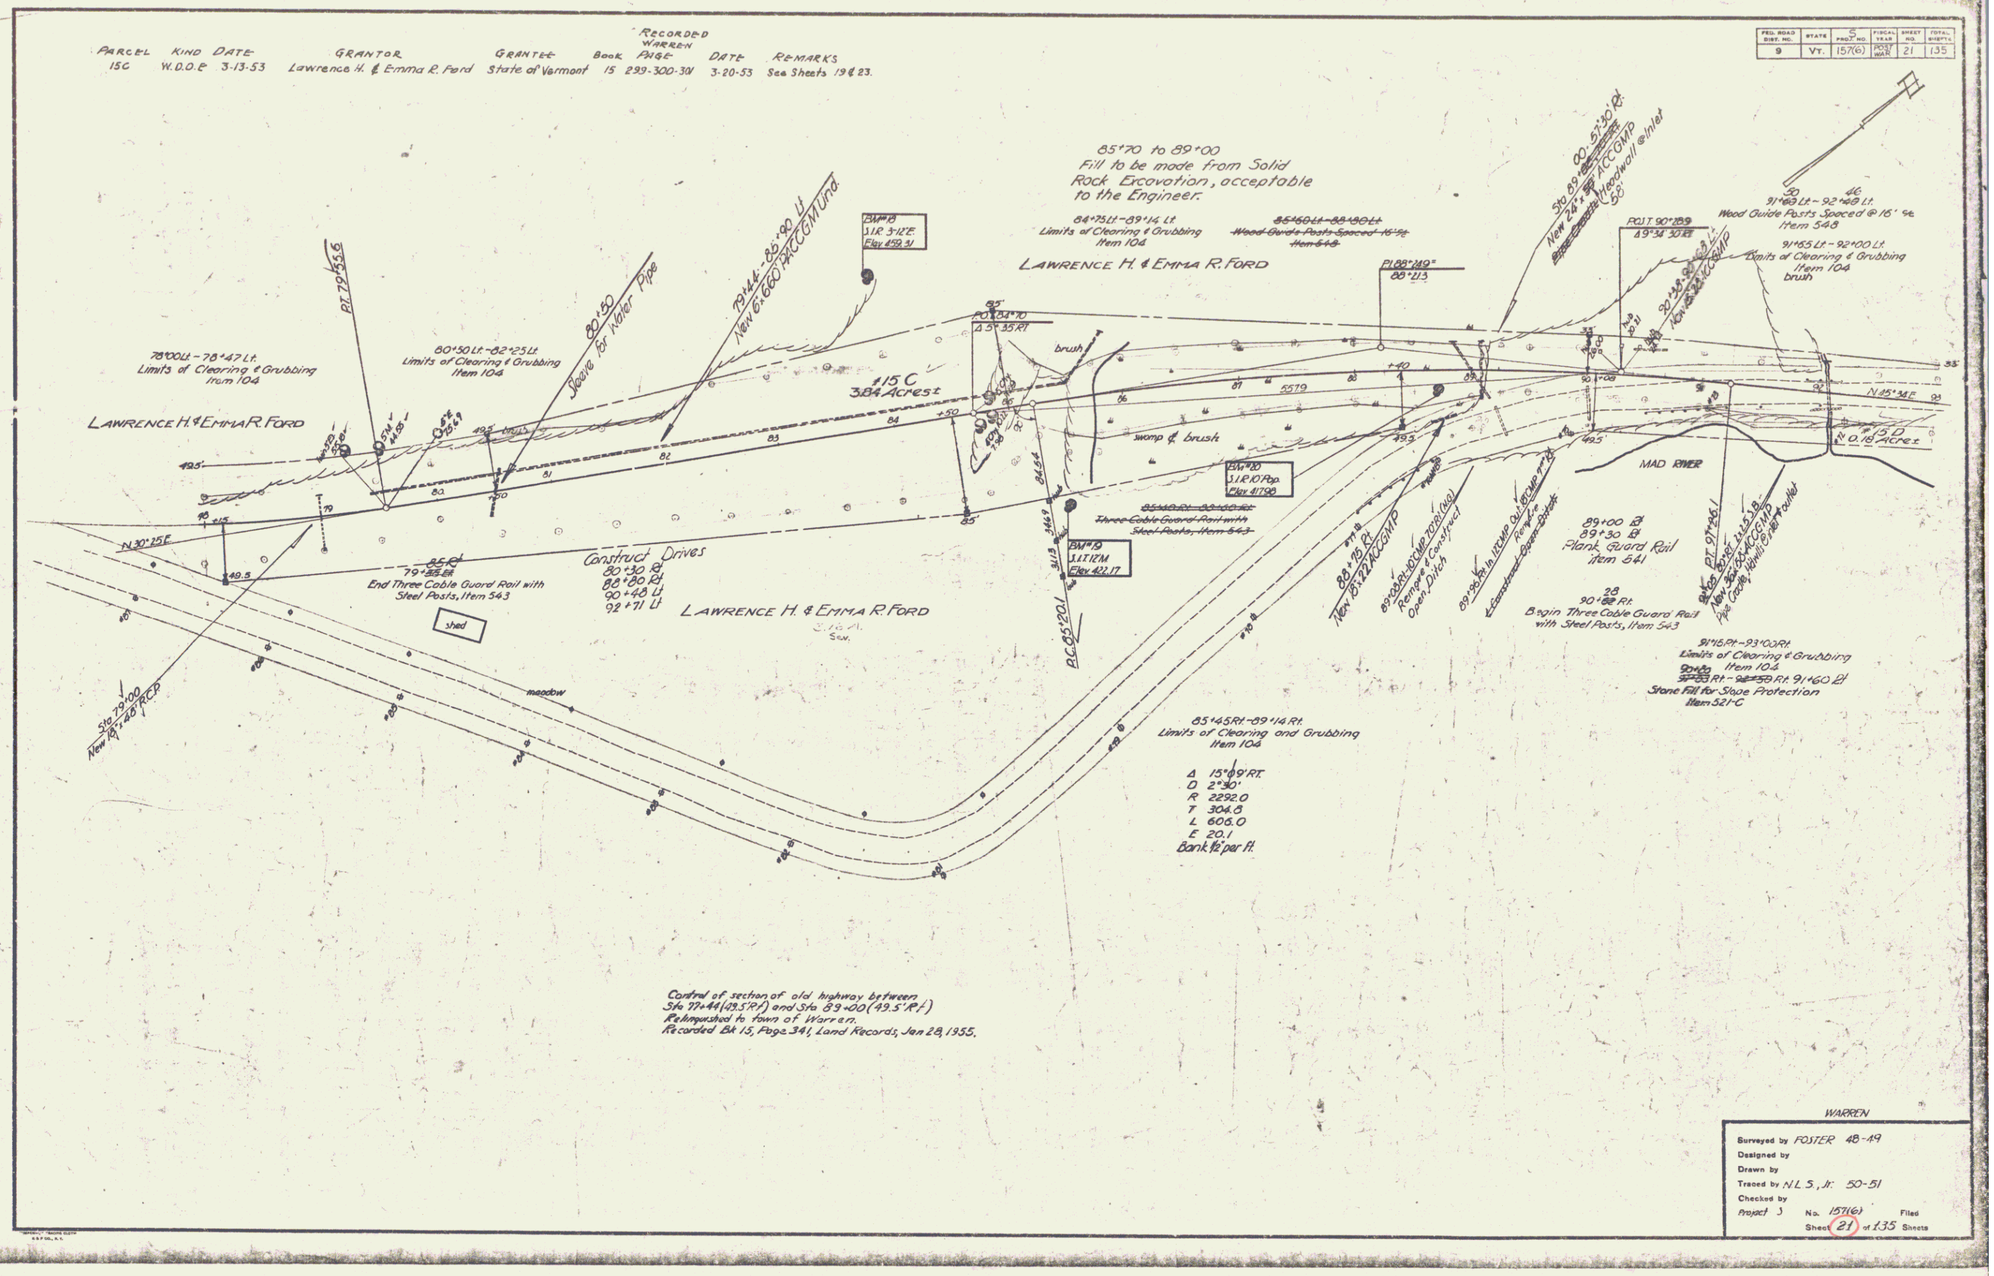

WARREN

Surveyed by FOSTER 48-49
Designed by
Drawn by
Traced by N.L.S., Jr. 50-51
Checked by
Project 3 No. 157(6) Filed
Sheet 21 of 135 Sheets

8