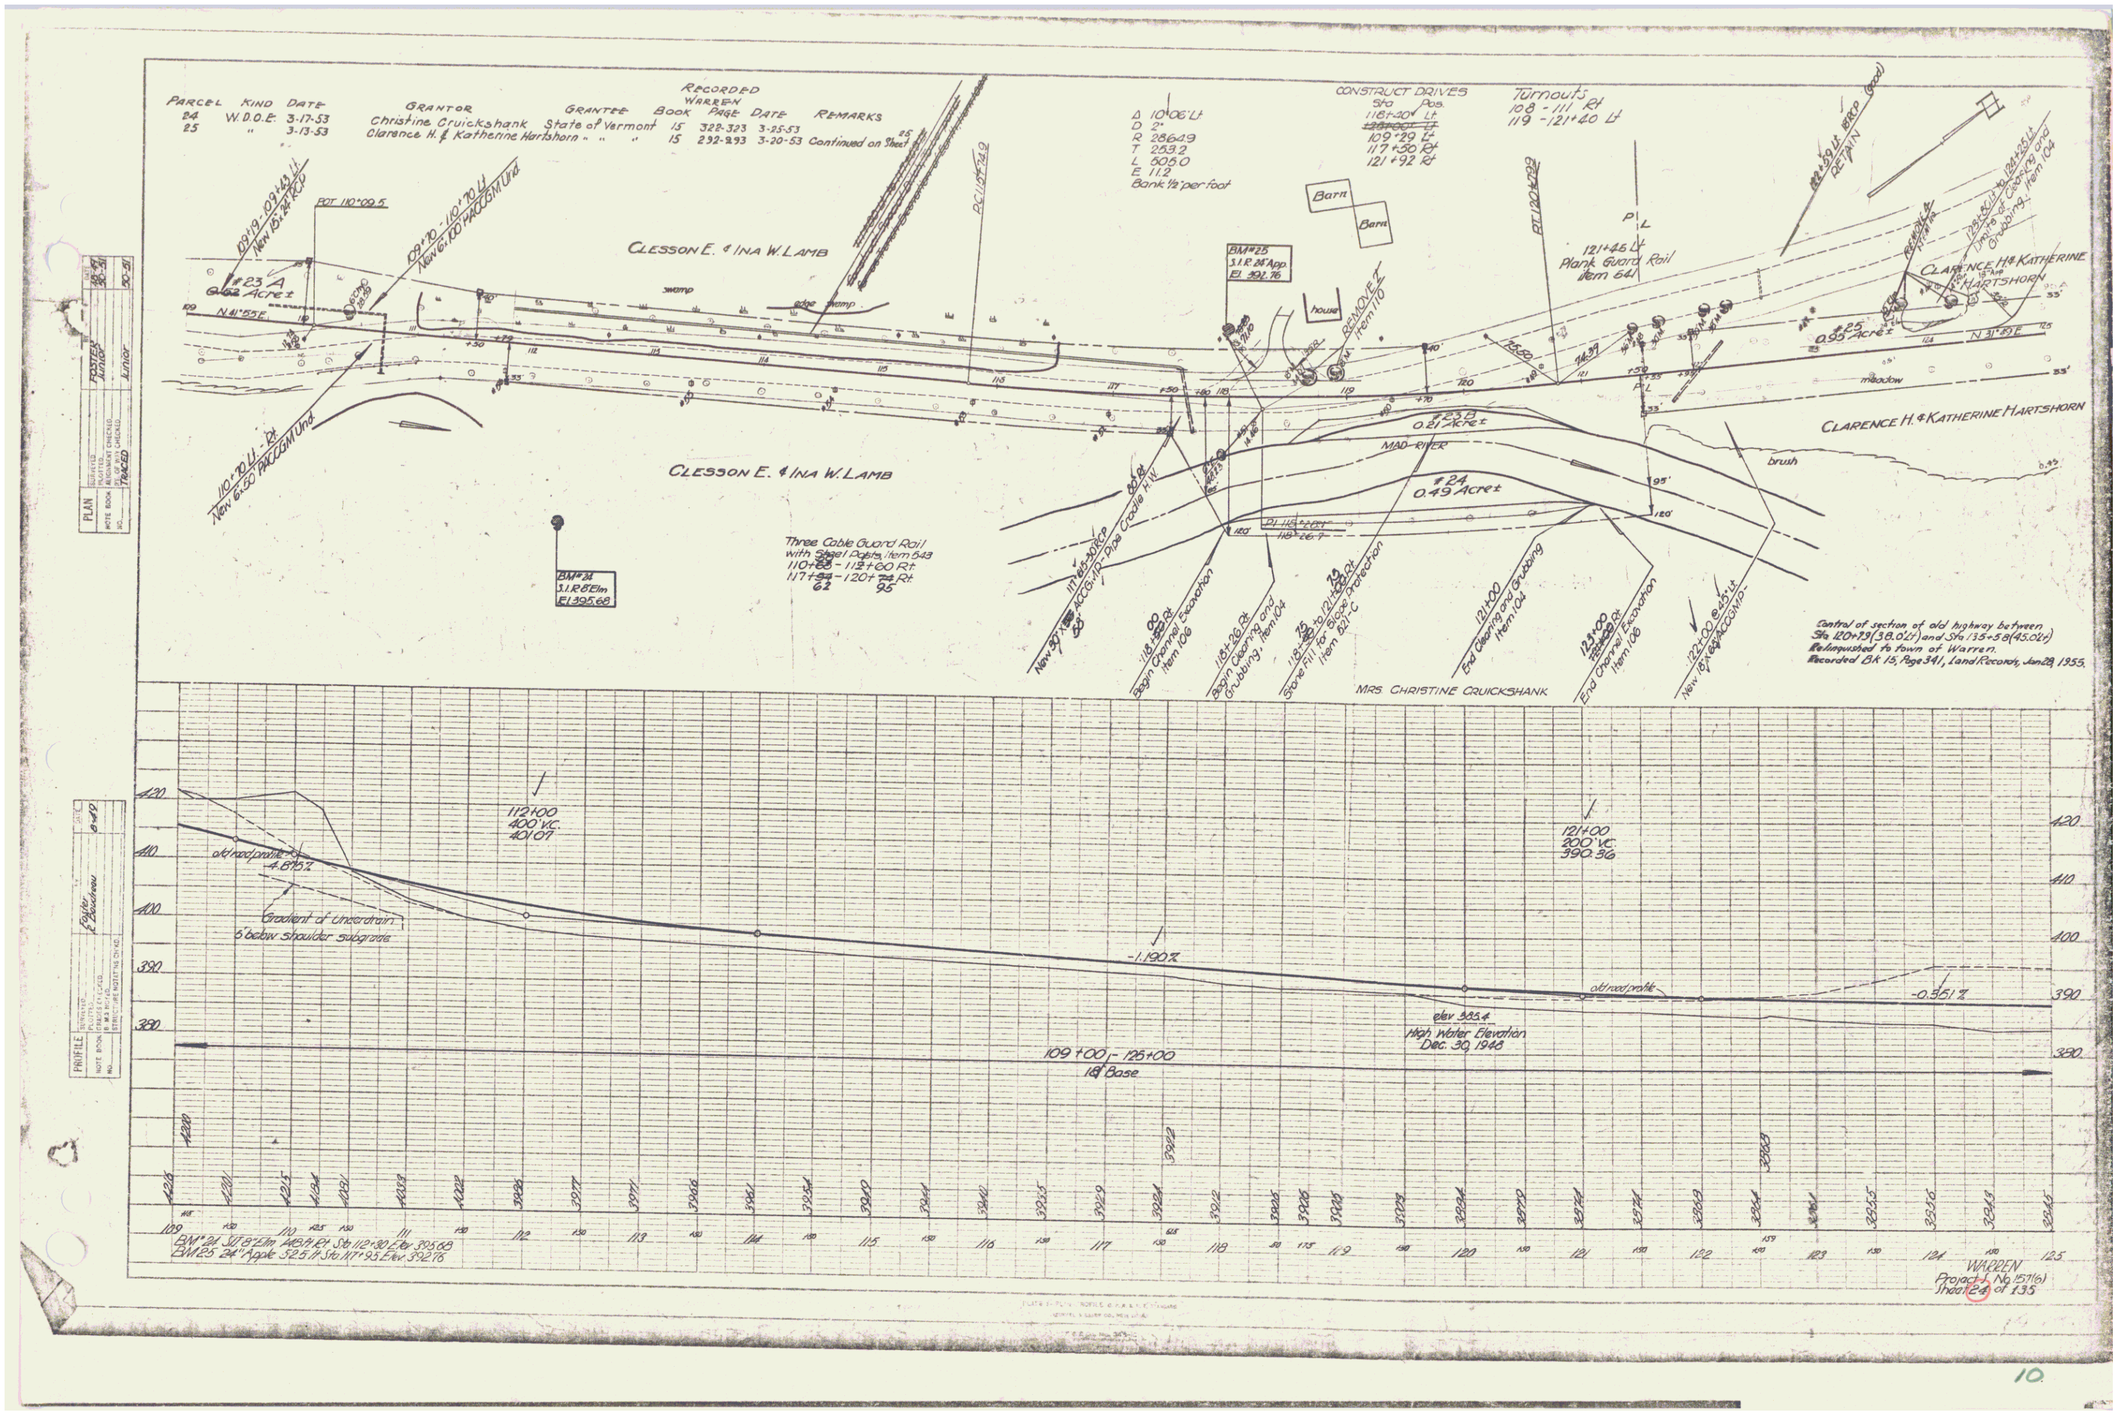
PARCEL KIND DATE GRANTOR GRANTEE RECORDED WARREN BOOK PAGE DATE REMARKS
24 W.D.O.E. 3-17-53 Christine Cruickshank State of Vermont 15 322-323 3-25-53
25 " 3-13-53 Clarence H. & Katherine Hartshorn " " " 15 232-233 3-20-53 Continued on Sheet 25
Δ 10°06' Lt
D 2°
R 2864.9
T 253.2
L 506.0
E 11.2
Bank 1½ per foot
CONSTRUCT DRIVES
Sta. Rep.
116+40 Lt
109+29 Lt
117+50 Rt
121+92 Rt
Turnouts
108 - 111 Rt
119 - 121+40 Lt
Barn
Barn
house
REMOVE
Item 110
121+46 Lt
Plank Guard Rail
Item 641
CLESSON E. & INA W. LAMB
swamp
edge swamp
#23 A
0.62 Acre±
N 41°55' E
BOT 110°09.5
109+70 - 110+70 Lt
New 6.00 PACCGM Und
110+70 Lt - Rt
New 6.00 PACCGM Und
BM #25
S.I.R. 26" App.
El 391.76
#25
0.95 Acre±
N 31°85' E
CLARENCE H. & KATHERINE HARTSHORN
meadow
brush
#22
0.81 Acre±
MAD RIVER
#24
0.49 Acre±
CLESSON E. & INA W. LAMB
Three Cable Guard Rail
with Steel Posts, Item 543
110+00 - 113+00 Rt
117+50 - 120+00 Rt
62 95
BM #24
S.I.R. 8" Elm
El 395.68
New 30" x 32' ACCGM-12-Pipe Culvert H.W.
Begin Channel Excavation
Item 106
Begin Clearing and Grubbing, Item 104
Stone Fill to Slope Protection
Item 601-C
End Clearing and Grubbing
Item 104
End Channel Excavation
Item 106
New 18" x 65' ACCGM-12-
MRS. CHRISTINE CRUICKSHANK
Control of section of old highway between
Sta. 120+13 (38.02 Lt) and Sta. 135+58 (43.02 Rt)
Relinquished to Town of Warren.
Recorded BK 15, Page 341, Land Records, Jan 28, 1955.
PLAN
SURVEYED
PLOTTED
NOTE BOOK
ALIGNMENT CHECKED
BRIDGE STRUCTURE CHECKED
NO.
TRACED
POSTER HOUSE
Junior
PROFILE
SURVEYED
PLOTTED
NOTE BOOK
BRIDGE STRUCTURE NO. CHKD.
NO.
Foster J. Bachman
Oct 19
112+00
400' V.C.
401.07
121+00
200' V.C.
390.36
old road profile
-4.810%
Gradient of underdrain
6' below Shoulder subgrade
-1.190%
old road profile
-0.551%
elev 385.4
High Water Elevation
Dec. 30, 1948
109+00 - 125+00
18" Base
420
410
400
390
380
BM #24 Sill 8" Elm 24" R.R. El. Sta 112+30 Elev 395.68
BM 25 24" Apple 52.5 ft Sta 117+95 Elev 392.76
WARREN
Project No 1571(6)
Sheet 24 of 135

10.