FED. ROAD DIST. NO.	STATE	PROJ. NO.	FISCAL YEAR	SHEET NO.	TOTAL SHEETS
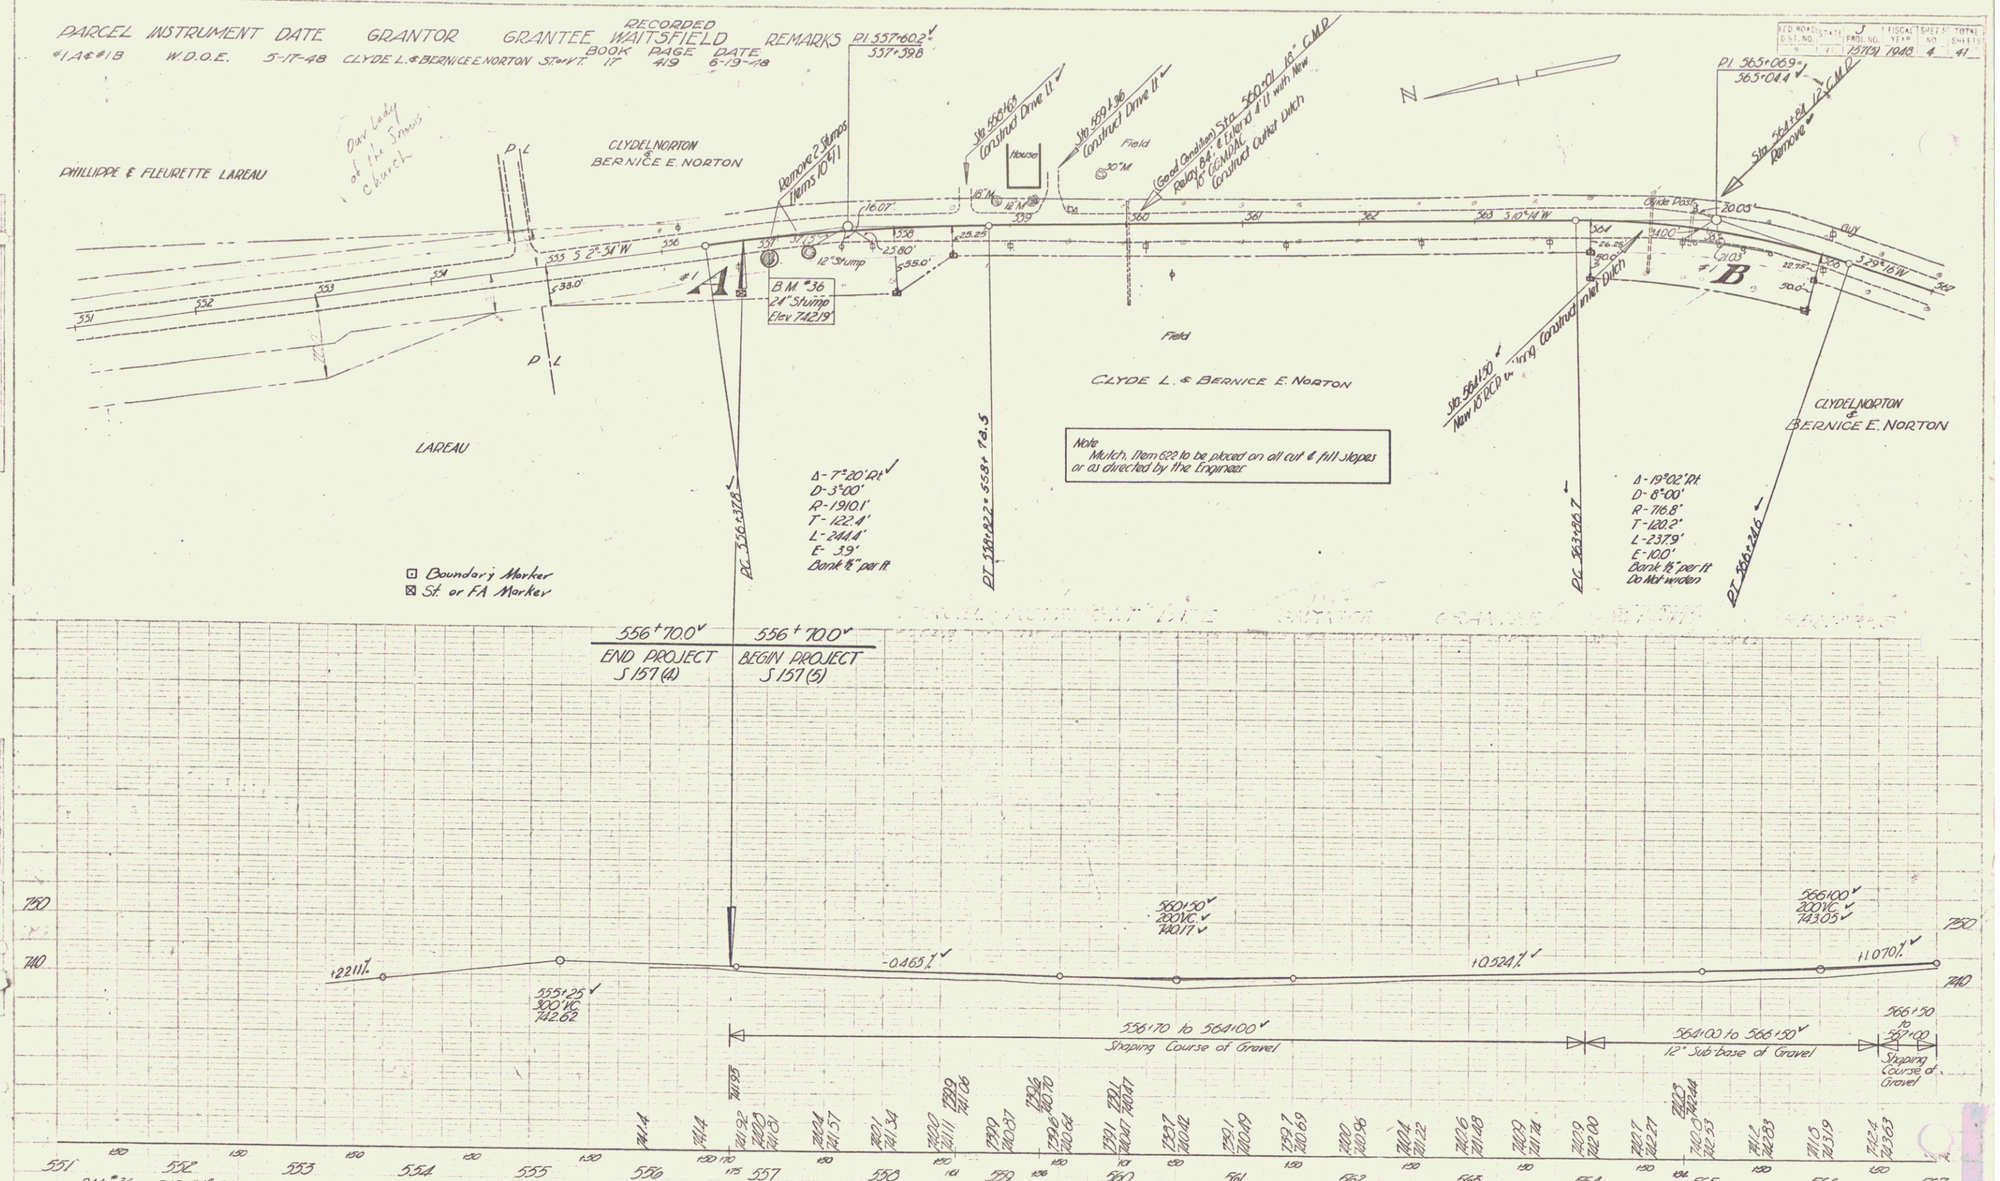
PARCEL #1A & #1B	INSTRUMENT W.D.O.E.	DATE 5-17-48	GRANTOR CLYDE L. & BERNICE E. NORTON	GRANTEE WAITSFIELD ST. of VT.	RECORDED BOOK 17	PAGE 419	DATE 6-19-48	REMARKS