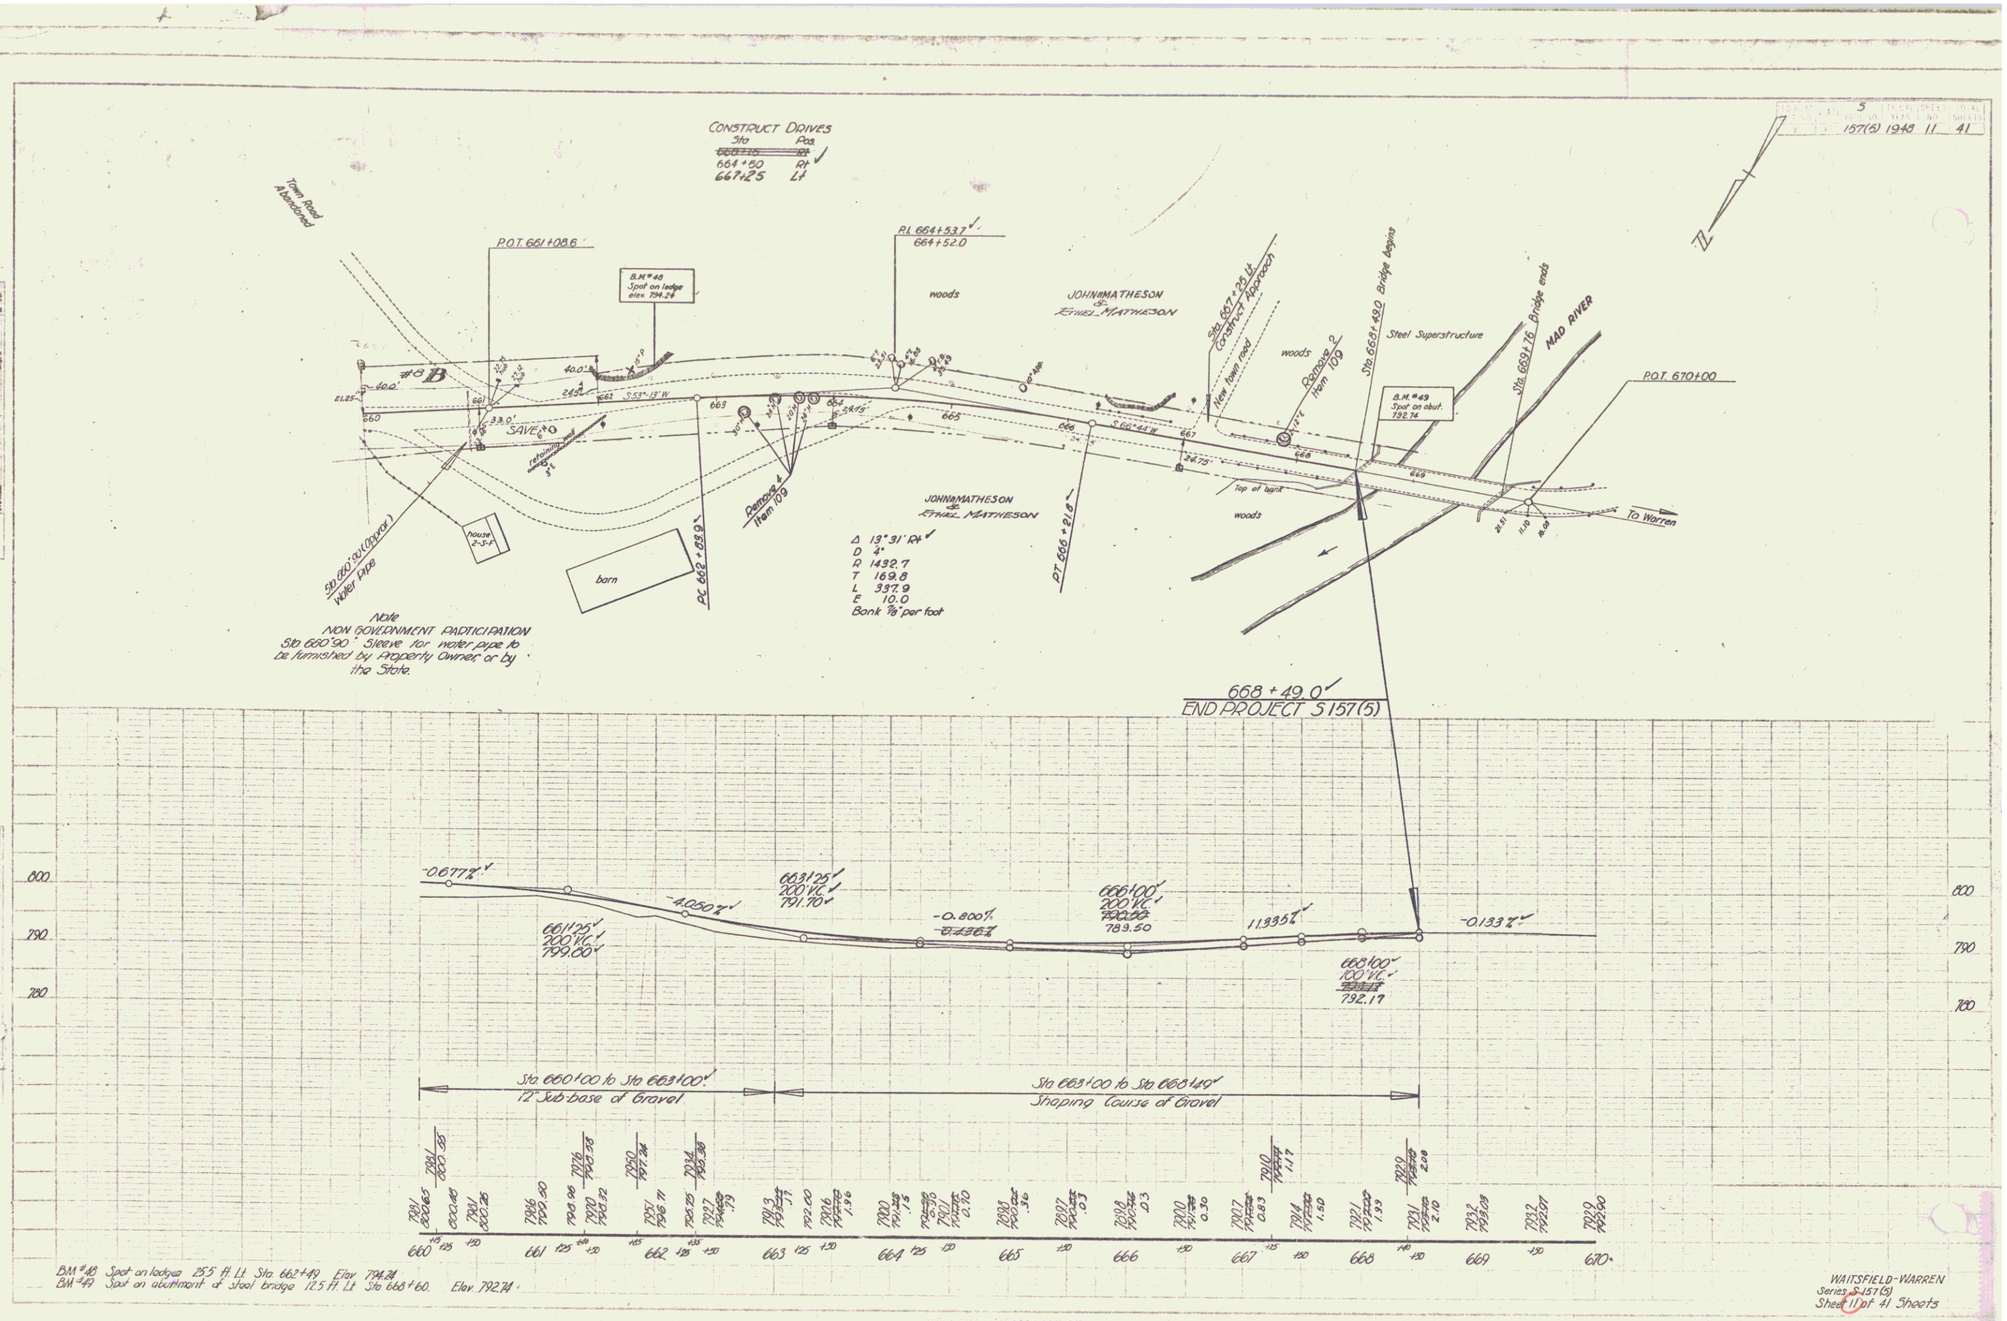
CONSTRUCT DRIVES
Sta Pos
664+50 Rt
667+25 Lt
Town Road Abandoned
P.O.T. 661+08.6
B.M. #48 Spot on ledge elev. 794.24
P.I. 664+53.7
664+52.0
woods
JOHN & MATHESON to ETHEL MATHESON
New town road
Removed 2 Ham 109
Steel Superstructure
Sta. 669+16 Bridge ends
MAD RIVER
P.O.T. 670+00
B.M. #49 Spot on abut. 792.74
SAVE
retaining wall
house 2-5-F
barn
Sta 660+90 Sleeve for water pipe
Removed 4 Ham 109
P.C. 662+88.9
Δ 13° 31' Rt
D 4°
R 1432.7
T 169.8
L 337.9
E 10.0
Bank 7% per foot
P.T. 666+21.8
Top of bank
To Warren
Note
NON GOVERNMENT PARTICIPATION
Sta 660+90 Sleeve for water pipe to be furnished by Property Owner, or by the State.
668+49.0
END PROJECT S 157(5)
-0.677%
-4.050%
-0.800%
1.993%
-0.133%
661+25 200 VC 799.00
663+25 200 VC 791.70
666+00 200 VC 789.50
668+00 100 VC 792.17
Sta 660+00 to Sta 663+00
12" Sub-base of Gravel
Sta 663+00 to Sta 668+49
Shaping Course of Gravel
BM #48 Spot on ledge 25.5 ft. Lt. Sta. 662+49 Elev. 794.24
BM #49 Spot on abutment of steel bridge 12.5 ft. Lt. Sta. 668+60. Elev. 792.74
WAITSFIELD-WARREN
Series S-157(5)
Sheet 11 of 41 Sheets
157(5) 1948 11 41