FED. ROAD DIST. NO.	STATE	PROJECT NO.	FISCAL YEAR	SHEET NO.	TOTAL SHEETS
5	VT	S157(9)	1947	8	43
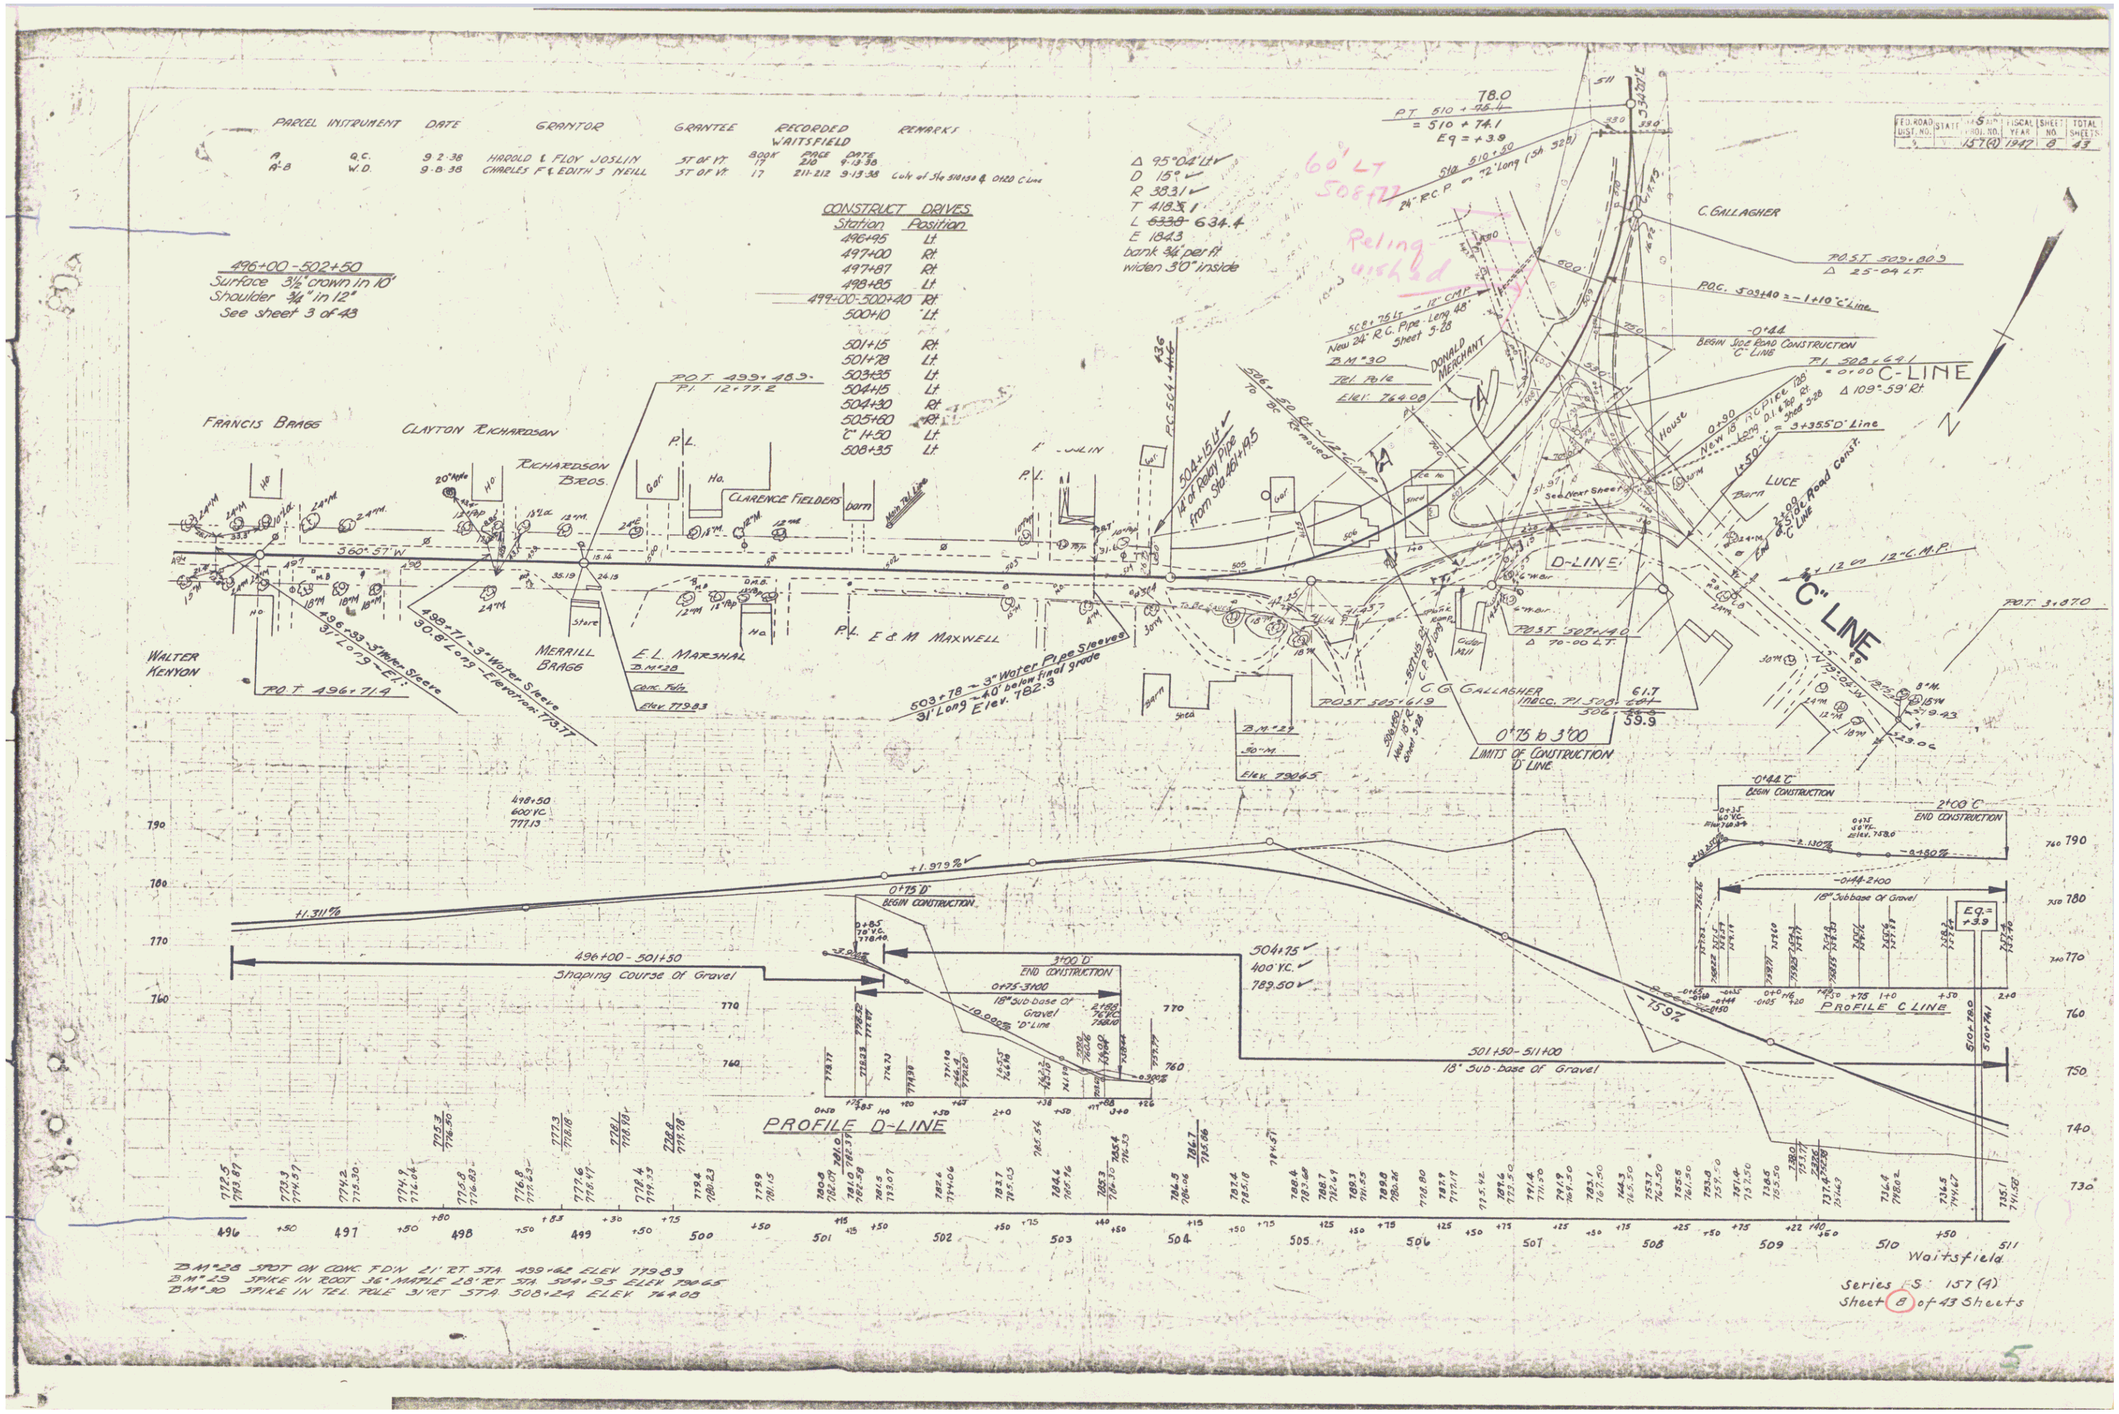
PARCEL	INSTRUMENT	DATE	GRANTOR	GRANTEE	RECORDED WAITSFIELD			REMARKS
					BOOK	PAGE	DATE	
A	Q.C.	9-2-38	HAROLD & FLOY JOSLIN	ST OF VT	17	210	9-13-38	
A-B	W.D.	9-8-38	CHARLES F & EDITH J NEILL	ST OF VT	17	211-212	9-13-38	Cuts of Sta 510+50 & 0+20 C Line