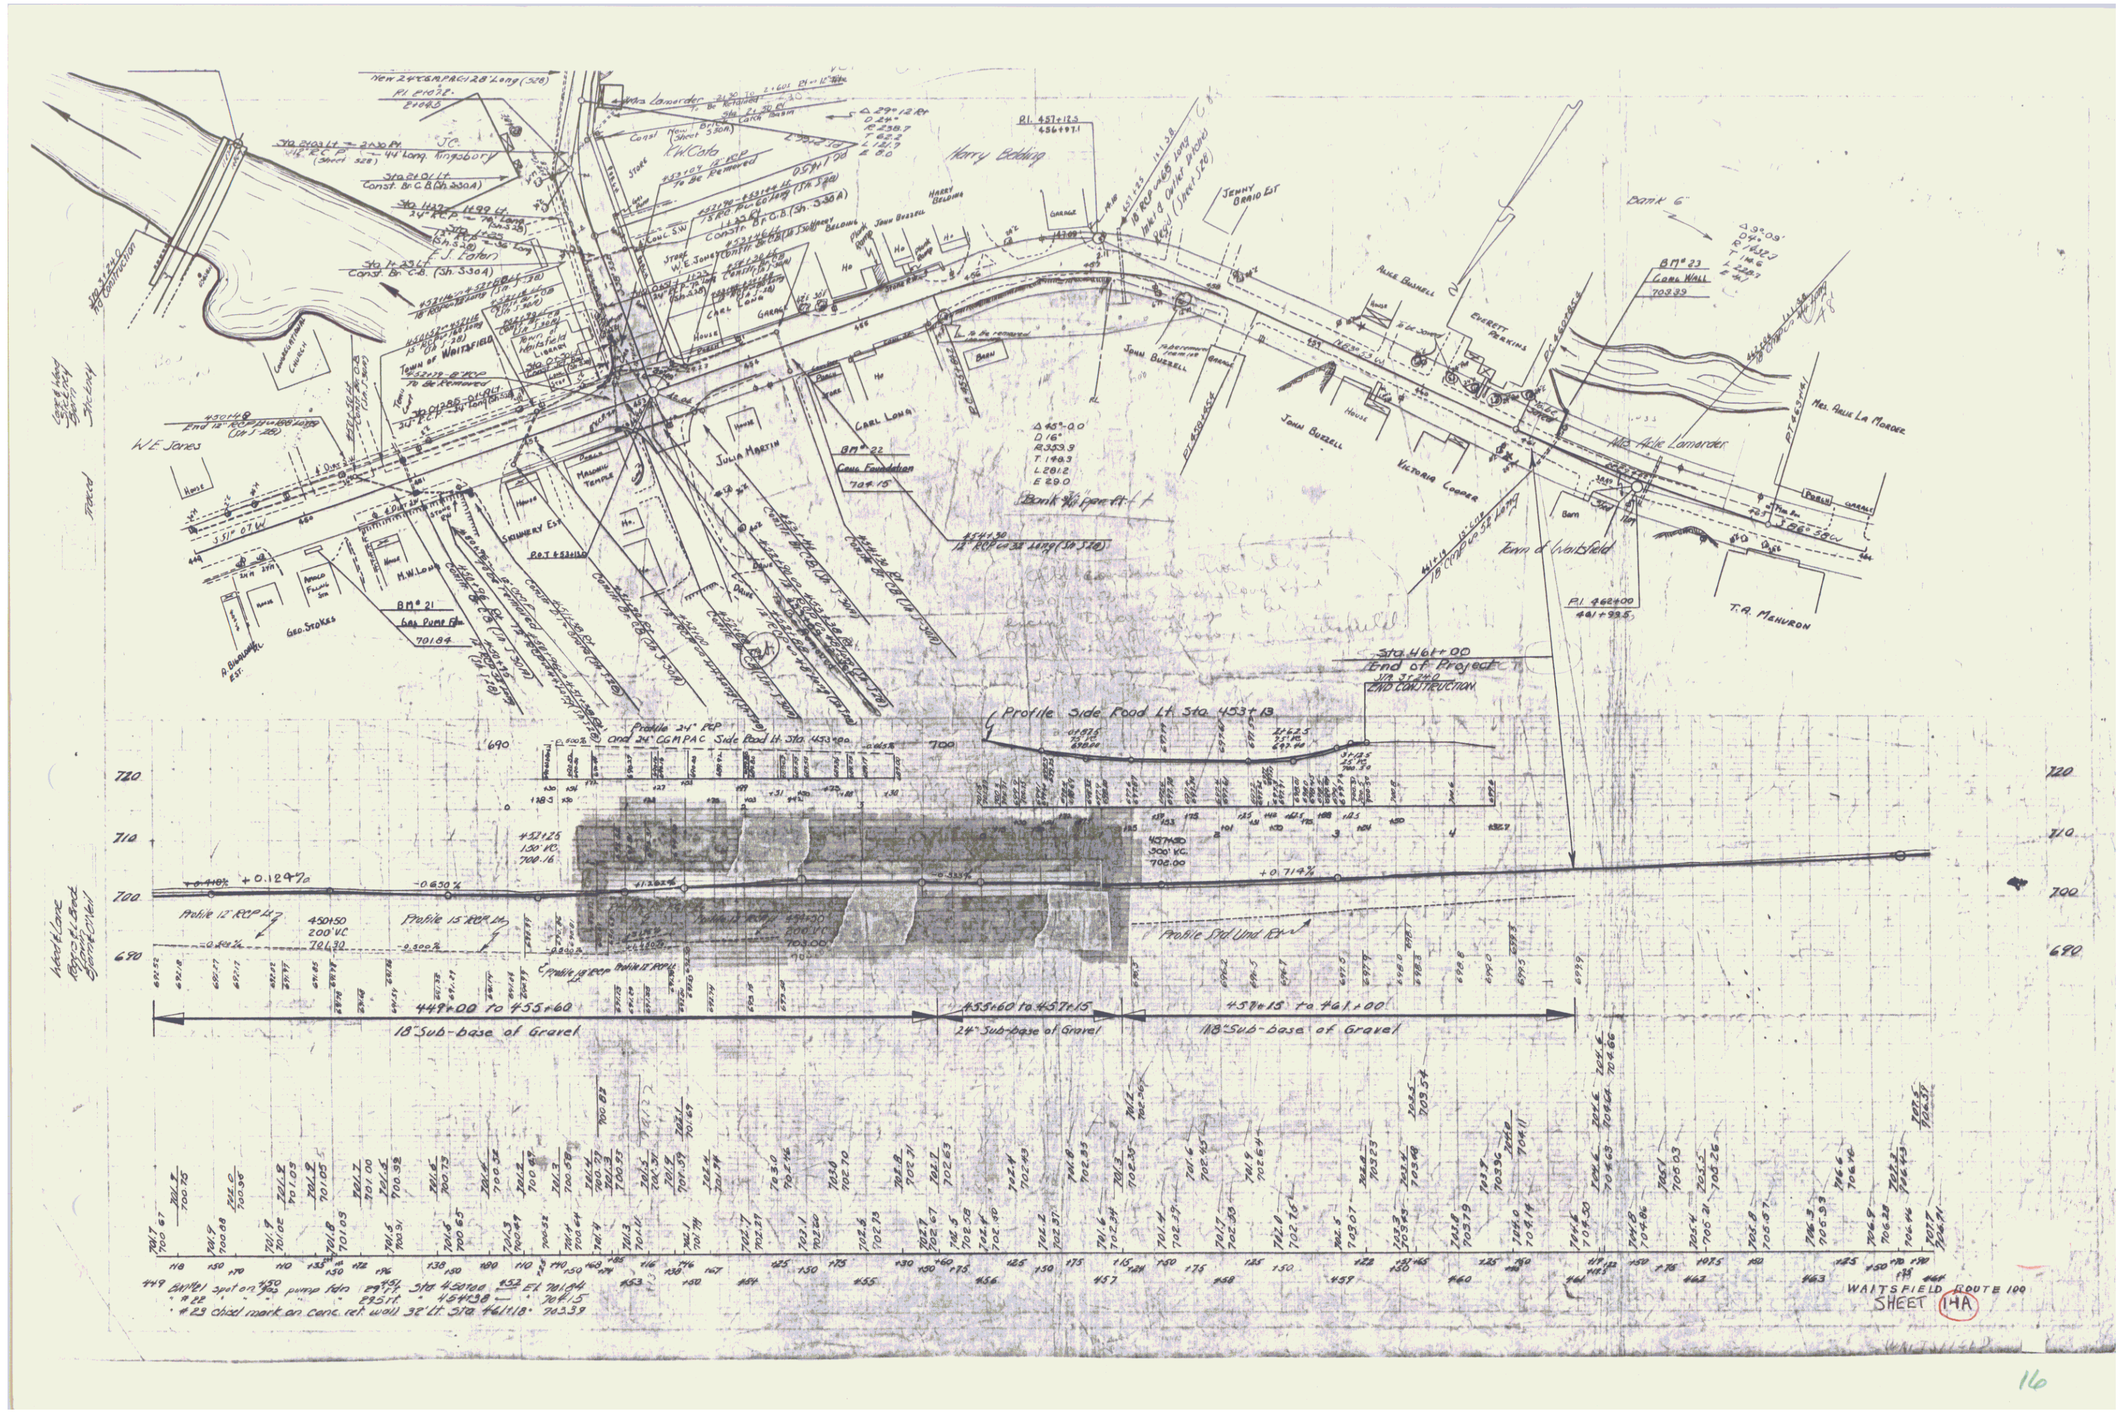
Profile Side Road Lt. Sta. 453+13
Profile 24" RCP and 24" CGMPAC Side Road Lt. Sta. 453+00
Profile 12" RCP Lt.
Profile 15" RCP Lt.
Profile 18" RCP Lt.
Profile 24" RCP Lt.
449+00 to 455+60
18" Sub-base of Gravel
455+60 to 457+15
24" Sub-base of Gravel
457+15 to 461+00
18" Sub-base of Gravel
Sta. 461+00
End of Project
Town of Waitsfield
Mad River
Mrs. Alice La Morder
T.A. Menuron
Victoria Cooper
John Russell
Julia Martin
Masonic Temple
Geo. Stokes
H.W. Lowe
W.E. Jones
Harry Belding
Jenny Orrio Est.
Alice Brownell
Everett Perkins
Carl Lowe
Bank 6
BM # 23
Curb Wall
703.39
BM # 22
Conc. Foundation
704.15
BM # 21
Log Pump Hdn.
701.84
WAITSFIELD ROUTE 100
SHEET 14A