PARCEL	INSTRUMENT	DATE	GRANTOR	GRANTEE	RECORDED WAITSFIELD BOOK	PAGE	DATE	REMARKS
A	W DOE	5-22-60	CARL LONG	ST OF VT	17	272-3	7-8-60	

F.A.S.
157C(1) 1941 16 84
WAITSFIELD

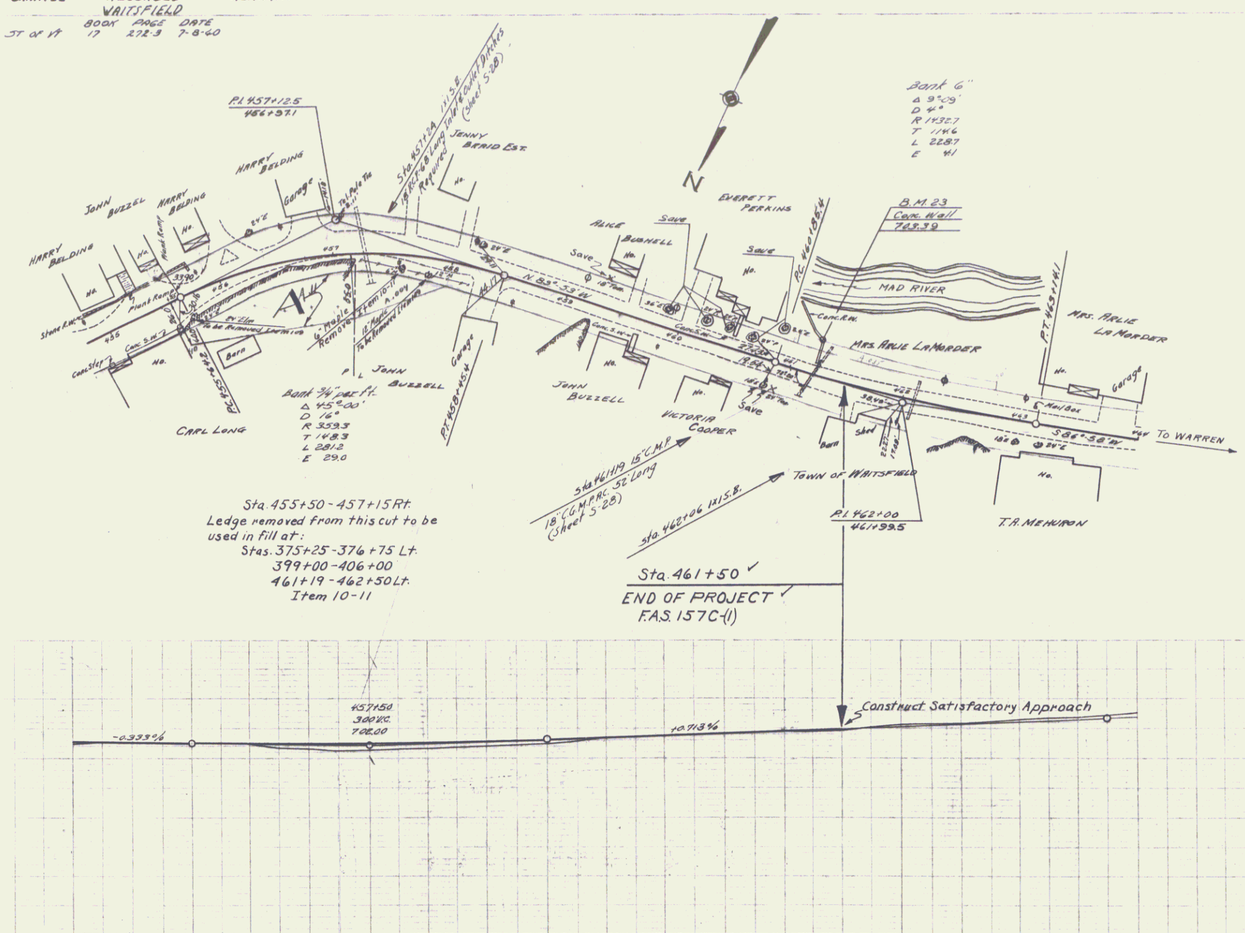

B.M. #23 Chisel Mark on Conc. Ret. Wall 32' Lt. Sta. 461+18 Elev. 708.39

WAITSFIELD
SERIES F.A.S. NO. 157C(1)
SHEET 16 OF 84