




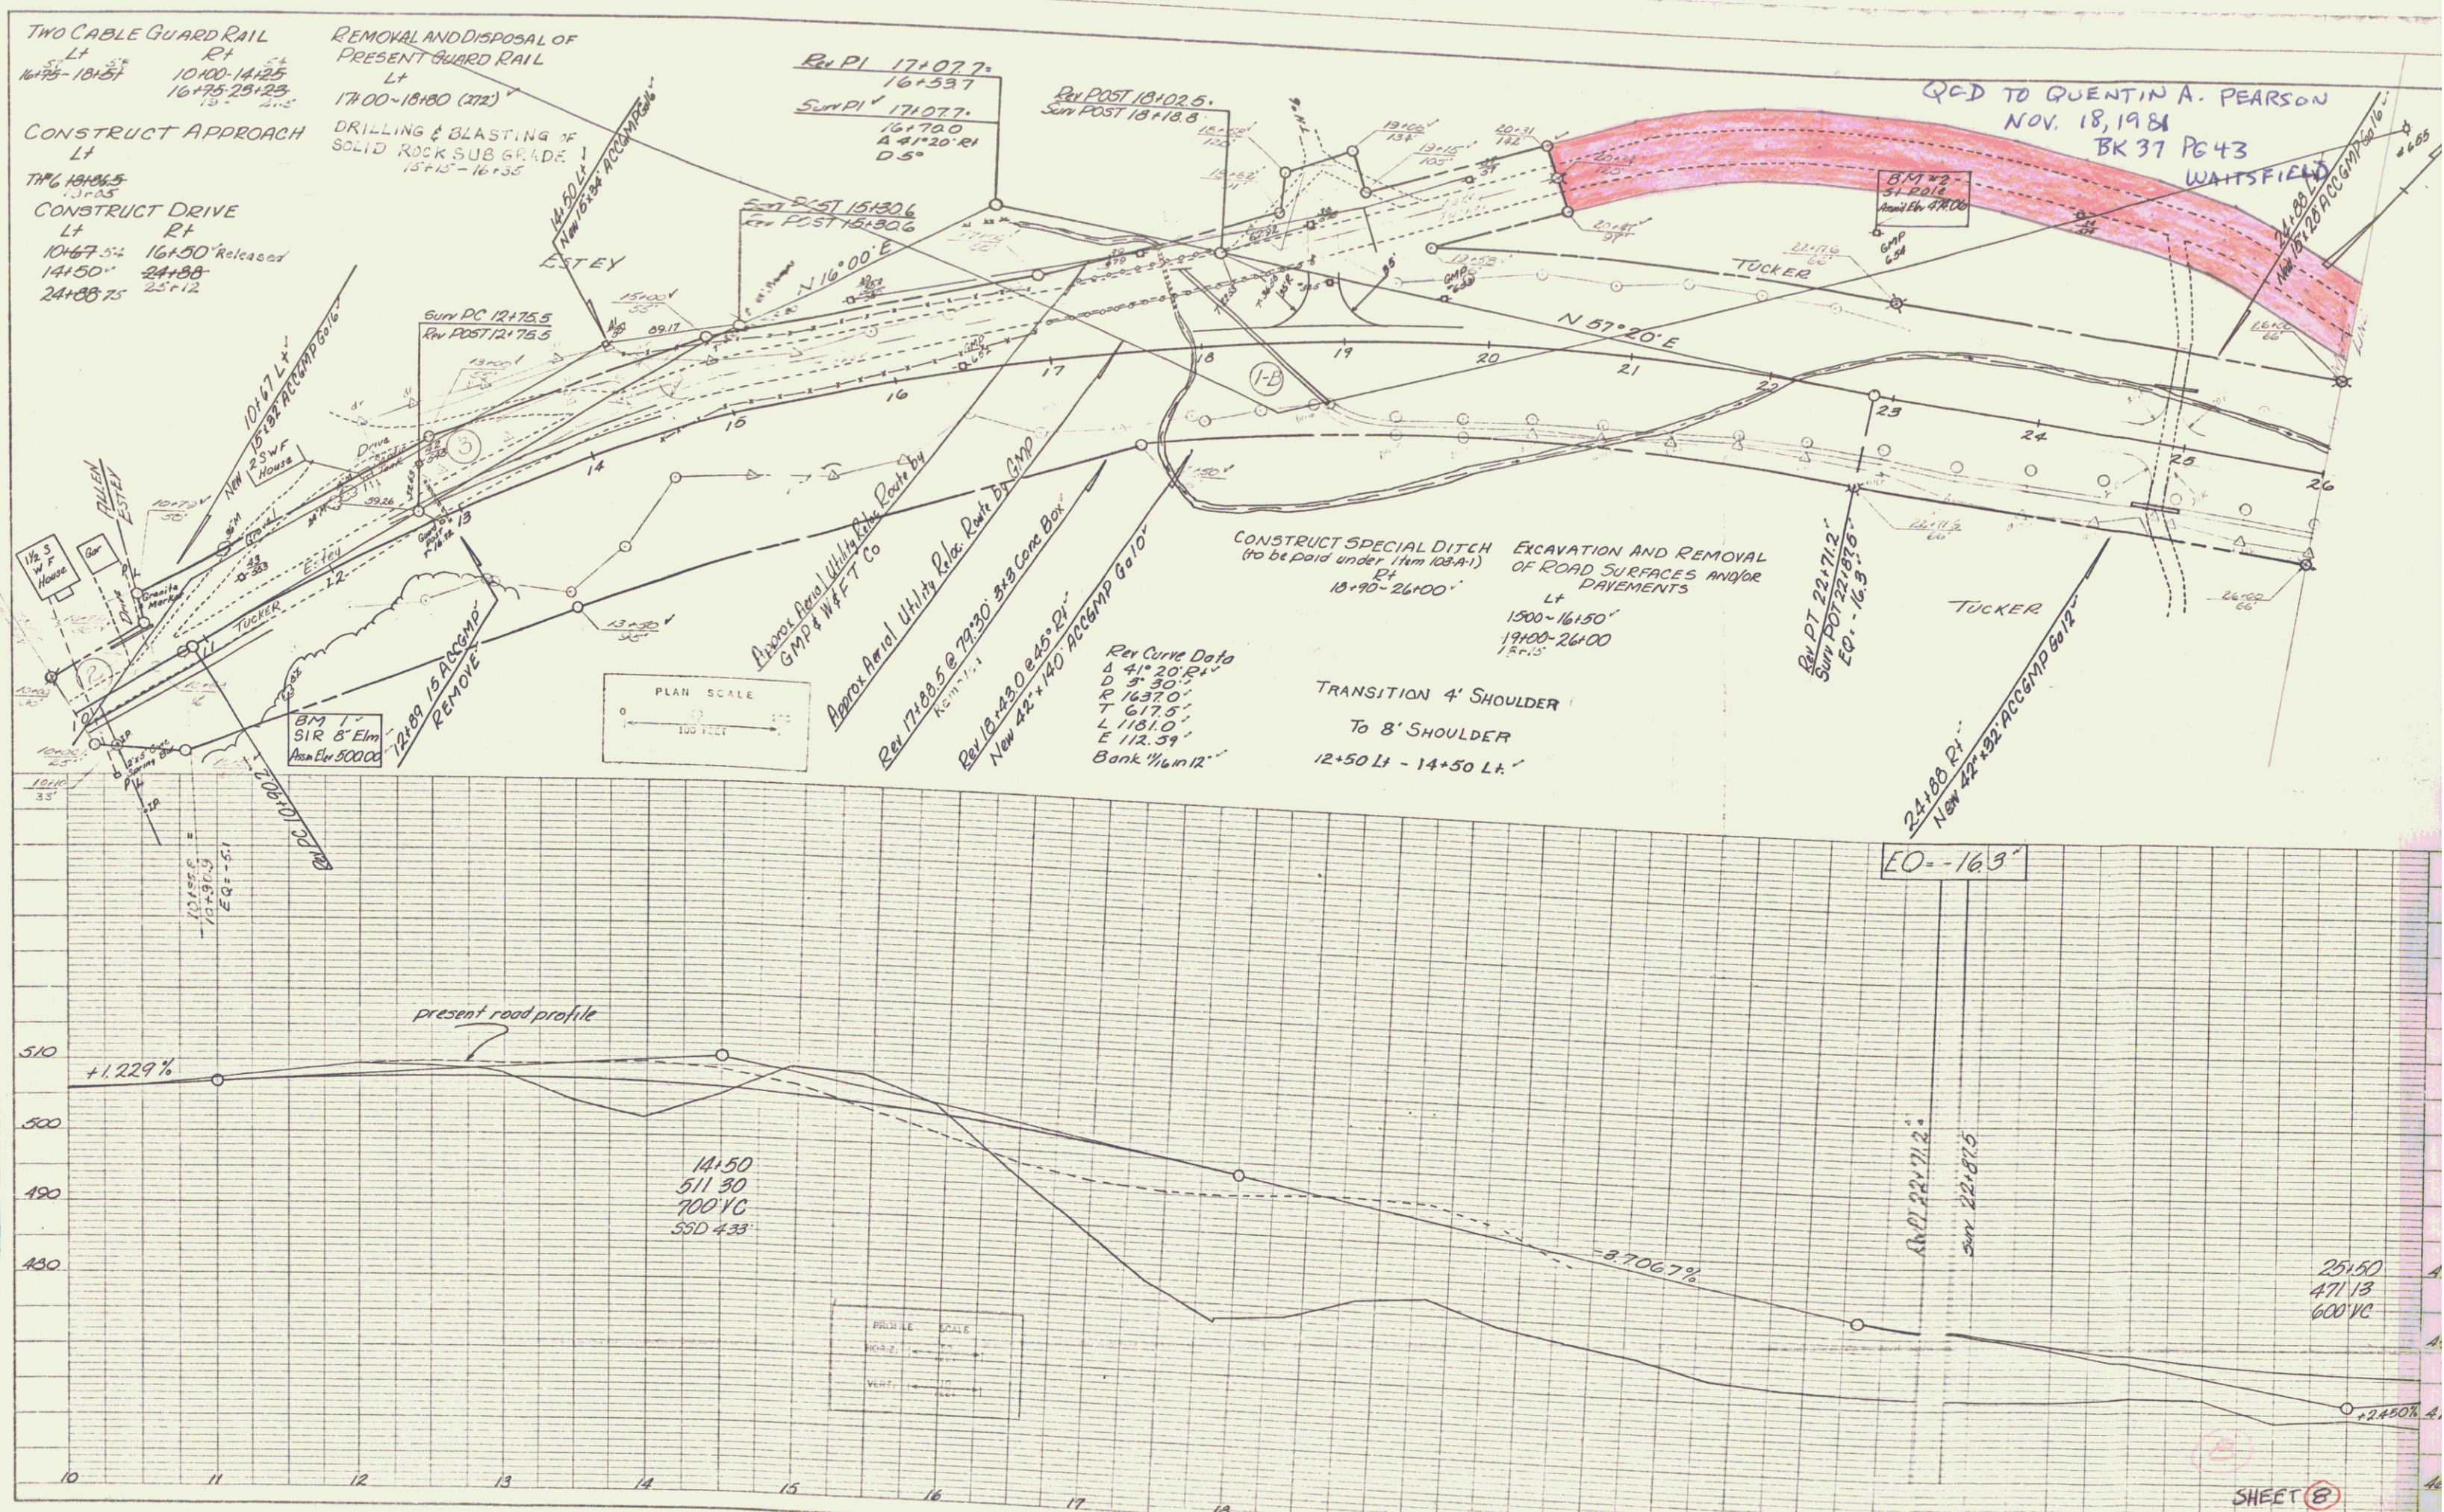

QCD TO QUENTIN A. PEARSON
 NOV. 18, 1981
 BK 37 PG 43