


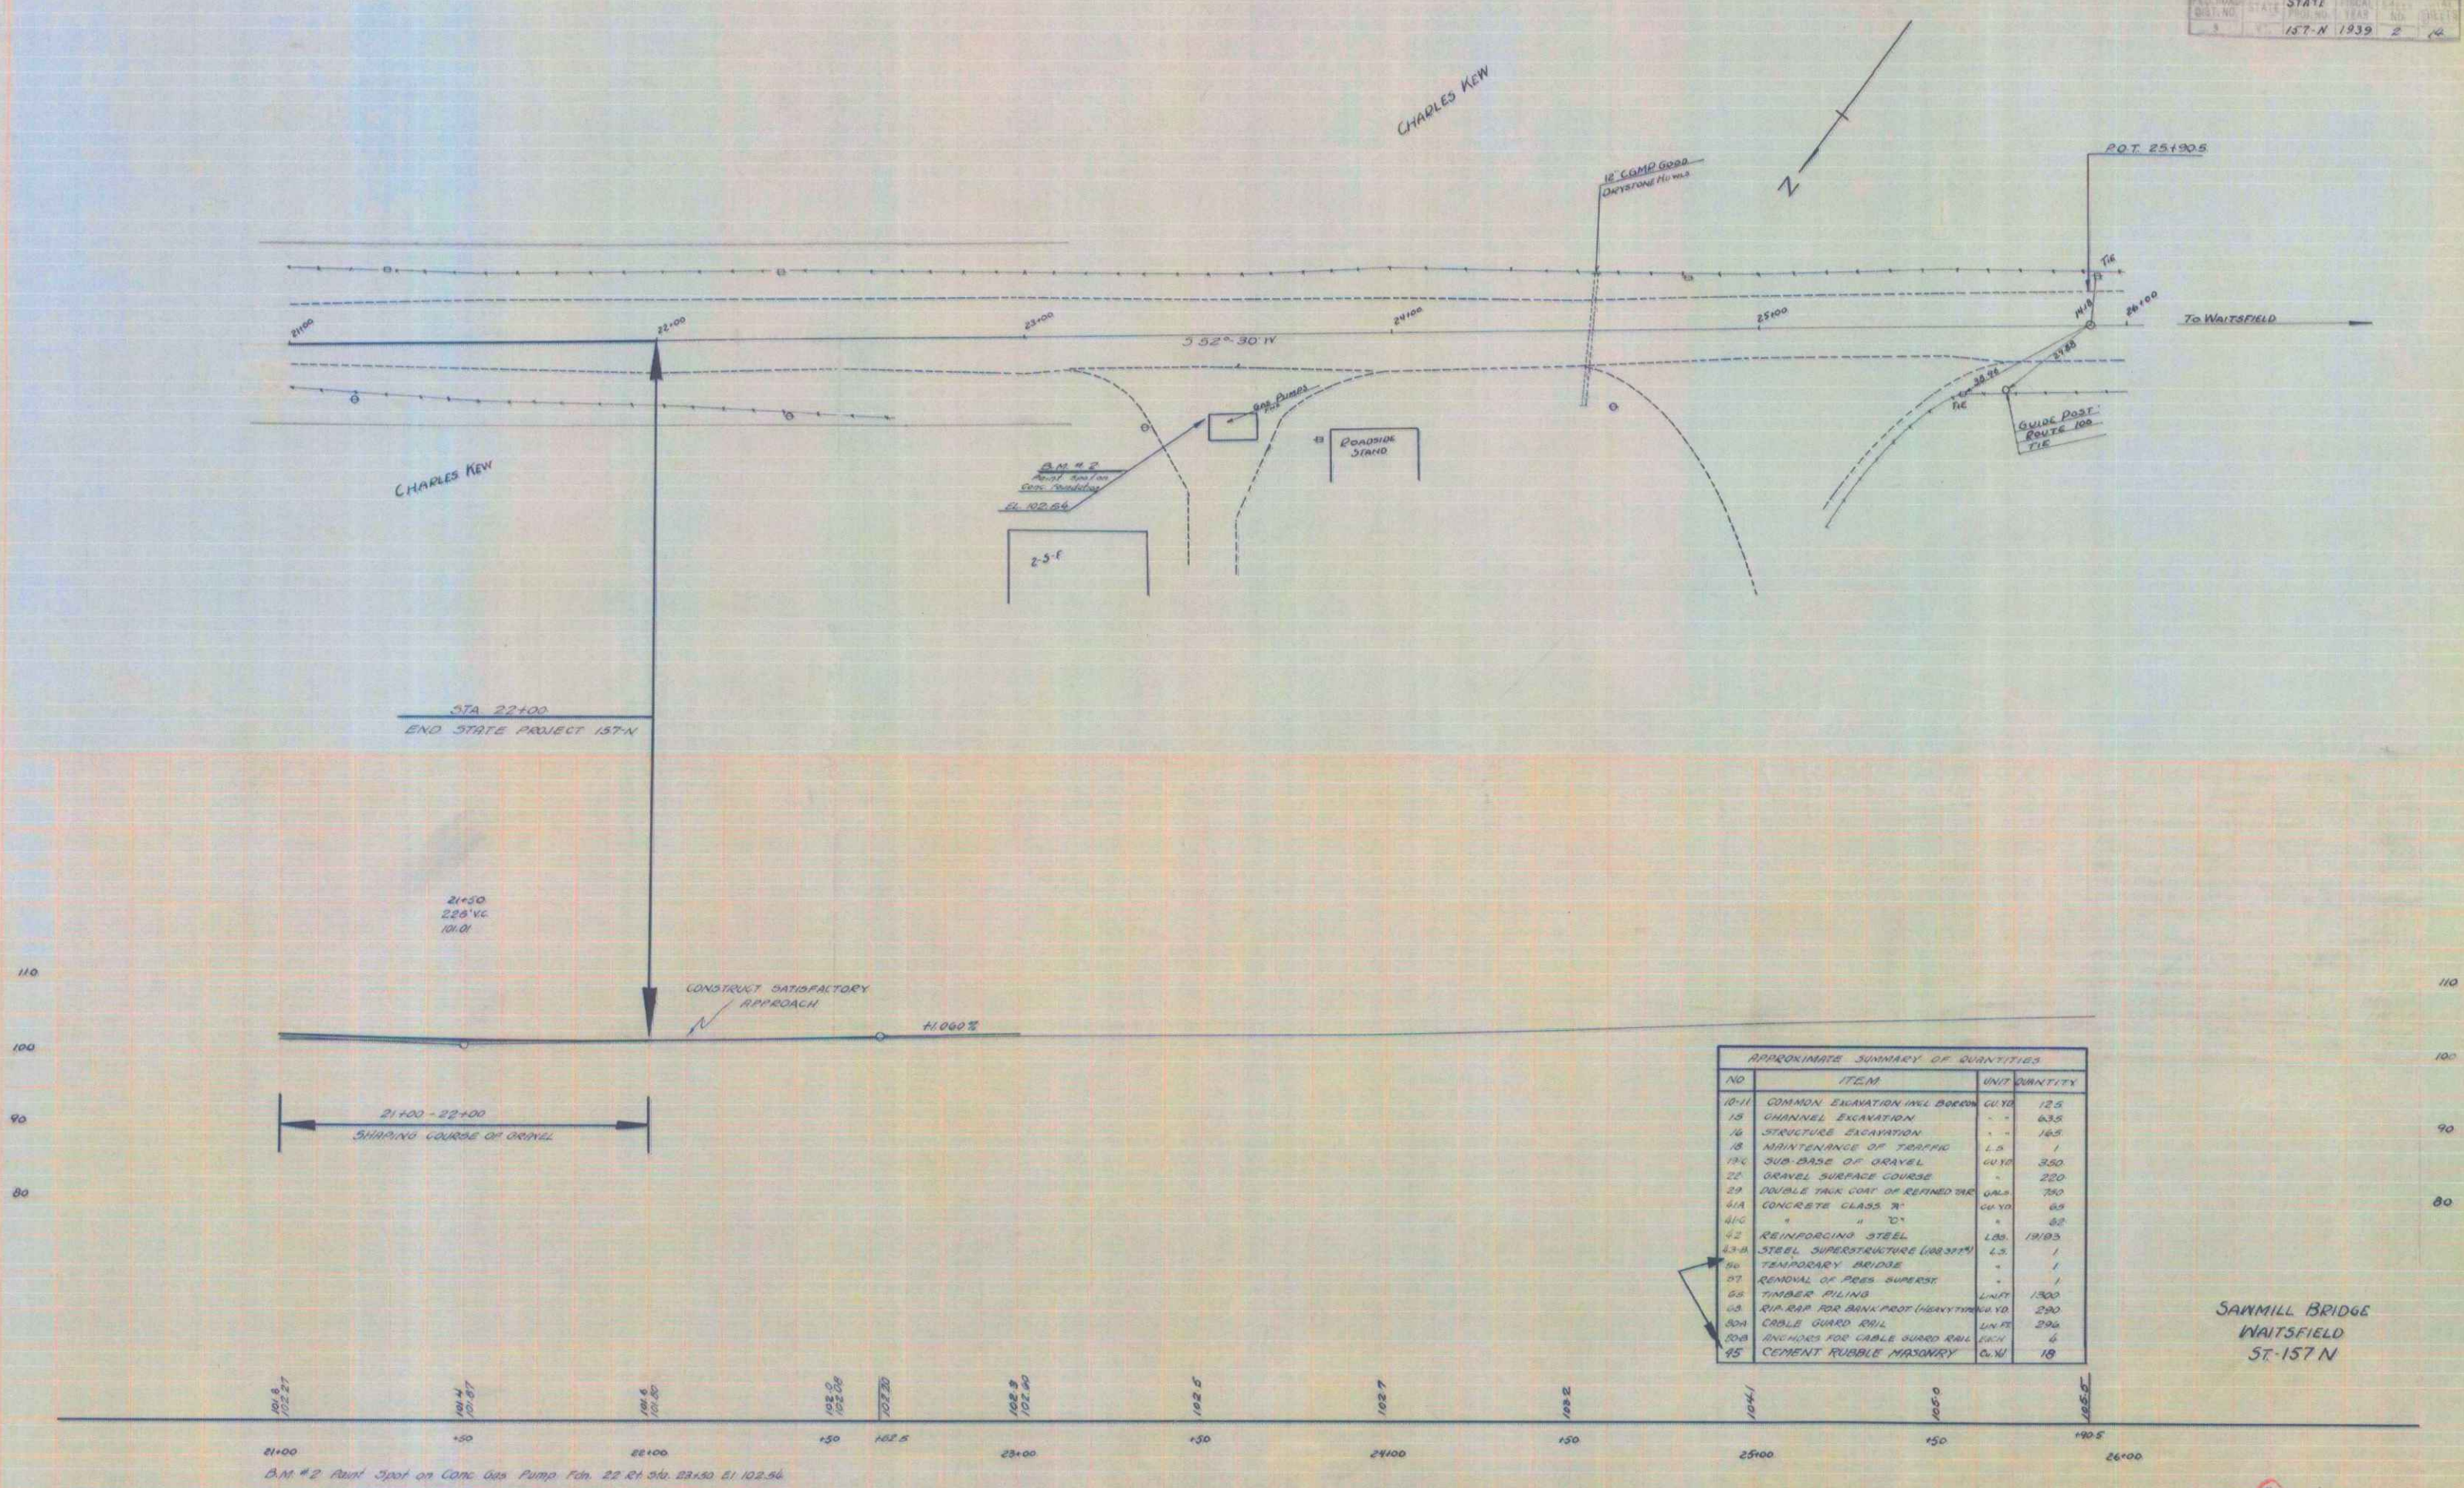

APPROXIMATE SUMMARY OF QUANTITIES

NO	ITEM	UNIT	QUANTITY

Sawmill Bridge
Waitfield
ST-157 N