Wood Guide Posts
Lt.
4 162+50 (Approach)

Two Cable Guard Rail
Lt. Rt.
160+47-161+53
168+50-172+00
160+47-161+50

Construct Approach
Lt. Rt.
163+00

Construct Drives
Lt. Rt.
166+30
163+50
163+10

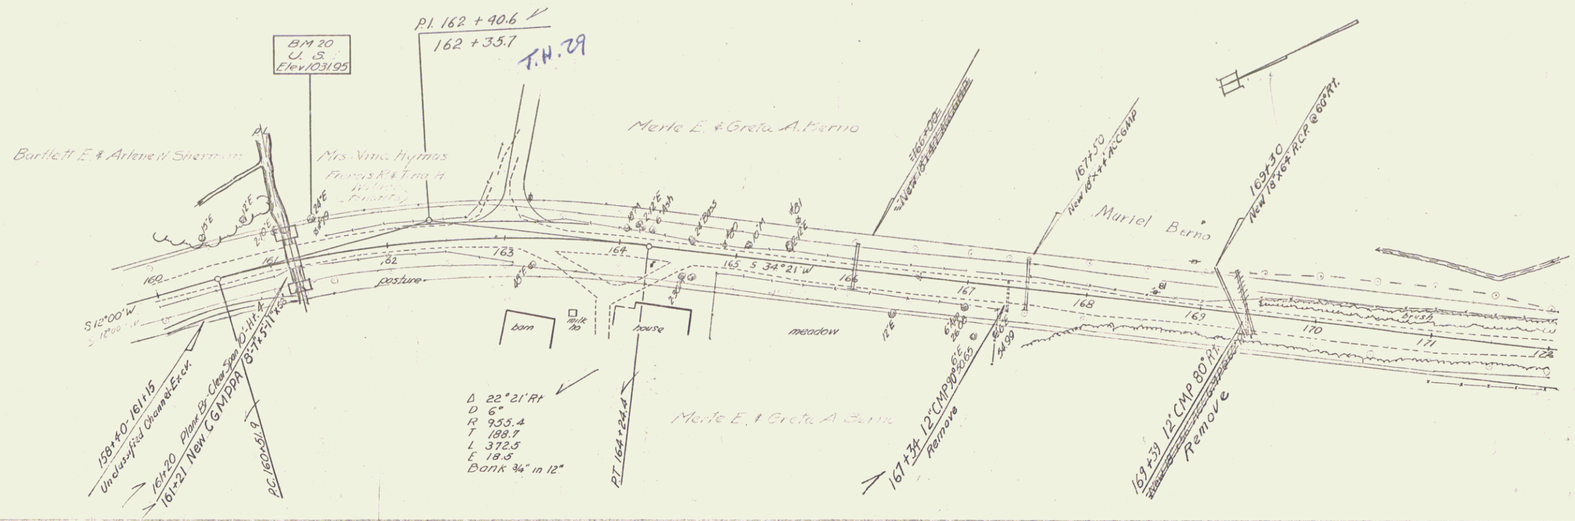

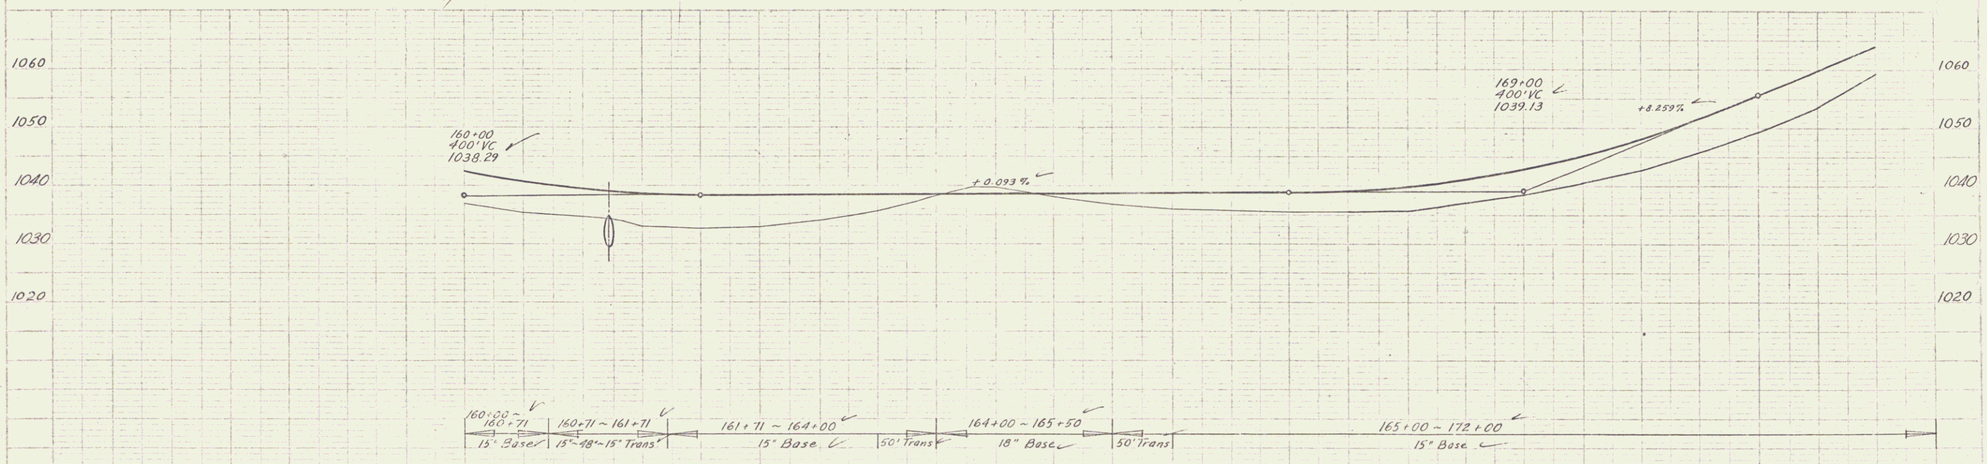

B.M. #20. S.I.P. 24" Elm 37 ft Lt Sta 161+39 Elev 1031.95

DUBURY (1931)
Proj. 3-38
Sheet 18 of 43

6