	Wood Guide Post	Rt
	36+50	1
5	47+84	1
	49+87	1
	36+20	2
13	39+33	3
6	41+50	

	Two Cable Guard Rail	Rt
	~~41+50 – 52+00~~	
72'	49+35 – 50+27	
144'	49+35 – 50+39	
50'	51+50 – 52+00	

CONSTRUCT DRIVE
44+30 Rt.
51+20 Rt.
51+20 Lt.

Construct Approaches
40+00 Rt.
~~51+20 Rt~~

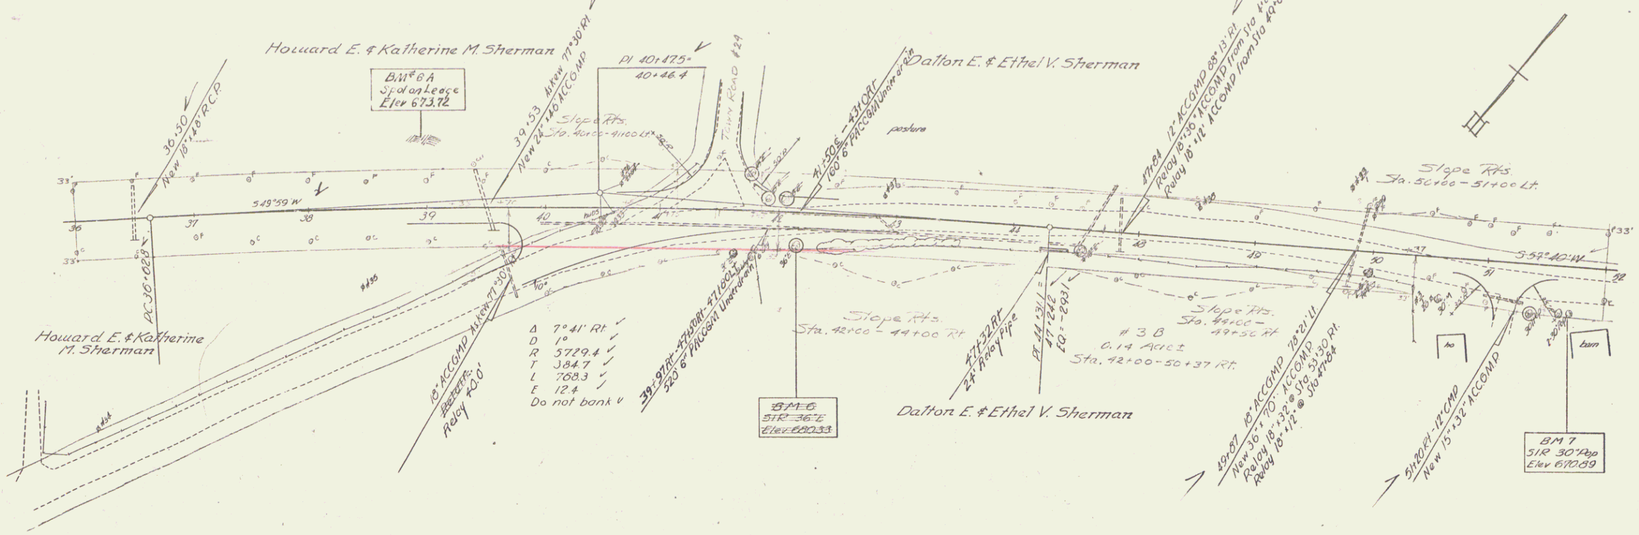

5