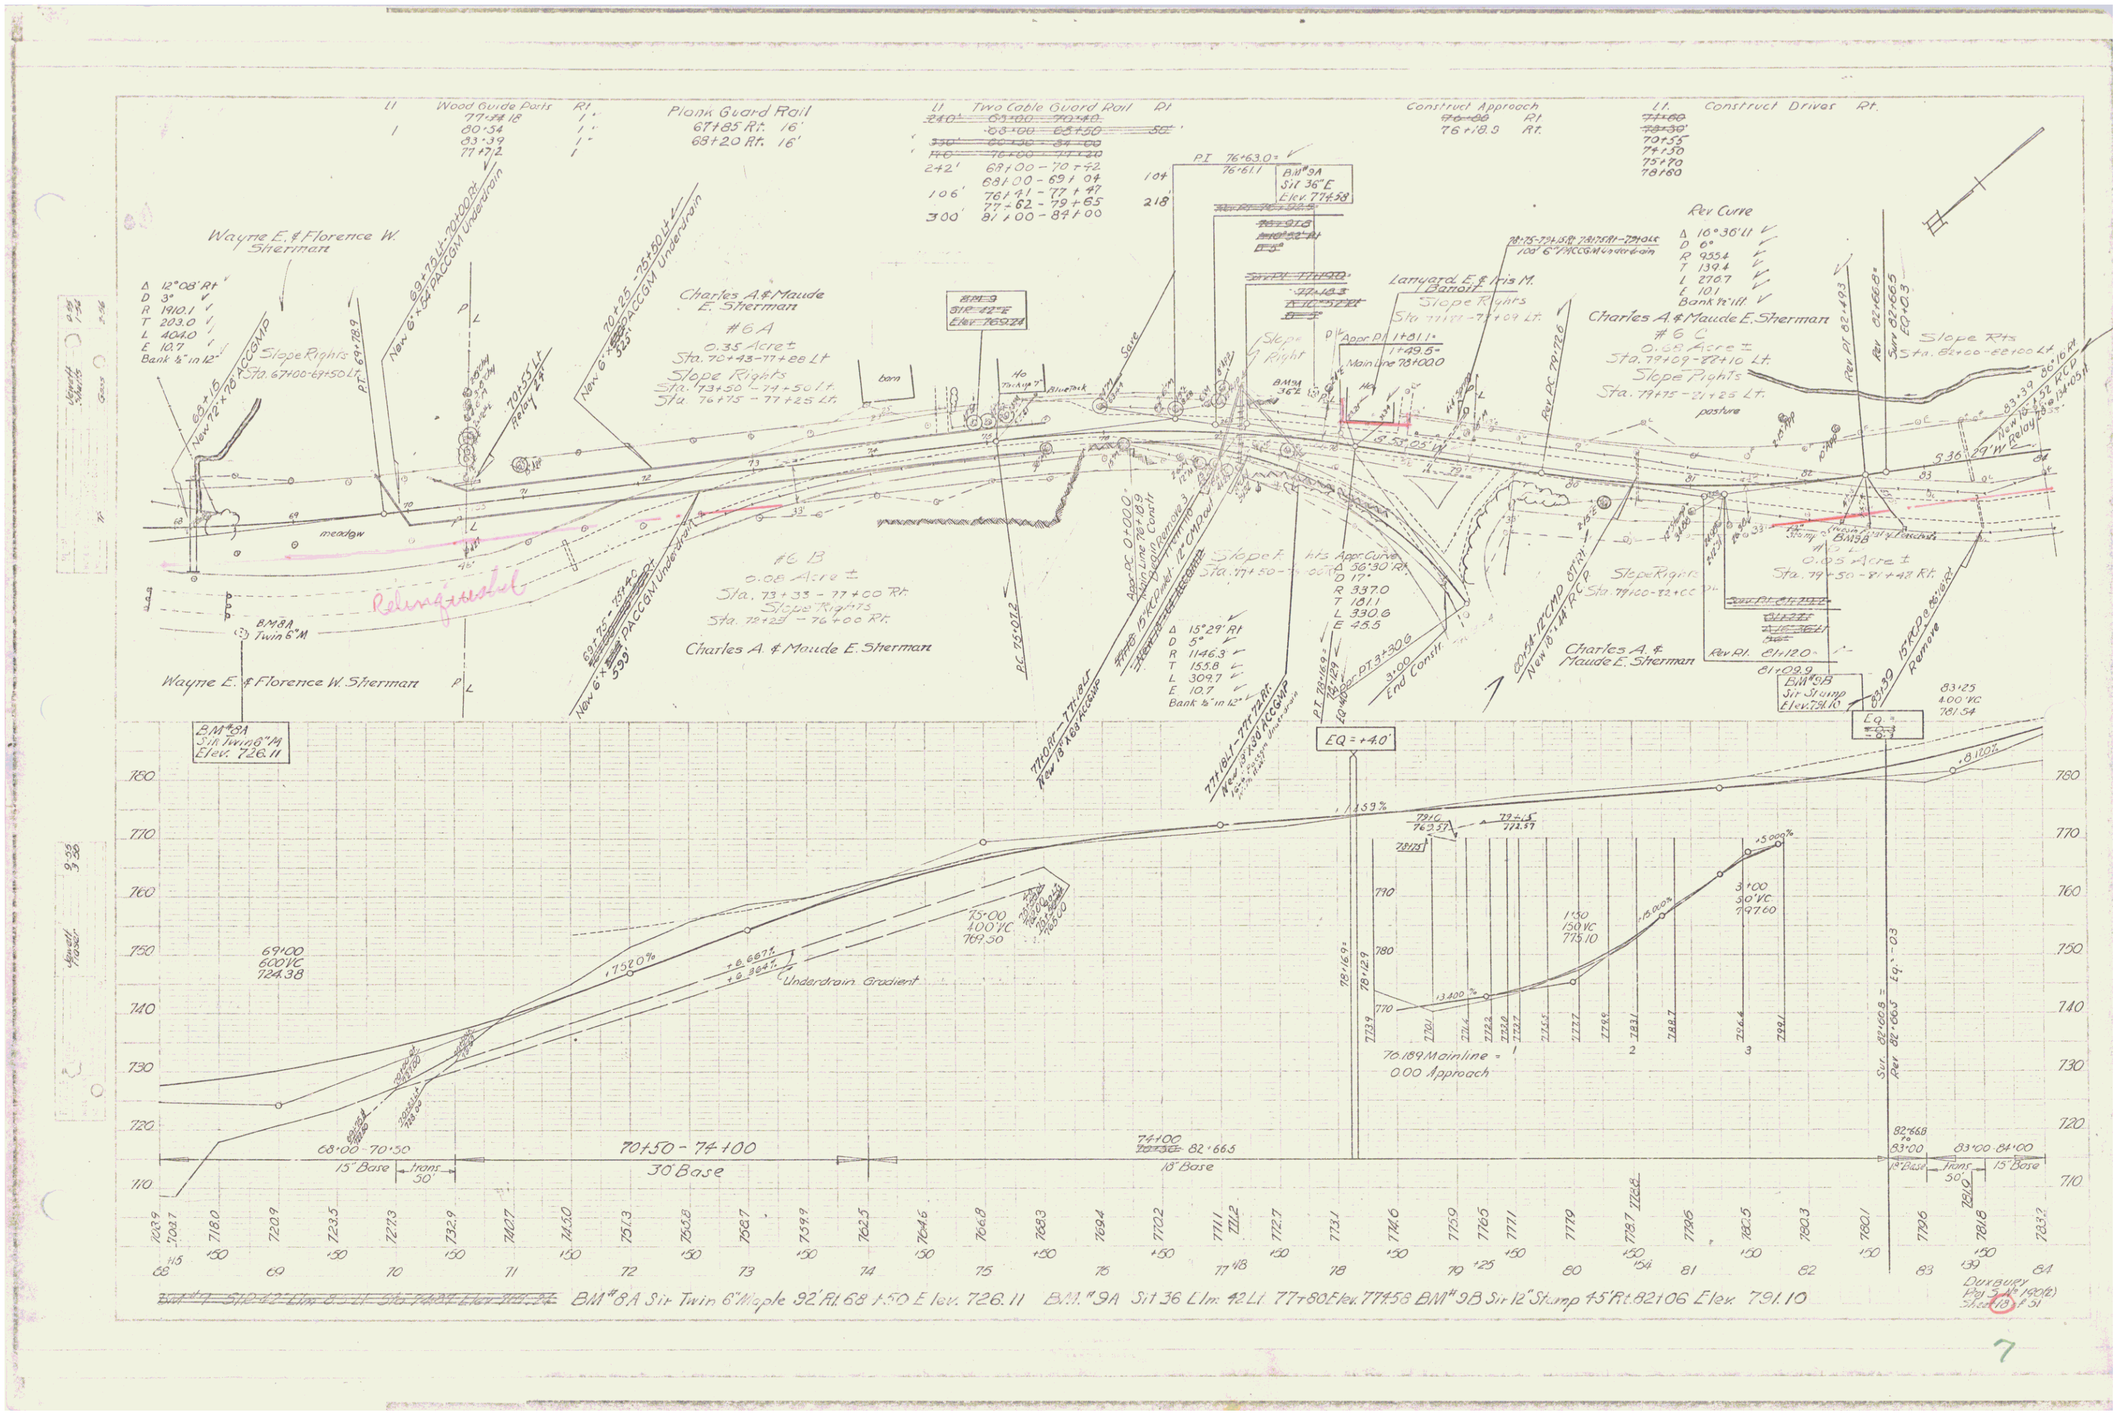
Wood Guide Posts
Plank Guard Rail
Two Cable Guard Rail
Construct Approach
Construct Drives
Wayne E. & Florence W. Sherman
Charles A. & Maude E. Sherman
#6A
0.35 Acre ±
Slope Rights
#6B
0.08 Acre ±
#6C
0.05 Acre ±
Lanyard, E. & Iris M. Daniel
Slope Rights
Rev Curve
Relinquished
Remove
Undardrain Gradient
70+189 Mainline =
0.00 Approach
68+00 - 70+50
15' Base
70+50 - 74+100
30' Base
74+100 - 82+66.5
18' Base
82+66.8 to 83+00
18' Base
83+00 - 84+00
15' Base
BM #8A Sit Twin 6" Maple 92' Rt. 68 1.50 Elev. 726.11
BM #9A Sit 36 Lin. 42 Lt. 77+80 Elev. 77.58
BM #9B Sit 12" Stump 45' Rt. 82+06 Elev. 791.10
Duxbury
Proj. 3-H-190(12)
Sheet 13 of 31

7