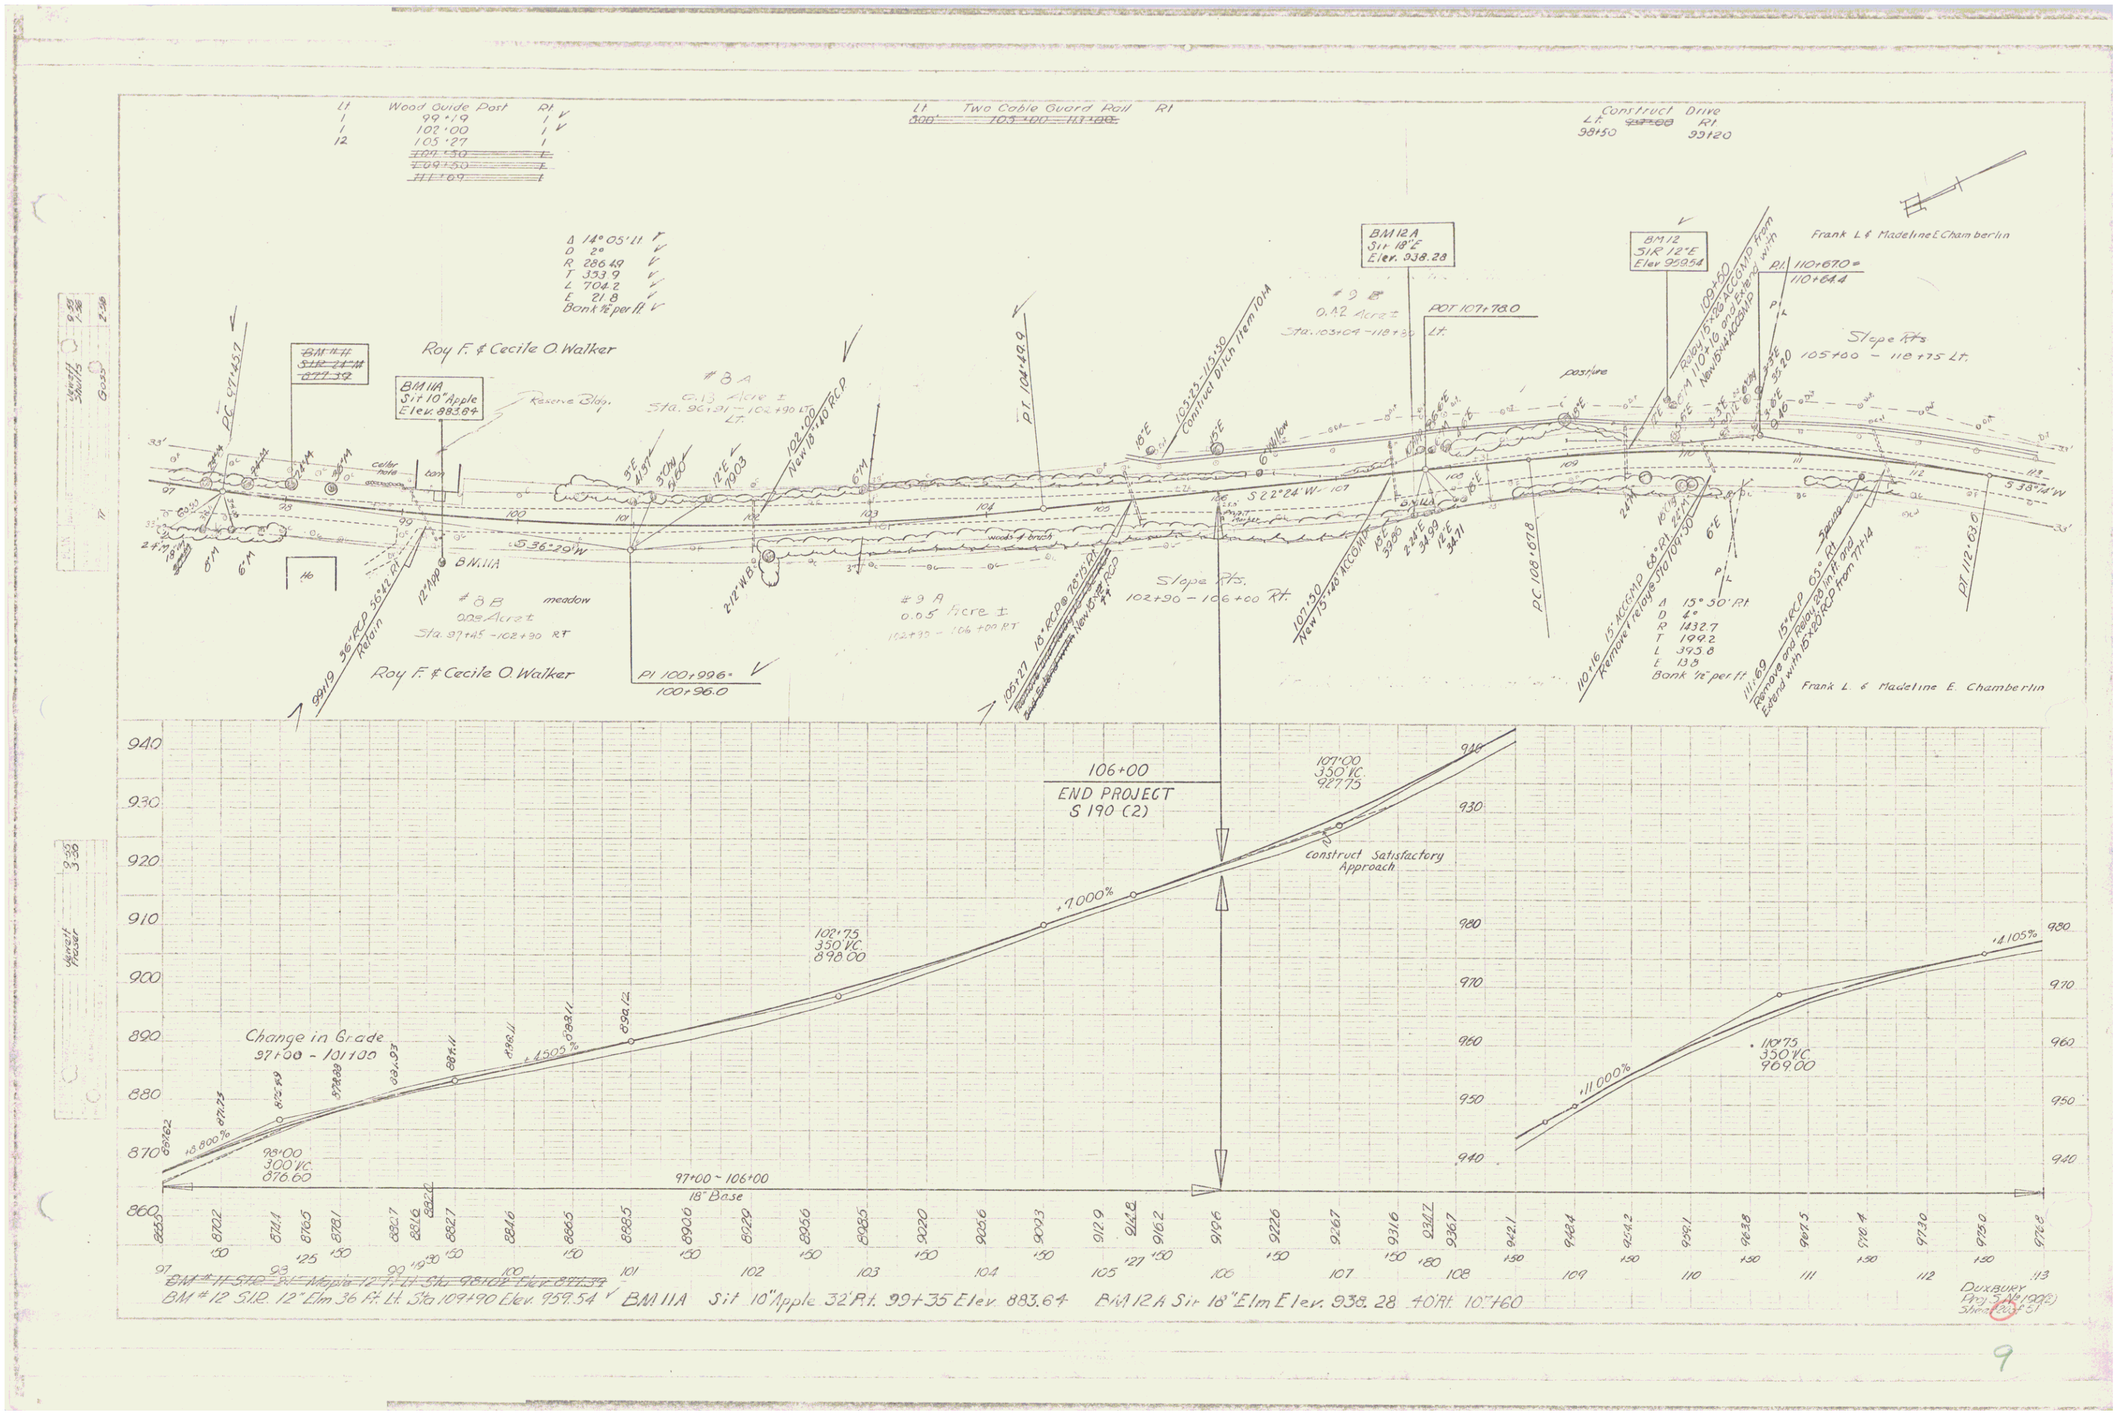
Wood Guide Post
Two Cable Guard Rail
Construct Drive
Δ 14° 05' 11"
D 2°
R 286.49
E 2.1.8
Bank ½" per ft
Roy F. & Cecile O. Walker
BM 11A
Sit 10" Apple
Elev. 883.64
Reserve Bldg.
#8A
0.13 Acre ±
Sta. 96+31 – 102+90 Lt.
Contract Ditch Item 10M
BM 12A
Sit 18" E
Elev. 938.28
#9B
0.42 Acre ±
Sta. 103+04 – 118+35 Lt.
POT 107+78.0
BM 12
Sit 12" E
Elev. 959.54
Frank L. & Madeline E. Chamberlin
Slope Rts.
105+00 – 118+75 Lt.
pasture
meadow
#8B
0.02 Acre ±
Sta. 97+45 – 102+90 Rt
#9A
0.05 Acre ±
102+90 – 106+00 Rt.
Slope Rts.
102+90 – 106+00 Rt.
PI 100+99.6
100+96.0
PI 104+89.9
PC 108+67.8
PI 112+63.0
Δ 15° 50' Rt
D 4°
R 1432.7
T 199.2
L 395.8
E 13.3
Bank ½" per ft.
106+00
END PROJECT
S 190 (2)
Construct Satisfactory Approach
Change in Grade
97+00 – 101+00
97+00 – 106+00
18" Base
BM #12 Sit. 12" Elm 36 Ft. Lt. Sta. 109+90 Elev. 959.54
BM 11A Sit 10" Apple 32' Rt. 99+35 Elev. 883.64
BM 12A Sit 18" Elm Elev. 938.28 40 Rt. 107+60
Duxbury
Sheet 20 of 57

9