
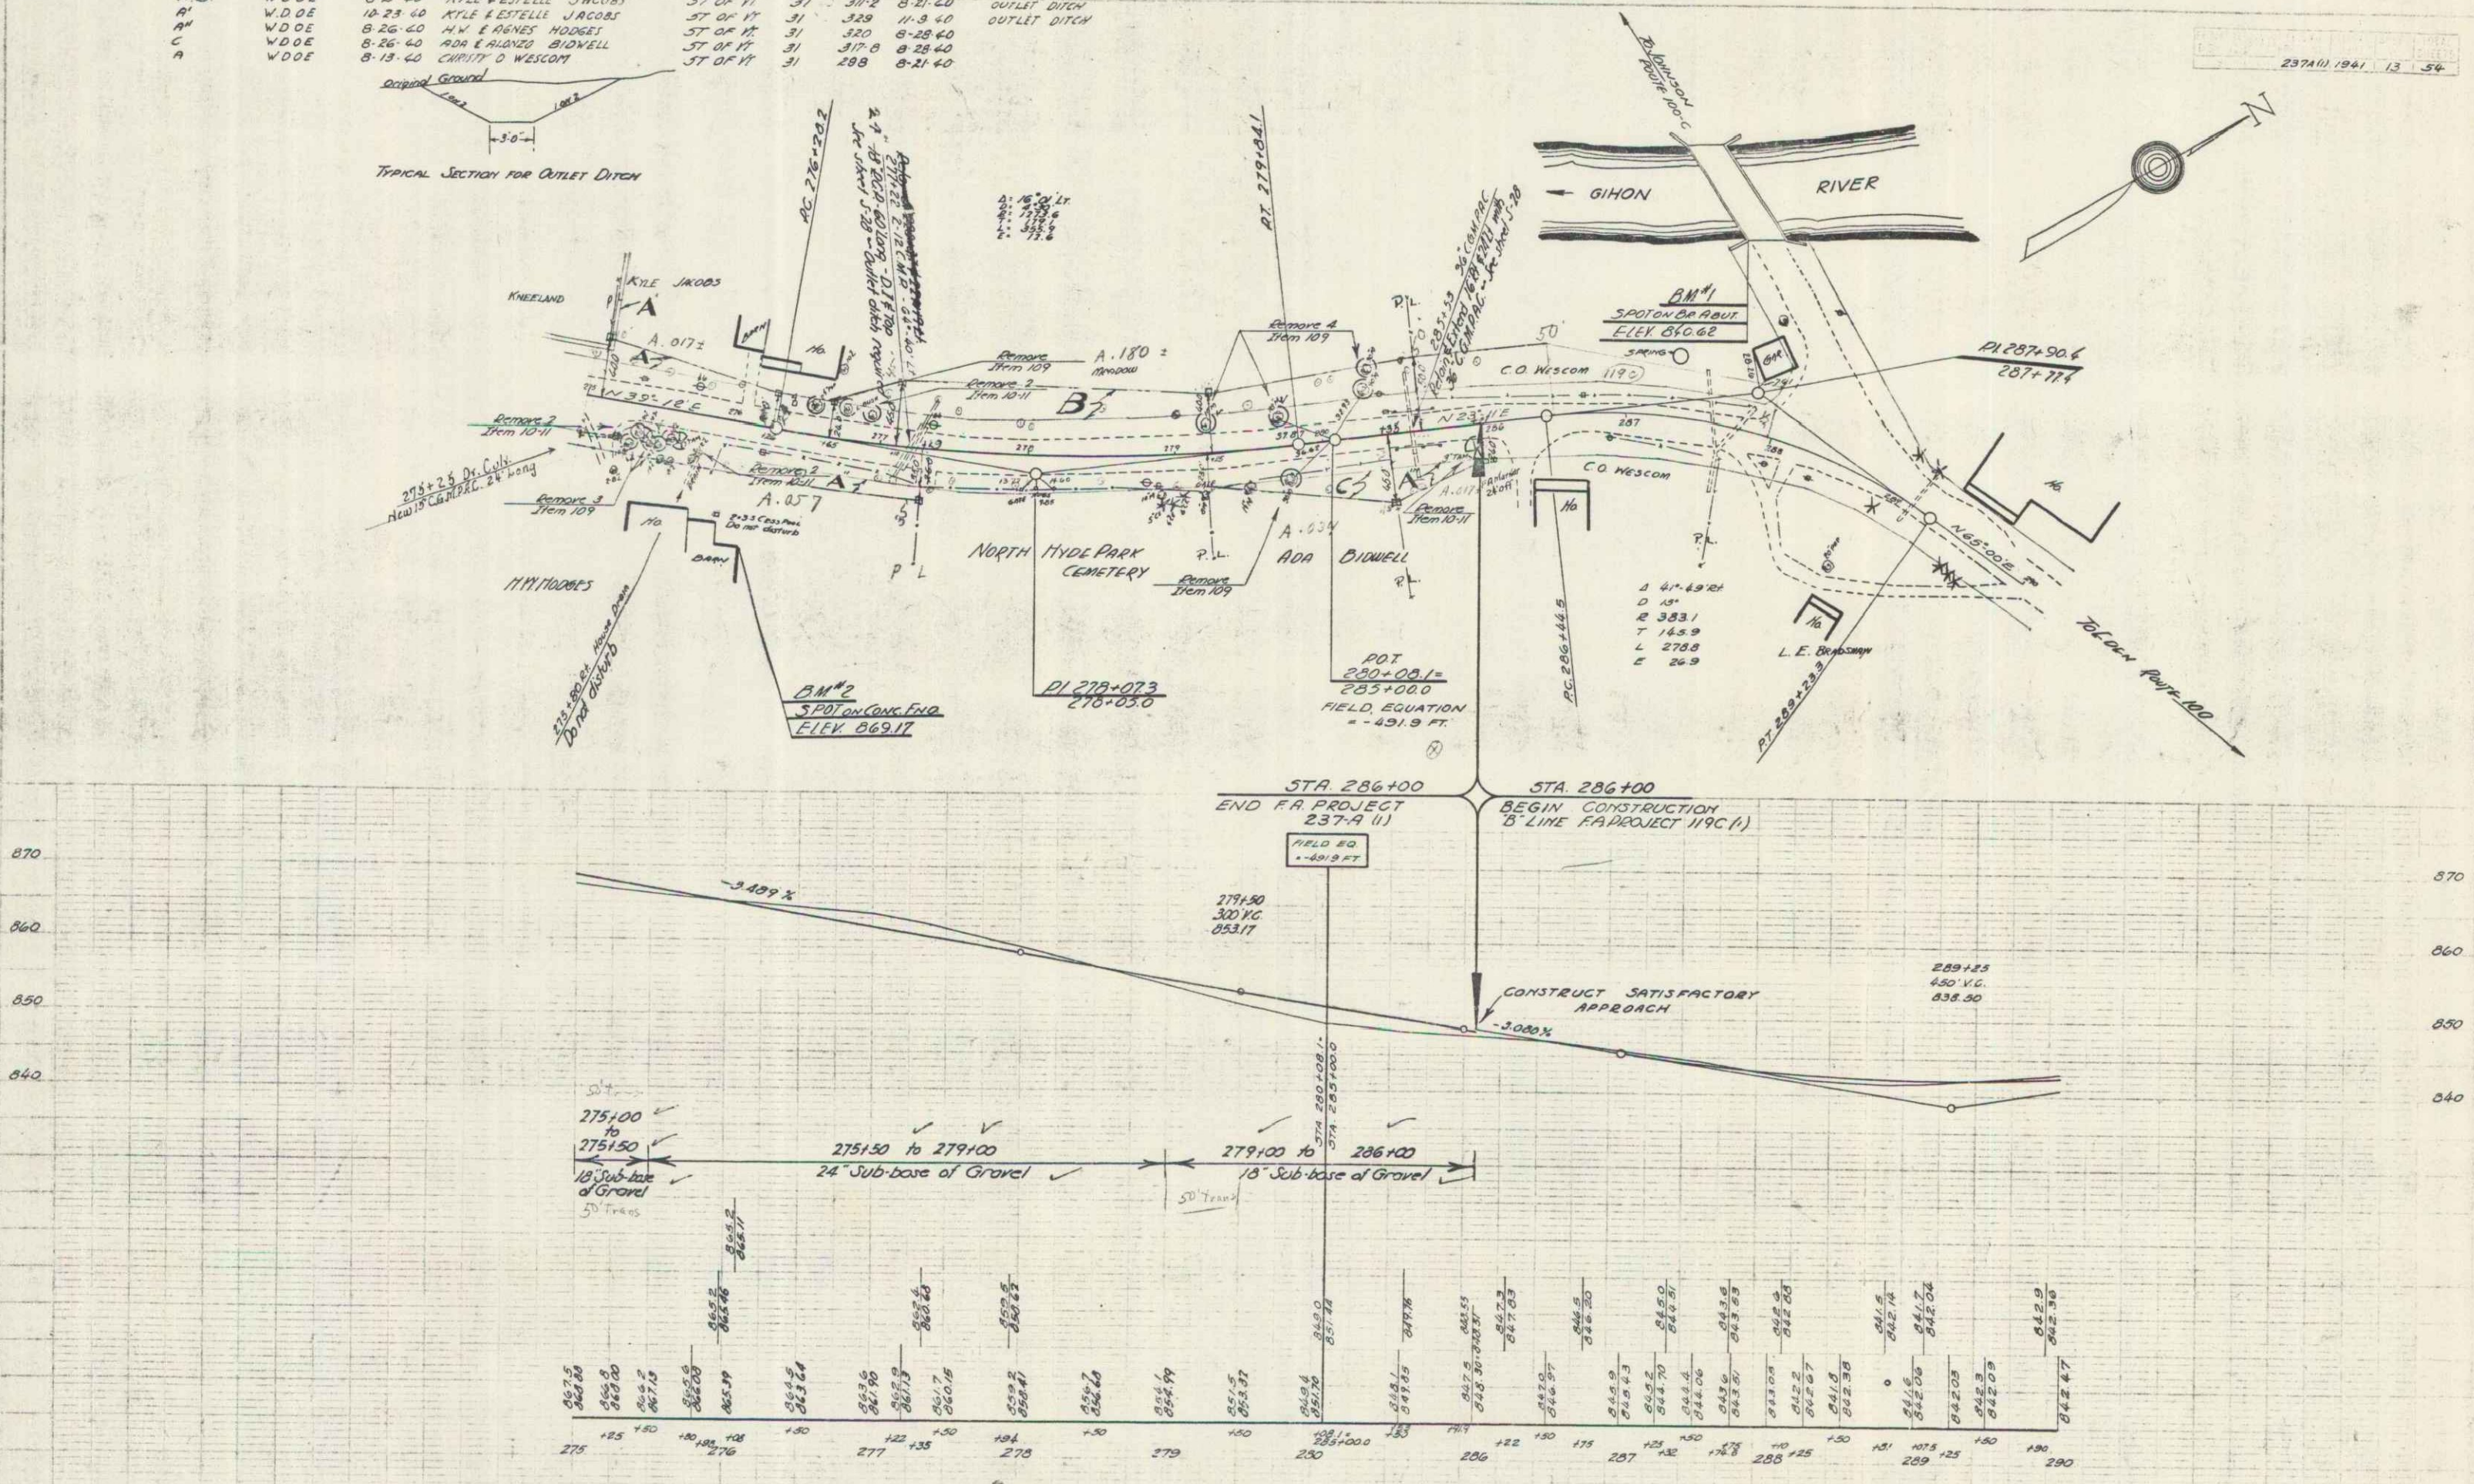


PARCEL	INITIUMENT	DATE	GRANTOR	GRANTEE	RECORDED	REMARKS

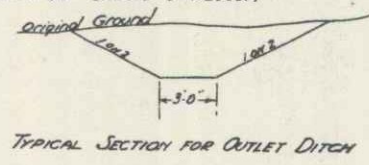

