PARCEL	INSTRUMENT	DATE	GRANTOR	GRANTEE	RECORDED EDEN BOOK	PAGE	DATE	REMARKS
B	WDOE	6-3-60	HENRY M ROSSIER	ST OF VT	22	628-29	6-6-60	
A	WDOE	5-20-60	A.F. & LELA LOCKE	ST OF VT	22	633	5-27-60	
A1	WDOE	5-21-60	LEON E & MANDRA MILLER	ST OF VT	22	634	5-27-60	

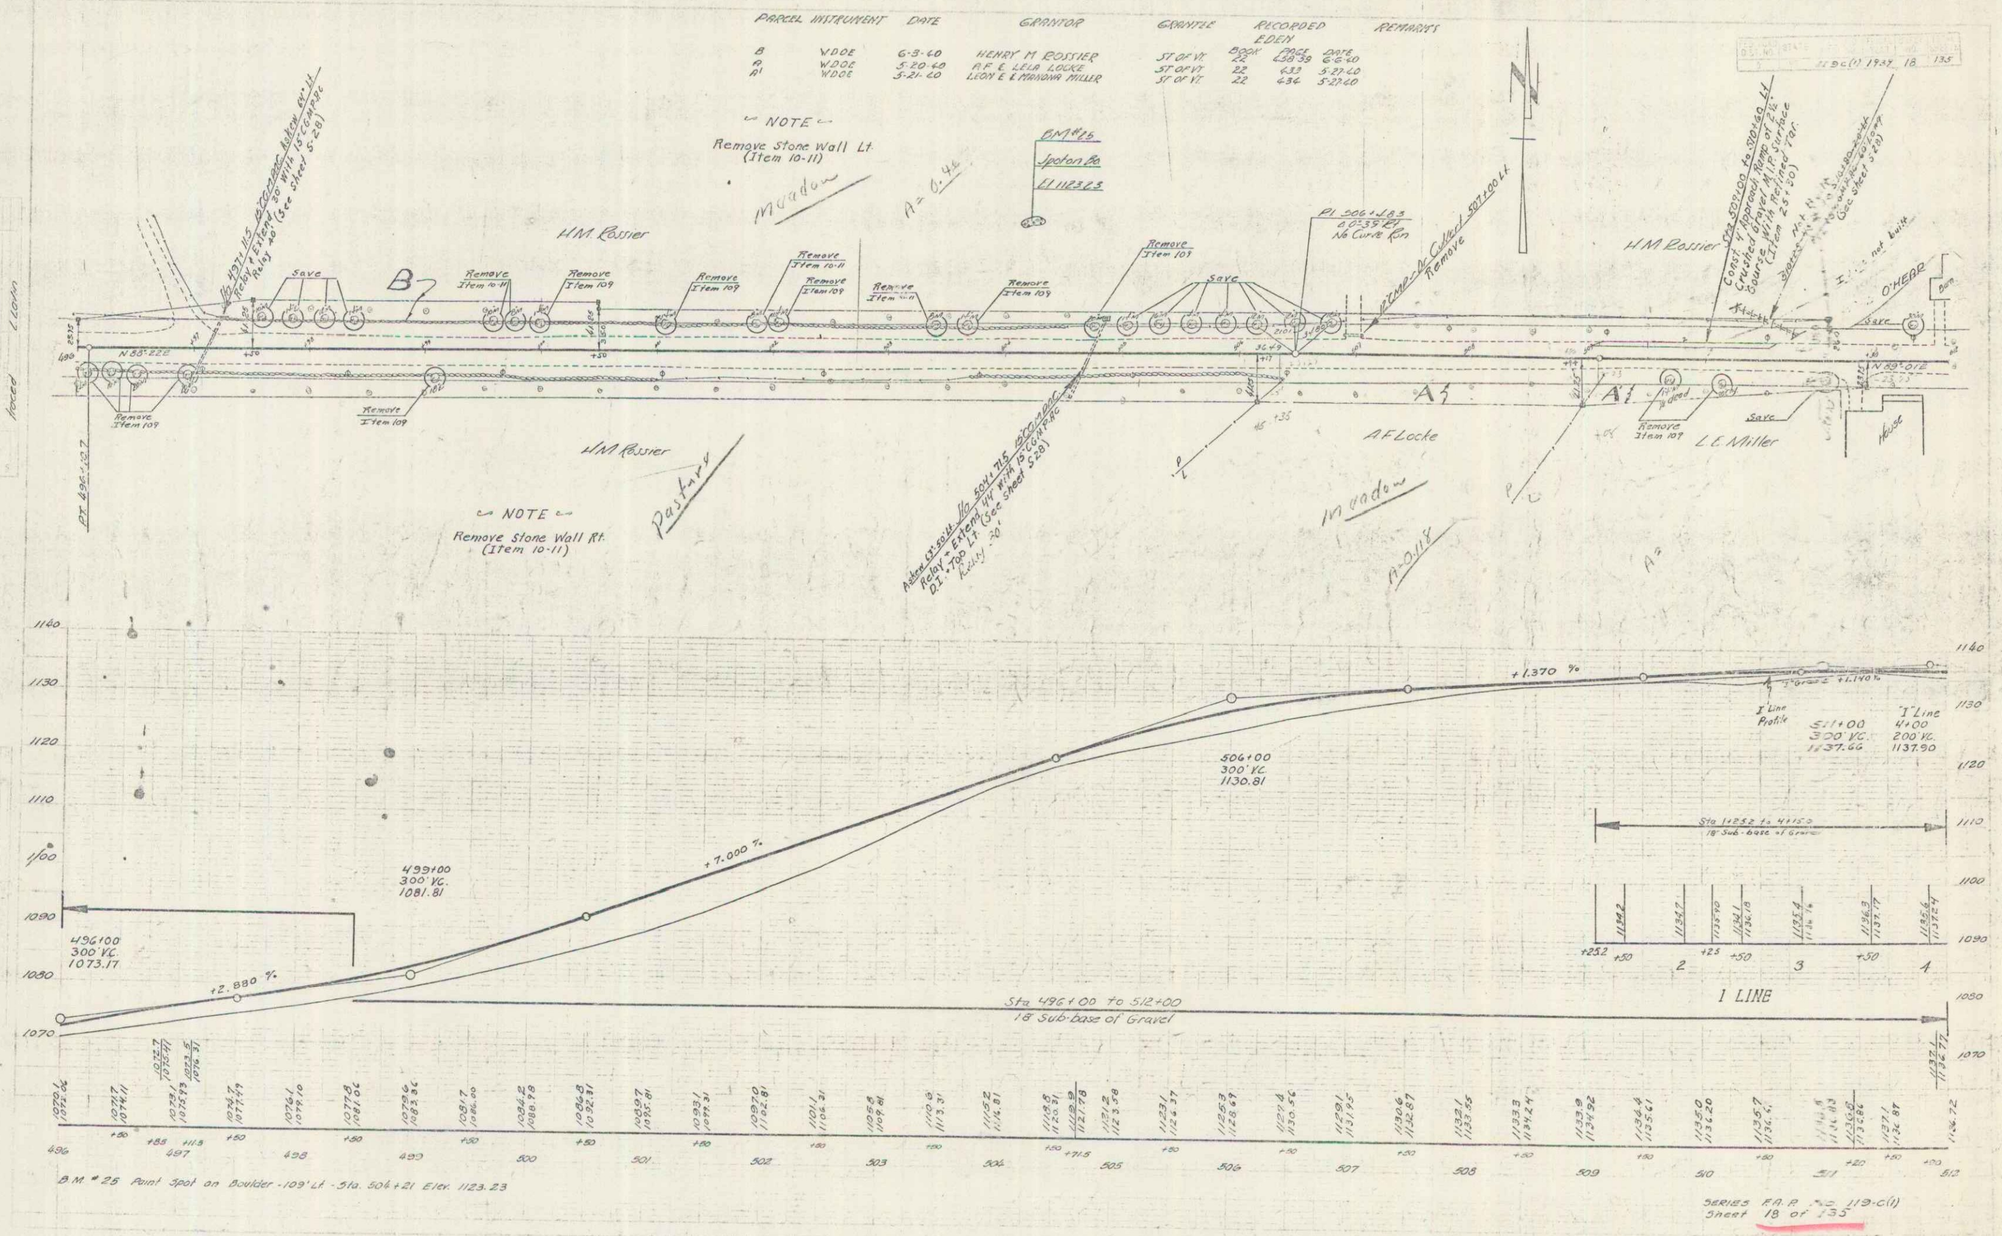
NOTE
Remove Stone Wall Lt.
(Item 10-11)
Meadow
A = 6.44
BM #26
Spotson Rd
El 1123.23
HM Rossier
Save
B
Remove
Item 10-11
Remove
Item 109
Remove Item 109
Remove Item 10-11
Remove Item 109
Remove Item 10-11
Remove Item 109
Remove Item 109
Remove Item 109