
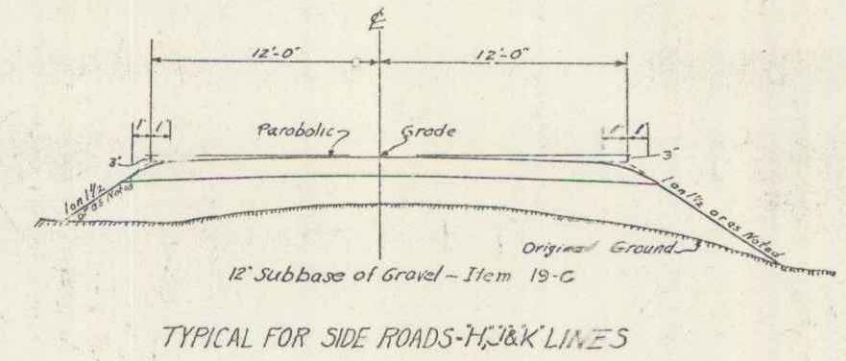
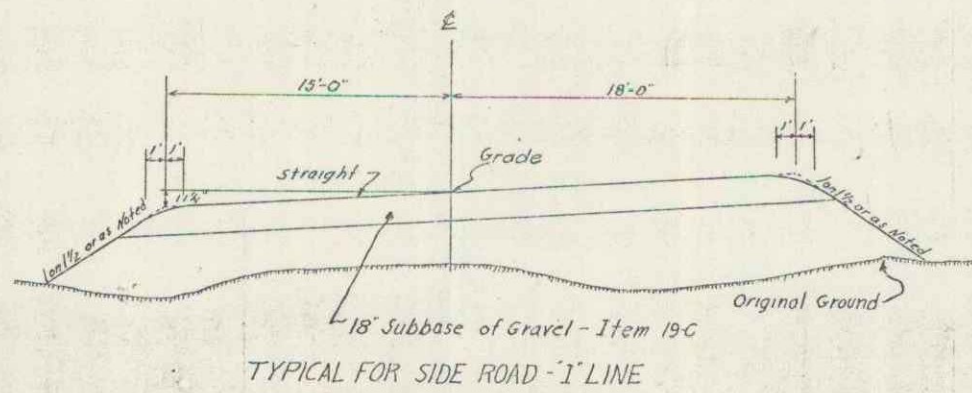


PARCEL INSTRUMENT DATE GRANTEE GRANTEE RECORDED EDEM REMARK  

APR 10 1940 19 135

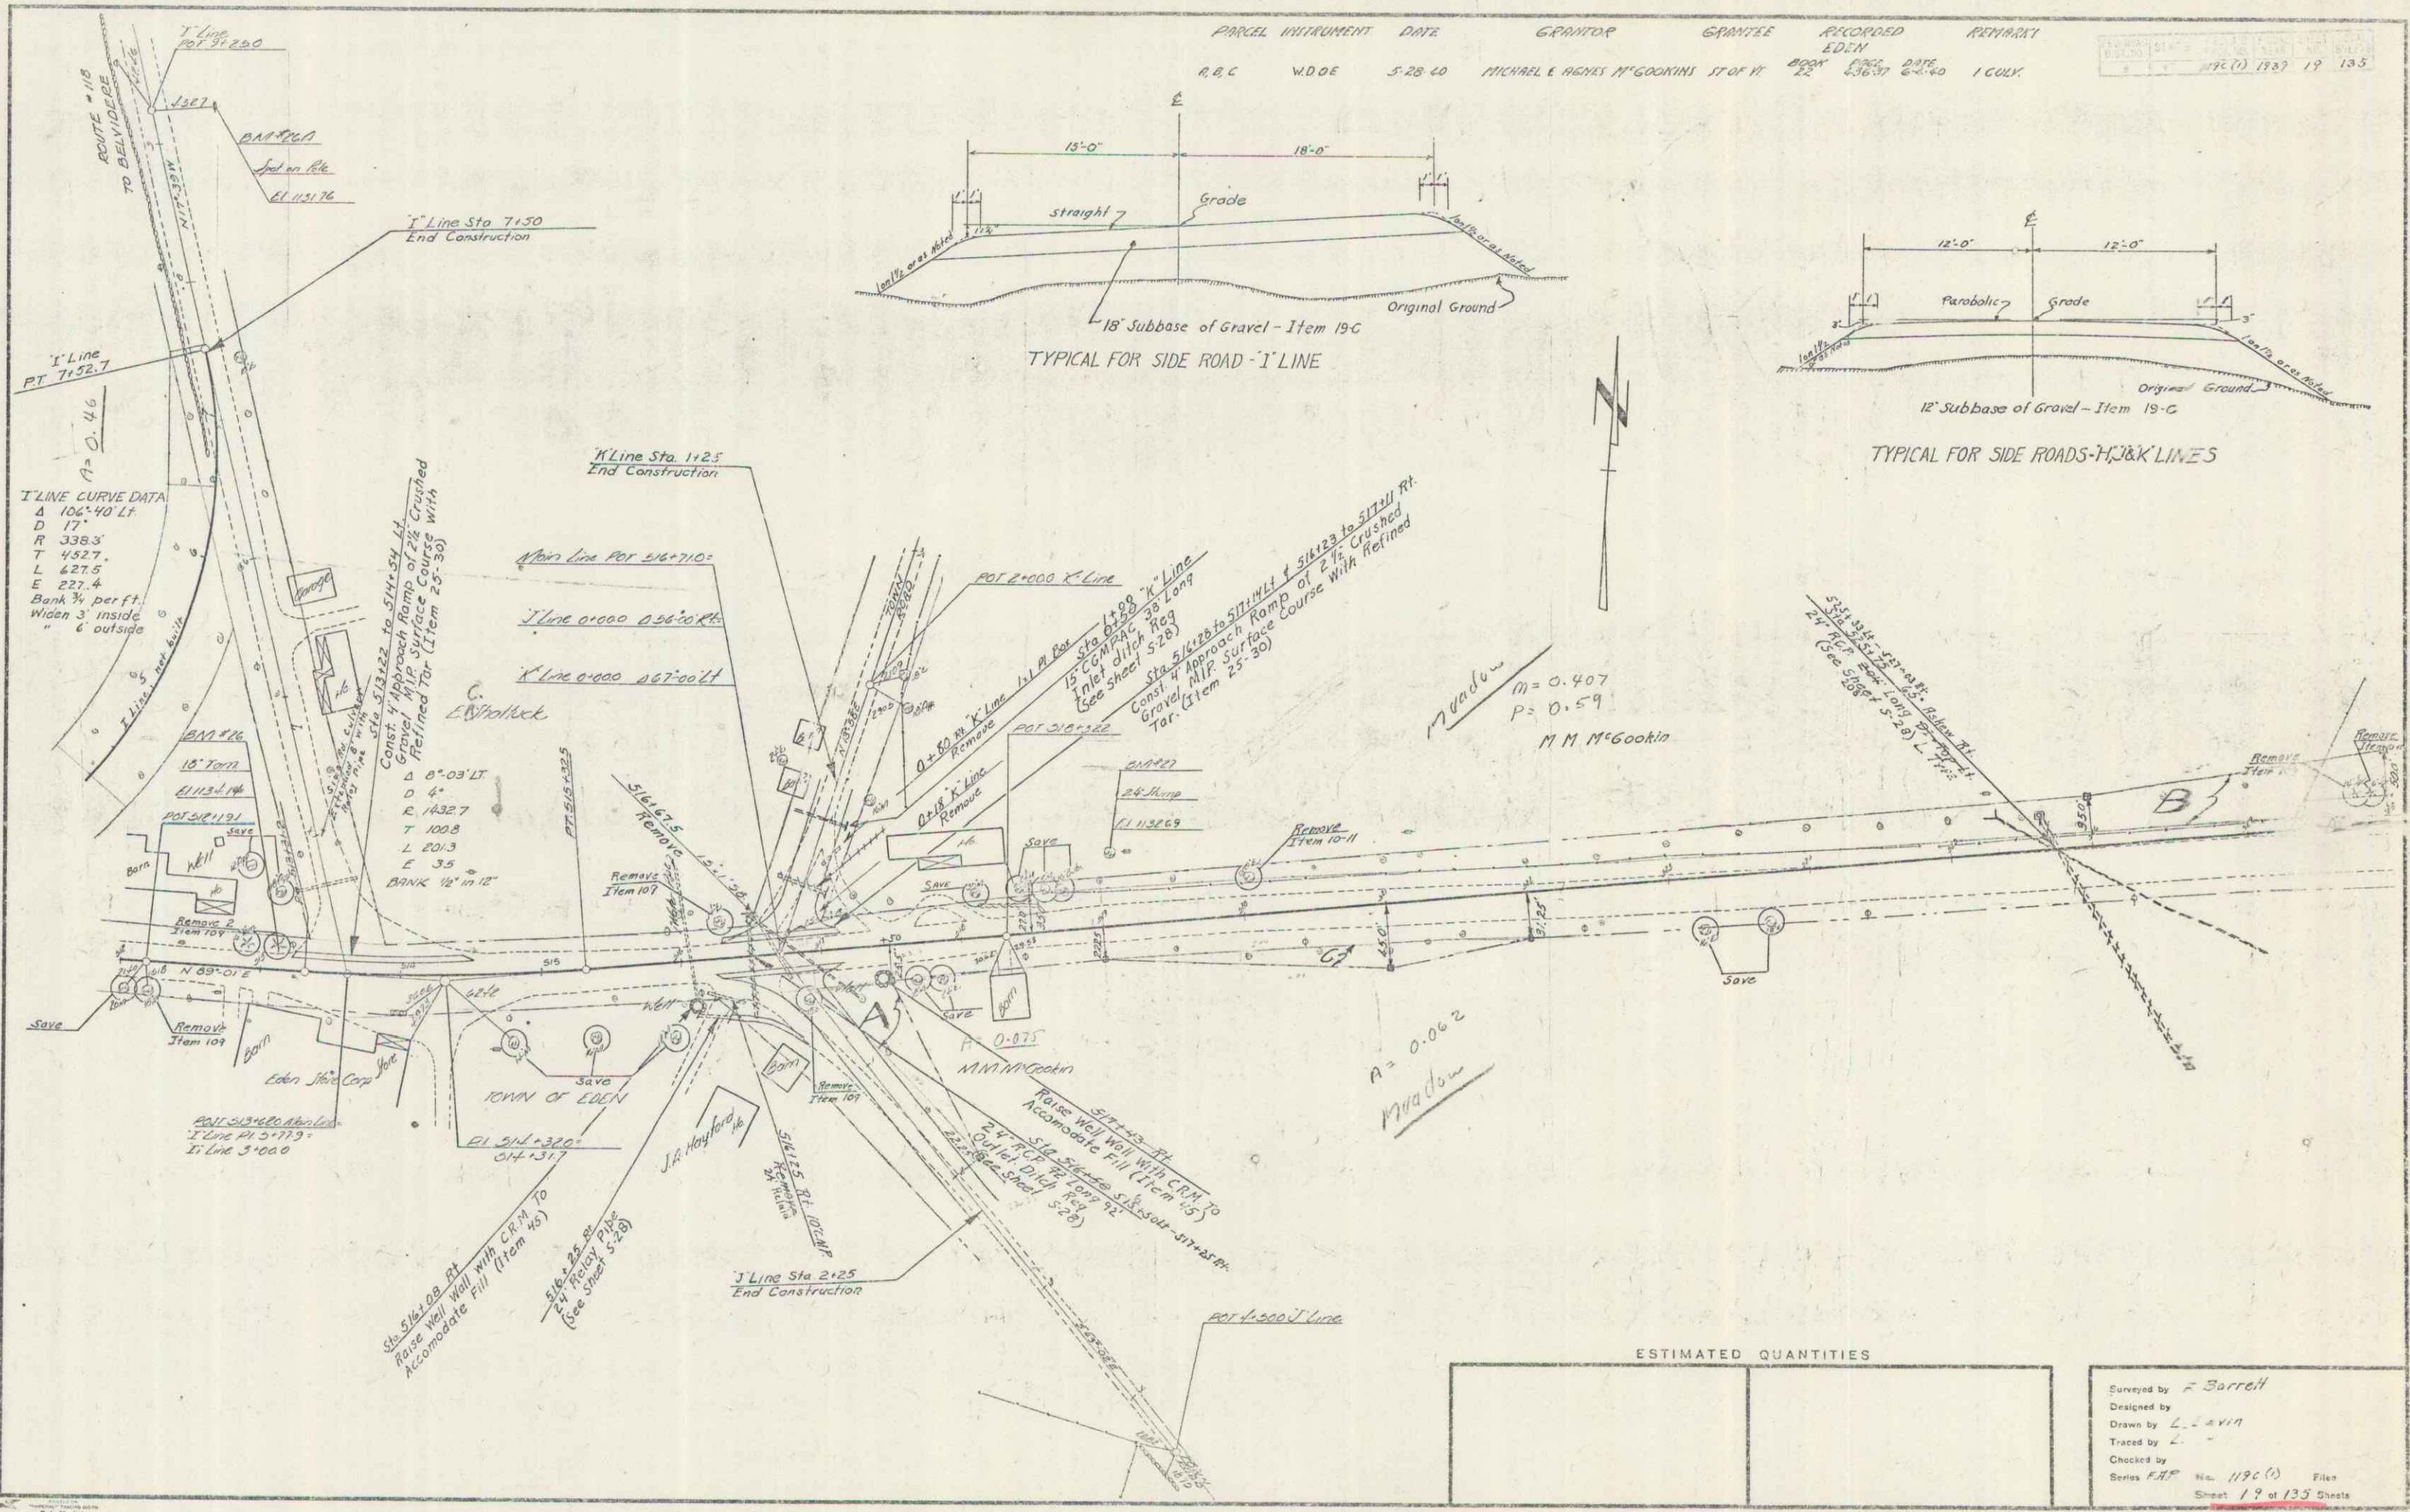

Meadow  
 m = 0.407  
 p = 0.59  
 M. M. M'Gookin

Meadow  
 A = 0.062

**I-LINE CURVE DATA**  
 A 106°40' LT  
 D 17'  
 R 338.3'  
 T 452.7'  
 L 427.5'  
 E 227.4'  
 Bank 3/4 inside  
 " 6 outside

**I-LINE STA 7150**  
 End Construction

**K-LINE STA 1125**  
 End Construction

**J-LINE STA 2125**  
 End Construction