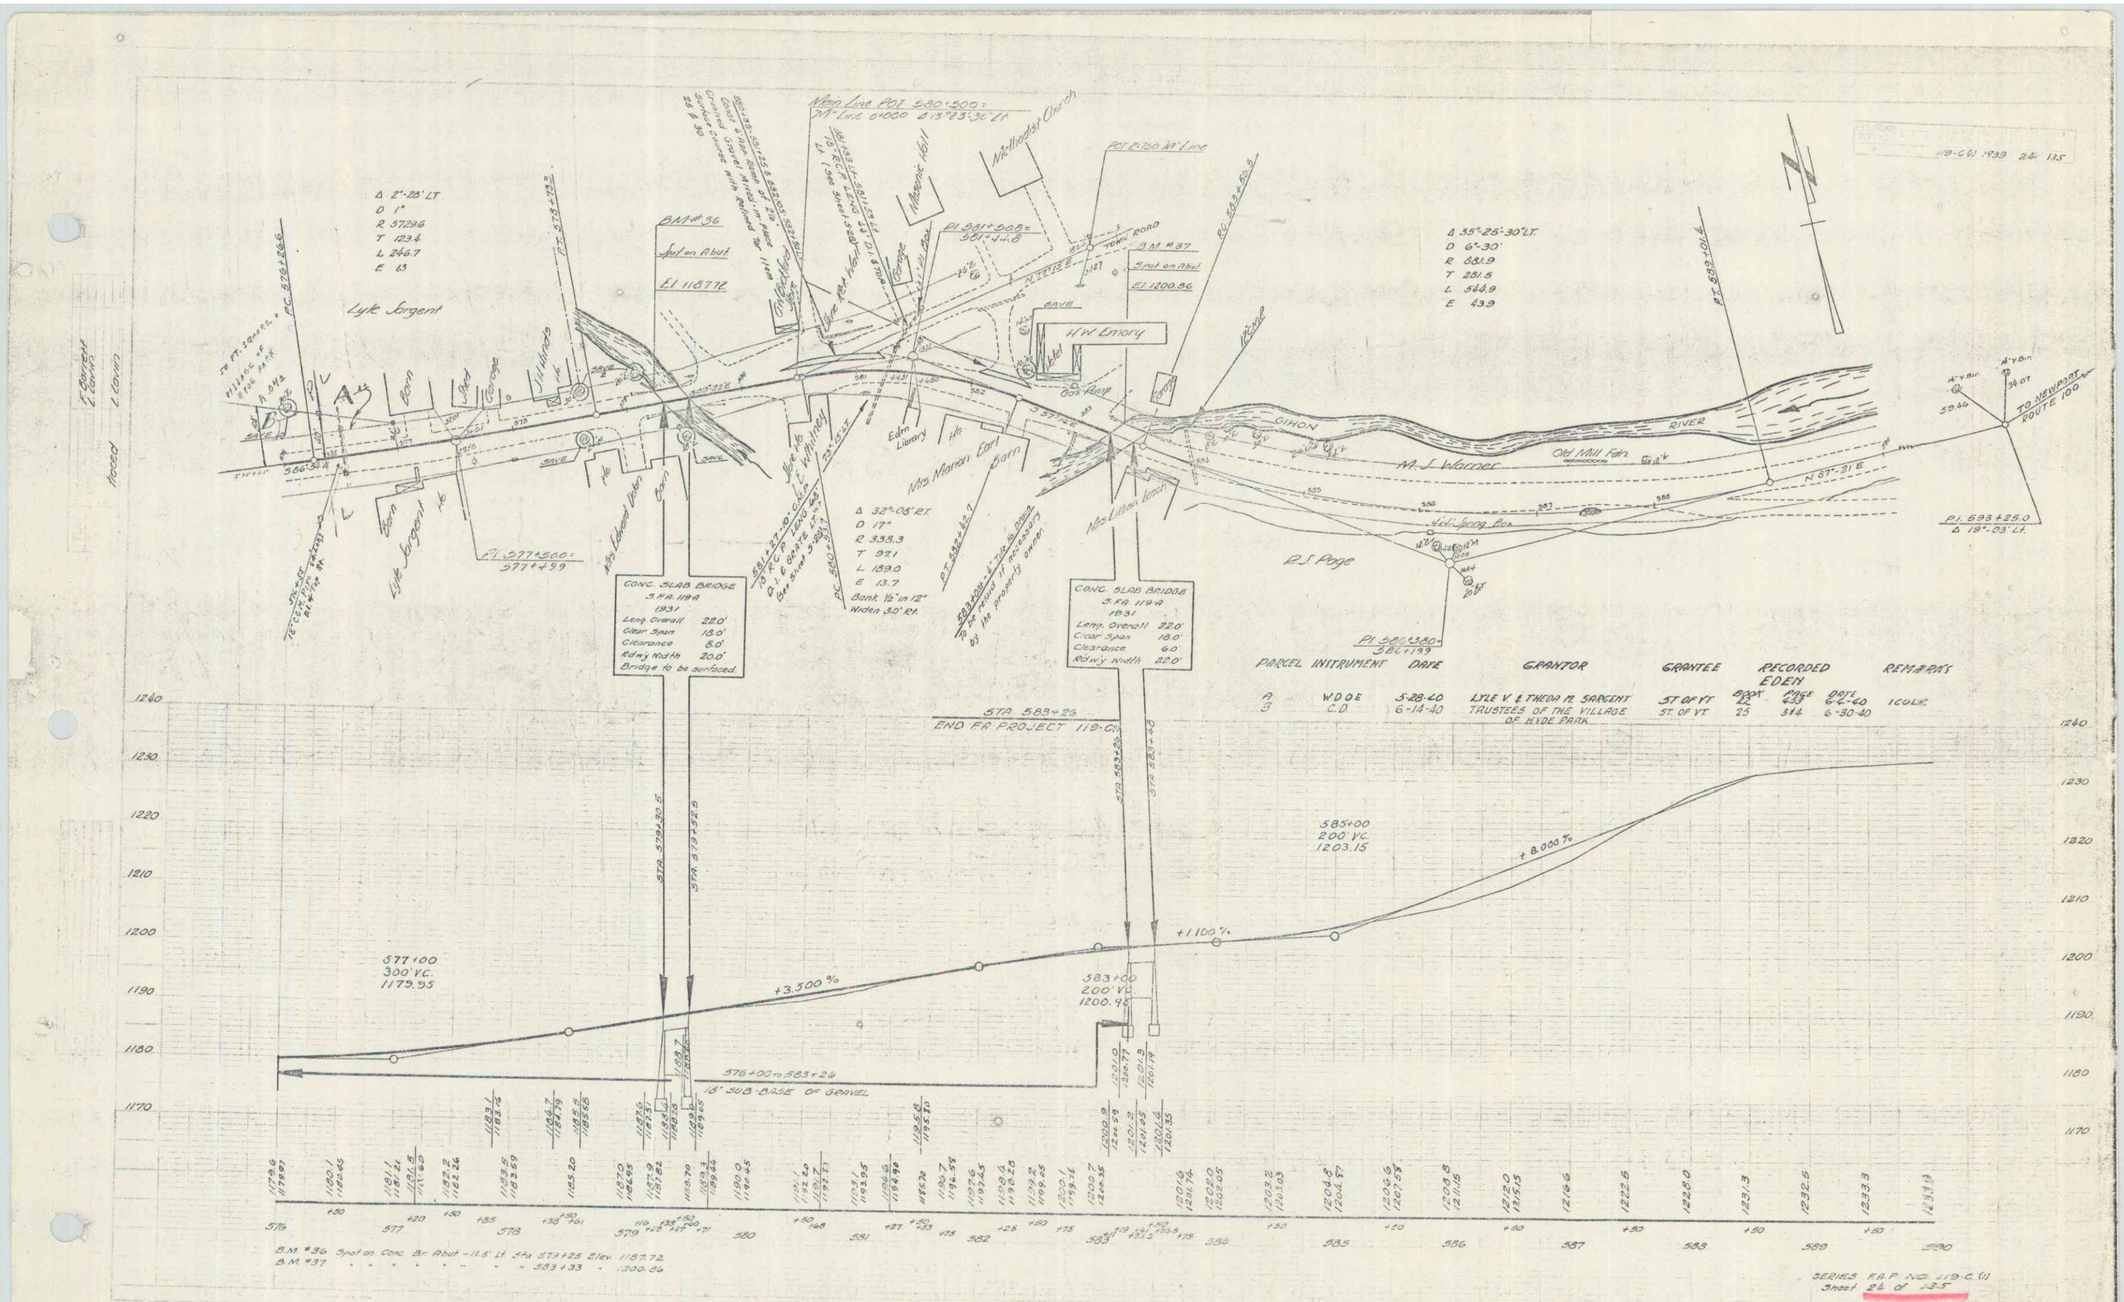

PARCEL	INSTRUMENT	DATE	GRANTOR	GRANTEE	RECORDED EDEN BOOK	PAGE	DATE	REMARKS
A	W.D.O.E	5-28-40	LYLE V. & THEDA M. SARGENT	ST. OF VT.	22	433	6-6-40	1 CULV.
B	C.D.	6-14-40	TRUSTEES OF THE VILLAGE OF HYDE PARK	ST. OF VT.	23	314	6-30-40	

22