


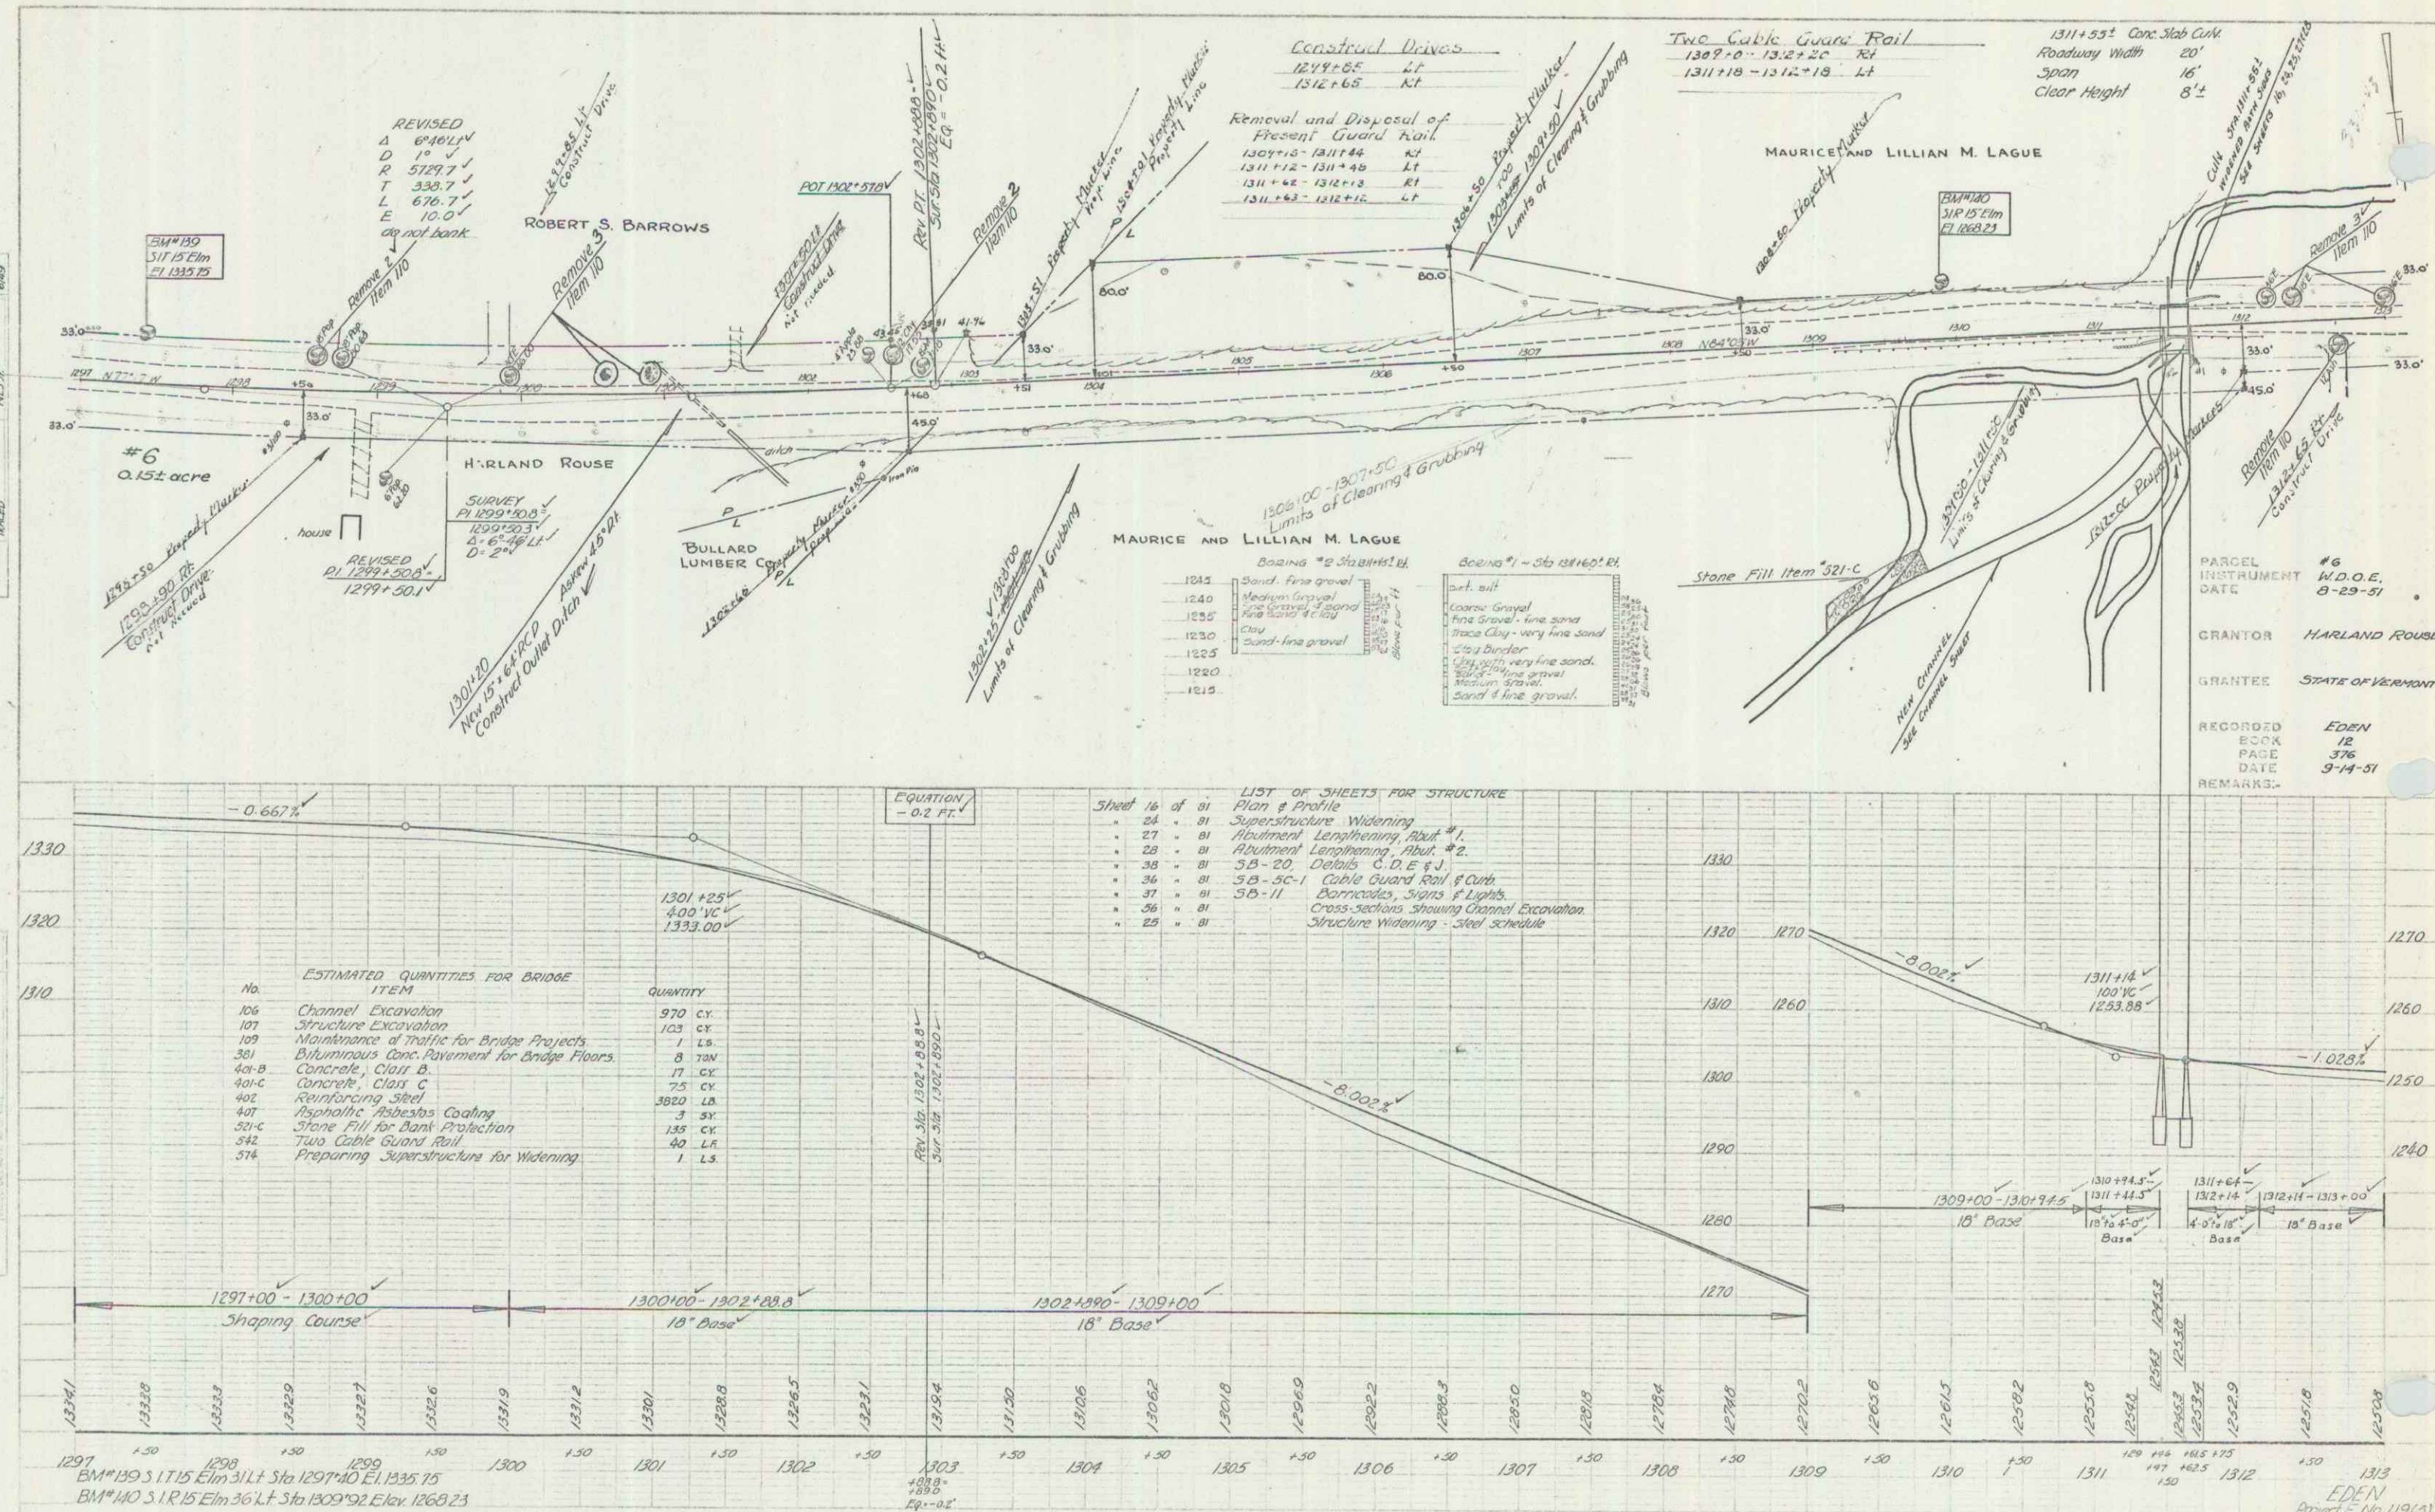

EDEN
Project F No 119(5)
Sheet 16 of 81 Sheet