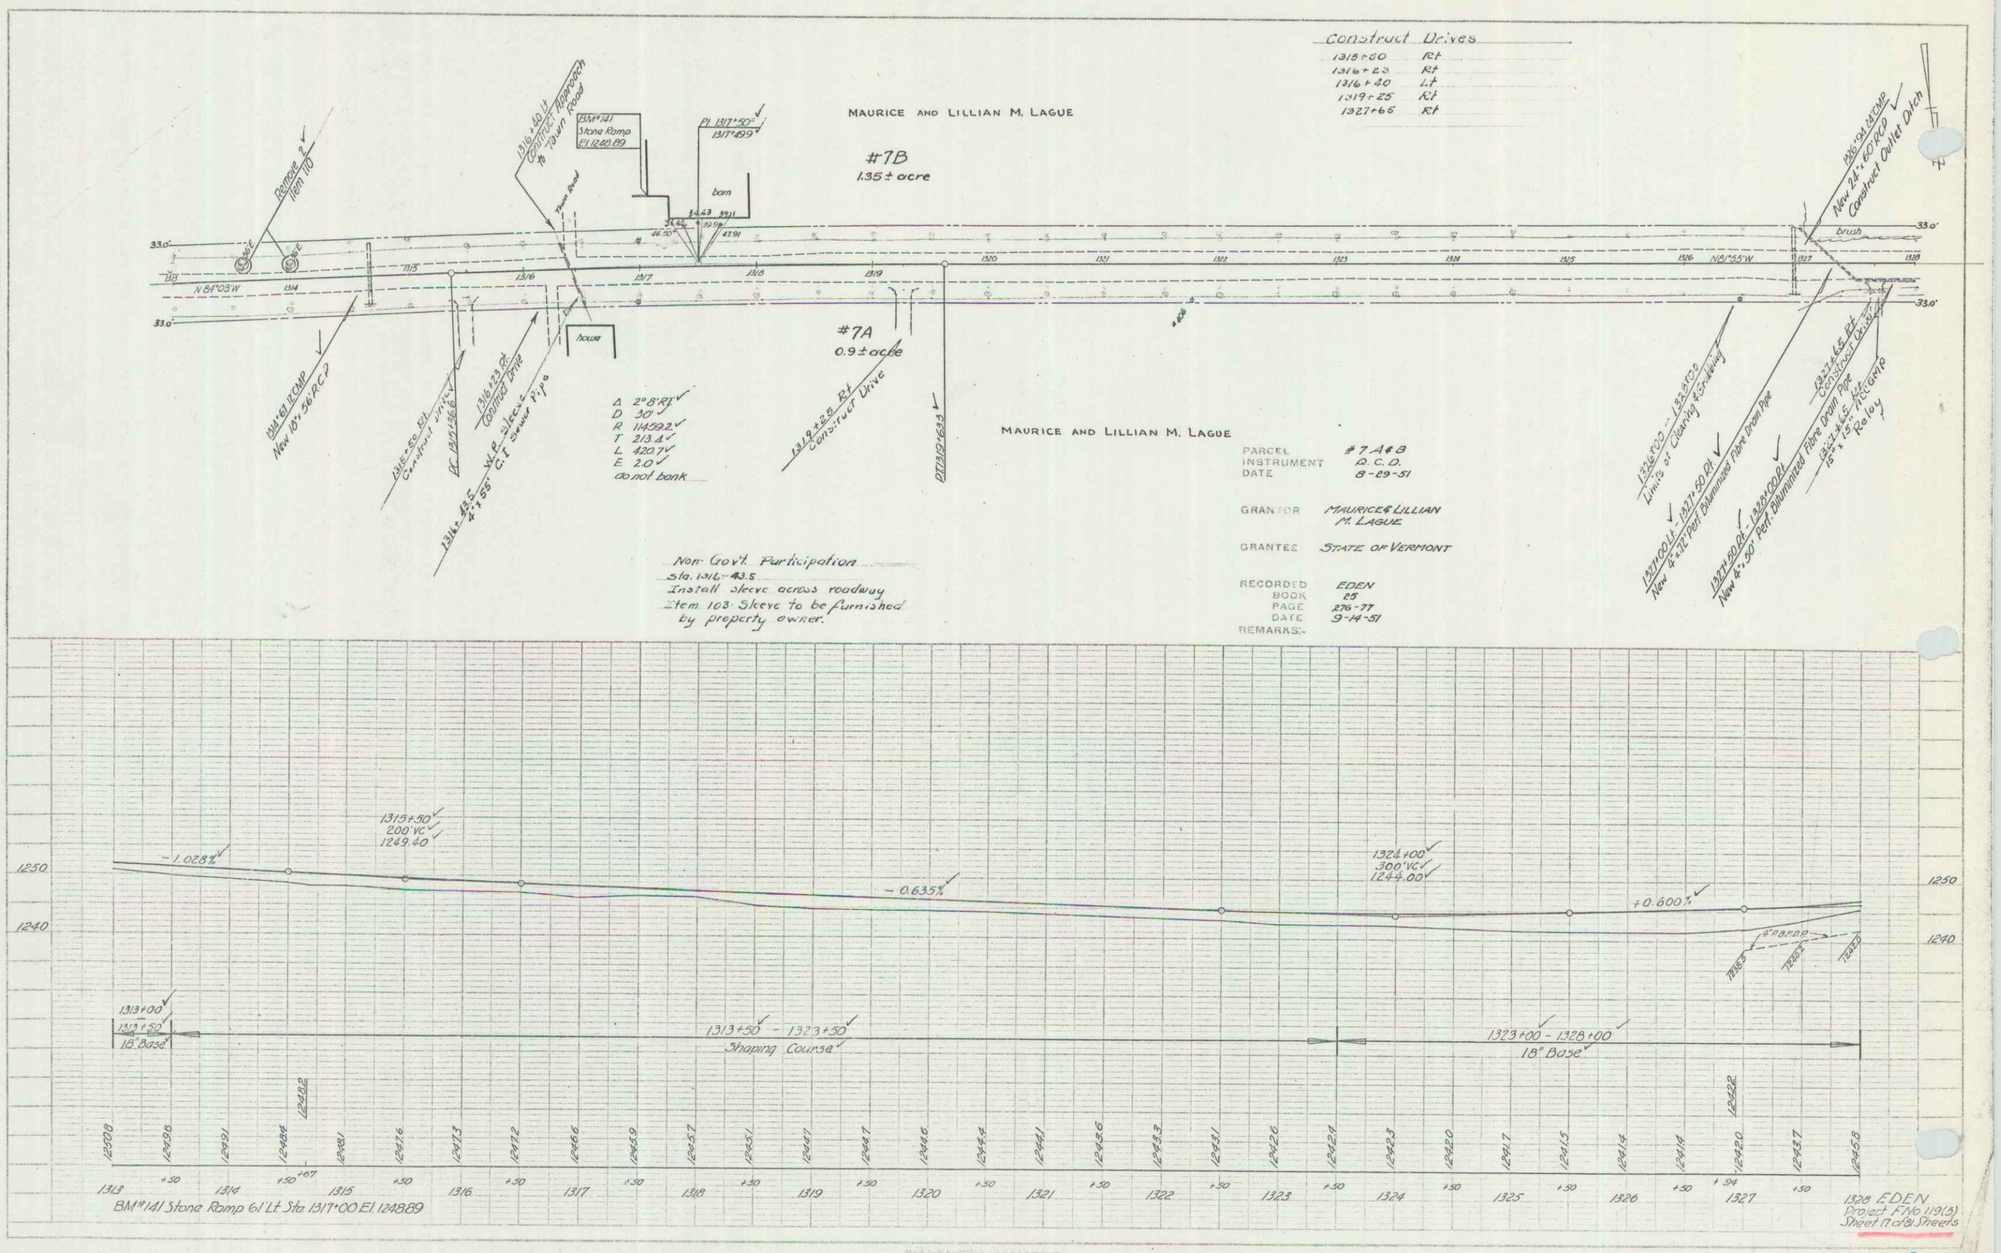
Construct Drives
1315+60 Rt
1316+23 Rt
1316+40 Lt
1319+25 Rt
1327+66 Rt
MAURICE AND LILLIAN M. LAGUE
#7B
1.35 ± acre
#7A
0.9 ± acre
MAURICE AND LILLIAN M. LAGUE
Remove 2 Item 110
1316+40 Lt Construct Approach to Town Road
BM #141 Stone Ramp El 1248.89
Town Road
barn
house
1314+81 18" CMP New 18"x36" RCP
1315+50 Rt Construct Drive
1316+33 Rt Construct Drive
1314+43.5 W.P. sleeve 4"x55' C.I. Sewer Pipe
1319+22.5 Rt Construct Drive
Δ 2°8'Rt
D 30'
R 1145.92'
T 213.4'
L 420.7'
E 2.0'
do not bank
N 84°03'W
N 81°55'W
New 24"x80' RCP Construct Outlet Ditch
brush
1327+00 Lt - 1327+50 Rt New 4"x12' Perf Bituminized Fibre Drain Pipe
1327+50 Rt - 1328+00 Rt New 4"x30' Perf Bituminized Fibre Drain Pipe
Non-Gov't Participation
Sta. 1314L-43.5
Install sleeve across roadway
Item 103 Sleeve to be furnished by property owner.
PARCEL #7A&B
INSTRUMENT D.C.D.
DATE 8-29-51
GRANTOR MAURICE & LILLIAN M. LAGUE
GRANTEE STATE OF VERMONT
RECORDED BOOK EDEN 25
PAGE 276-77
DATE 9-14-51
REMARKS:-
1250
1240
-1.028%
-0.635%
+0.600%
1315+50 200'VC 1249.40
1324+00 300'VC 1244.00
Grade
1313+00
1313+50
18" Base
1313+50 - 1323+50
Shaping Course
1323+00 - 1328+00
18" Base
BM #141 Stone Ramp 61' Lt. Sta. 1317+00 El. 1248.89
1313 1314 1315 1316 1317 1318 1319 1320 1321 1322 1323 1324 1325 1326 1327
1328 EDEN
Project F No 119(5)
8