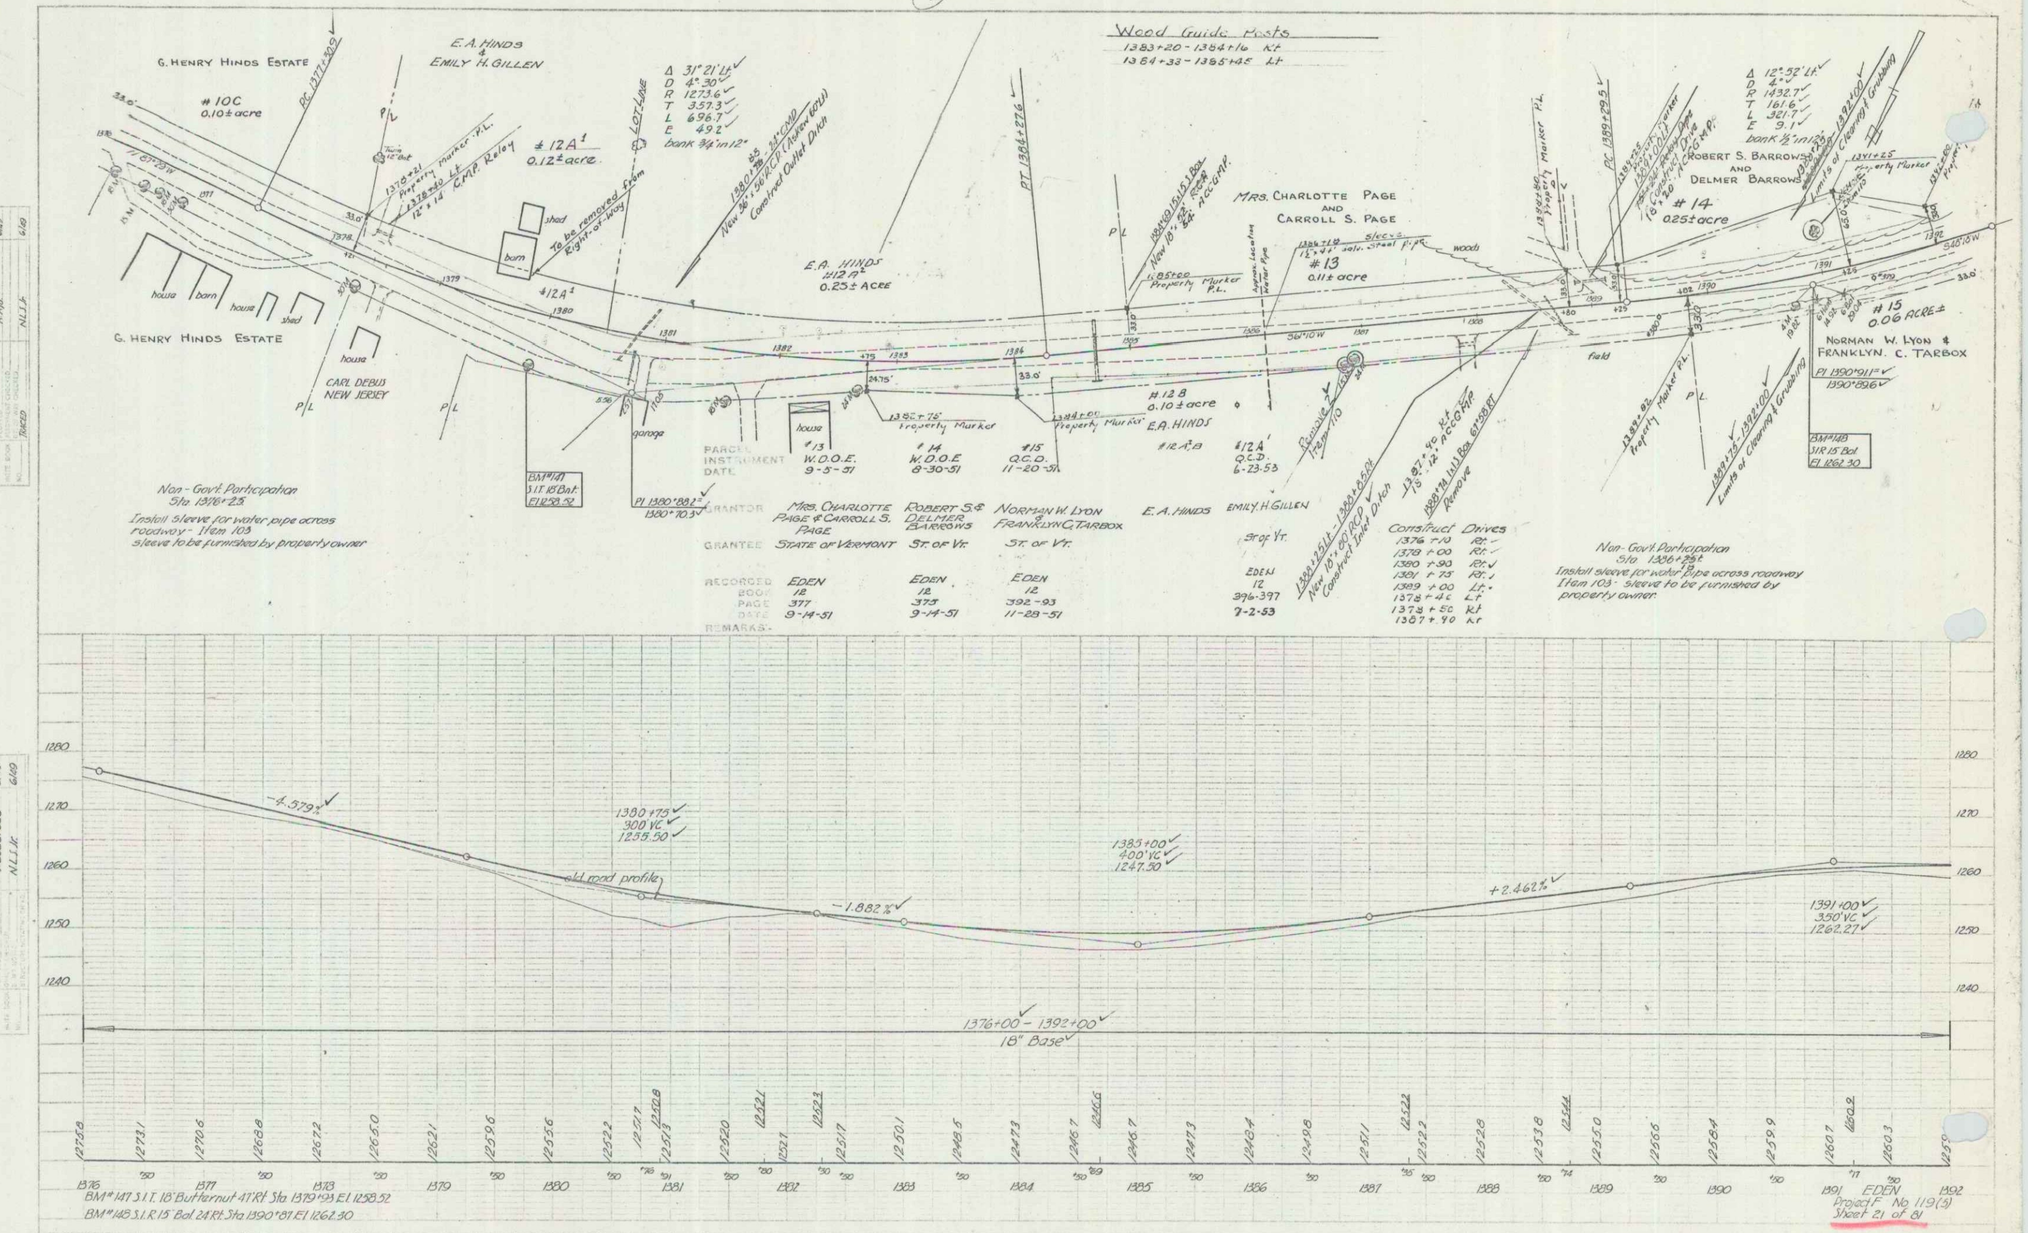
G. HENRY HINDS ESTATE
#10C
0.10± acre
E.A. HINDS
EMILY H. GILLEN
#12A¹
0.12± acre
Wood Guide Posts
1383+20 - 1384+16 Rt
1384+33 - 1385+45 Lt
Δ 31° 21' Lt
D 4° 30'
R 1273.6
T 357.3
L 696.7
E 49.2
bank ¾ in 12
MRS. CHARLOTTE PAGE AND CARROLL S. PAGE
#13
0.11± acre
E.A. HINDS
#12A²
0.25± ACRE
#12B
0.10± acre
ROBERT S. BARROWS AND DELMER BARROWS
#14
0.25± acre
NORMAN W. LYON & FRANKLYN C. TARBOX
#15
0.06 ACRE±
CARL DEBUS
NEW JERSEY
house
barn
shed
garage
Non-Govt Participation
Sta 1376+23
Install Sleeve for water pipe across roadway - Item 103
sleeve to be furnished by property owner
Non-Govt Participation
Sta 1384+29±
Install sleeve for water pipe across roadway
Item 103 - sleeve to be furnished by property owner
PARCEL #13 #14 #15 #12A¹ #12A²B
INSTRUMENT W.O.O.E. W.O.O.E. Q.C.D. Q.C.D.
DATE 9-5-51 8-30-51 11-20-51 6-23-53
GRANTOR Mrs. Charlotte Page & Carroll S. Page | Robert S. & Delmer Barrows | Norman W. Lyon & Franklyn C. Tarbox | E.A. Hinds | Emily H. Gillen
GRANTEE State of Vermont | St. of Vt. | St. of Vt. | St. of Vt.
RECORDED EDEN | EDEN | EDEN | EDEN
BOOK 12 | 12 | 12 | 12
PAGE 377 | 373 | 392-93 | 396-397
DATE 9-14-51 | 9-14-51 | 11-28-51 | 7-2-53
REMARKS:
Construct Drives
1376 + 10 Rt
1378 + 00 Rt
1380 + 90 Rt
1381 + 75 Rt
1383 + 00 Lt
1378 + 45 Lt
1378 + 50 Rt
1387 + 90 Rt
Remove
Construct 2 Rt
Construct 1 Rt
Property Marker
Fence
Limits of Clearing & Grubbing
Set PI
Set PI 1380°88'
1380°10.3'
Set PI 1390°91'
1390°89.6'
BM #147 S.I.T. 18" Butternut 47 Rt Sta 1379+93 El 1258.52
BM #148 S.I.R. 15 Bol 24 Rt Sta 1390+87 El 1262.30
-4.579%
1380+75
300' VC
1235.50
old road profile
-1.882%
1383+00
400' VC
1247.50
+2.462%
1391+00
350' VC
1262.27
1376+00 - 1392+00
18" Base
EDEN
Project F. No 119(3)
Sheet 21 of 81