


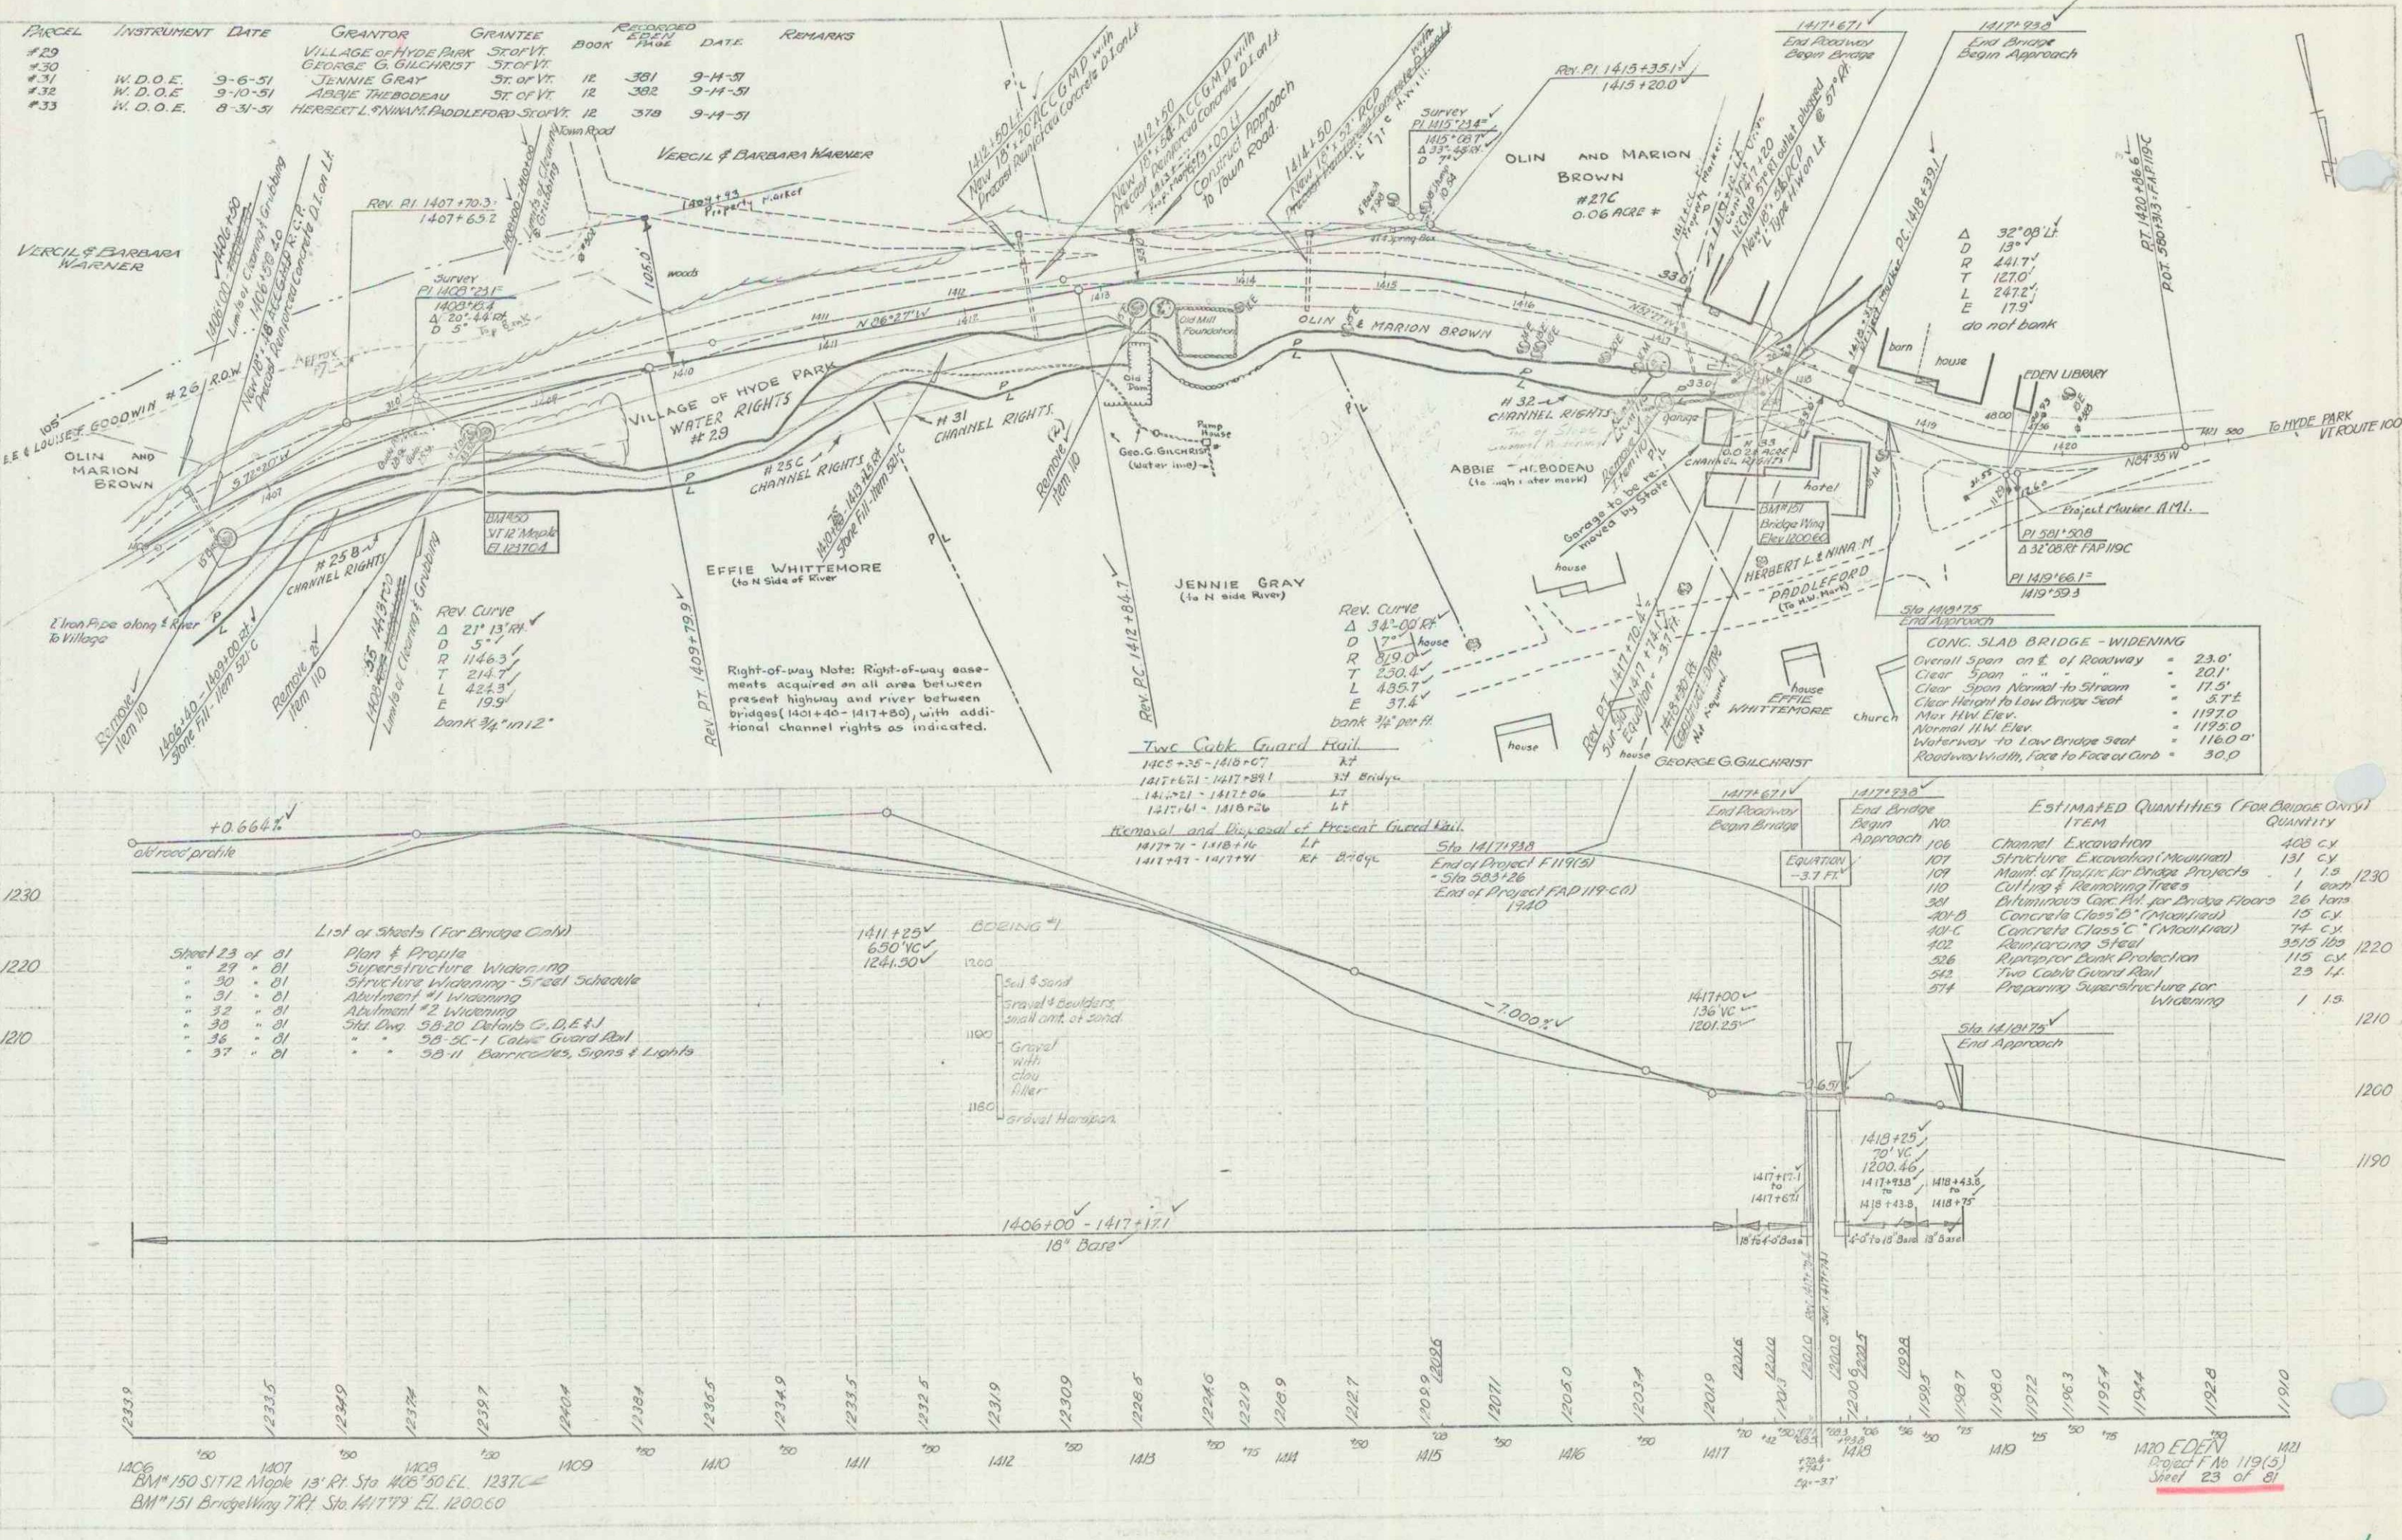

PARCEL	INSTRUMENT DATE	GRANTOR	GRANTEE	BOOK	PAGE	DATE	REMARKS
#29		VILLAGE OF HYDE PARK	ST OF VT				
#30		GEORGE G. GILCHRIST	ST OF VT				
#31	W.D.O.E. 9-6-51	JENNIE GRAY	ST OF VT	12	381	9-14-51	

ESTIMATED QUANTITIES (FOR BRIDGE ONLY)	
ITEM	QUANTITY
Channel Excavation	400 CY
Structure Excavation (Medium)	131 CY
Main of Traffic for Bridge Projects	1 1/2
Concrete Class D (Modified)	15 CY
Concrete Class C (Modified)	74 CY
Reinforcing Steel	3515 lbs
Preparing Superstructure for Widening	1 1/2

- List of Sheets (For Bridge Only)

1406+00 - 1417+171
18" Bare

1406+00
1407
1408
1409
1410
1411
1412
1413
1414
1415
1416
1417
1418
1419
1420
1421
