| RED. ROAD DIST. NO. | STATE | PROJ. NO. | FISCAL YEAR | SHEET NO. | TOTAL SHEETS |
|---|---|---|---|---|---|
| 9 | VT. | F 79(9) | | 19 | 89 |

POST WAR F.A. PRIMARY

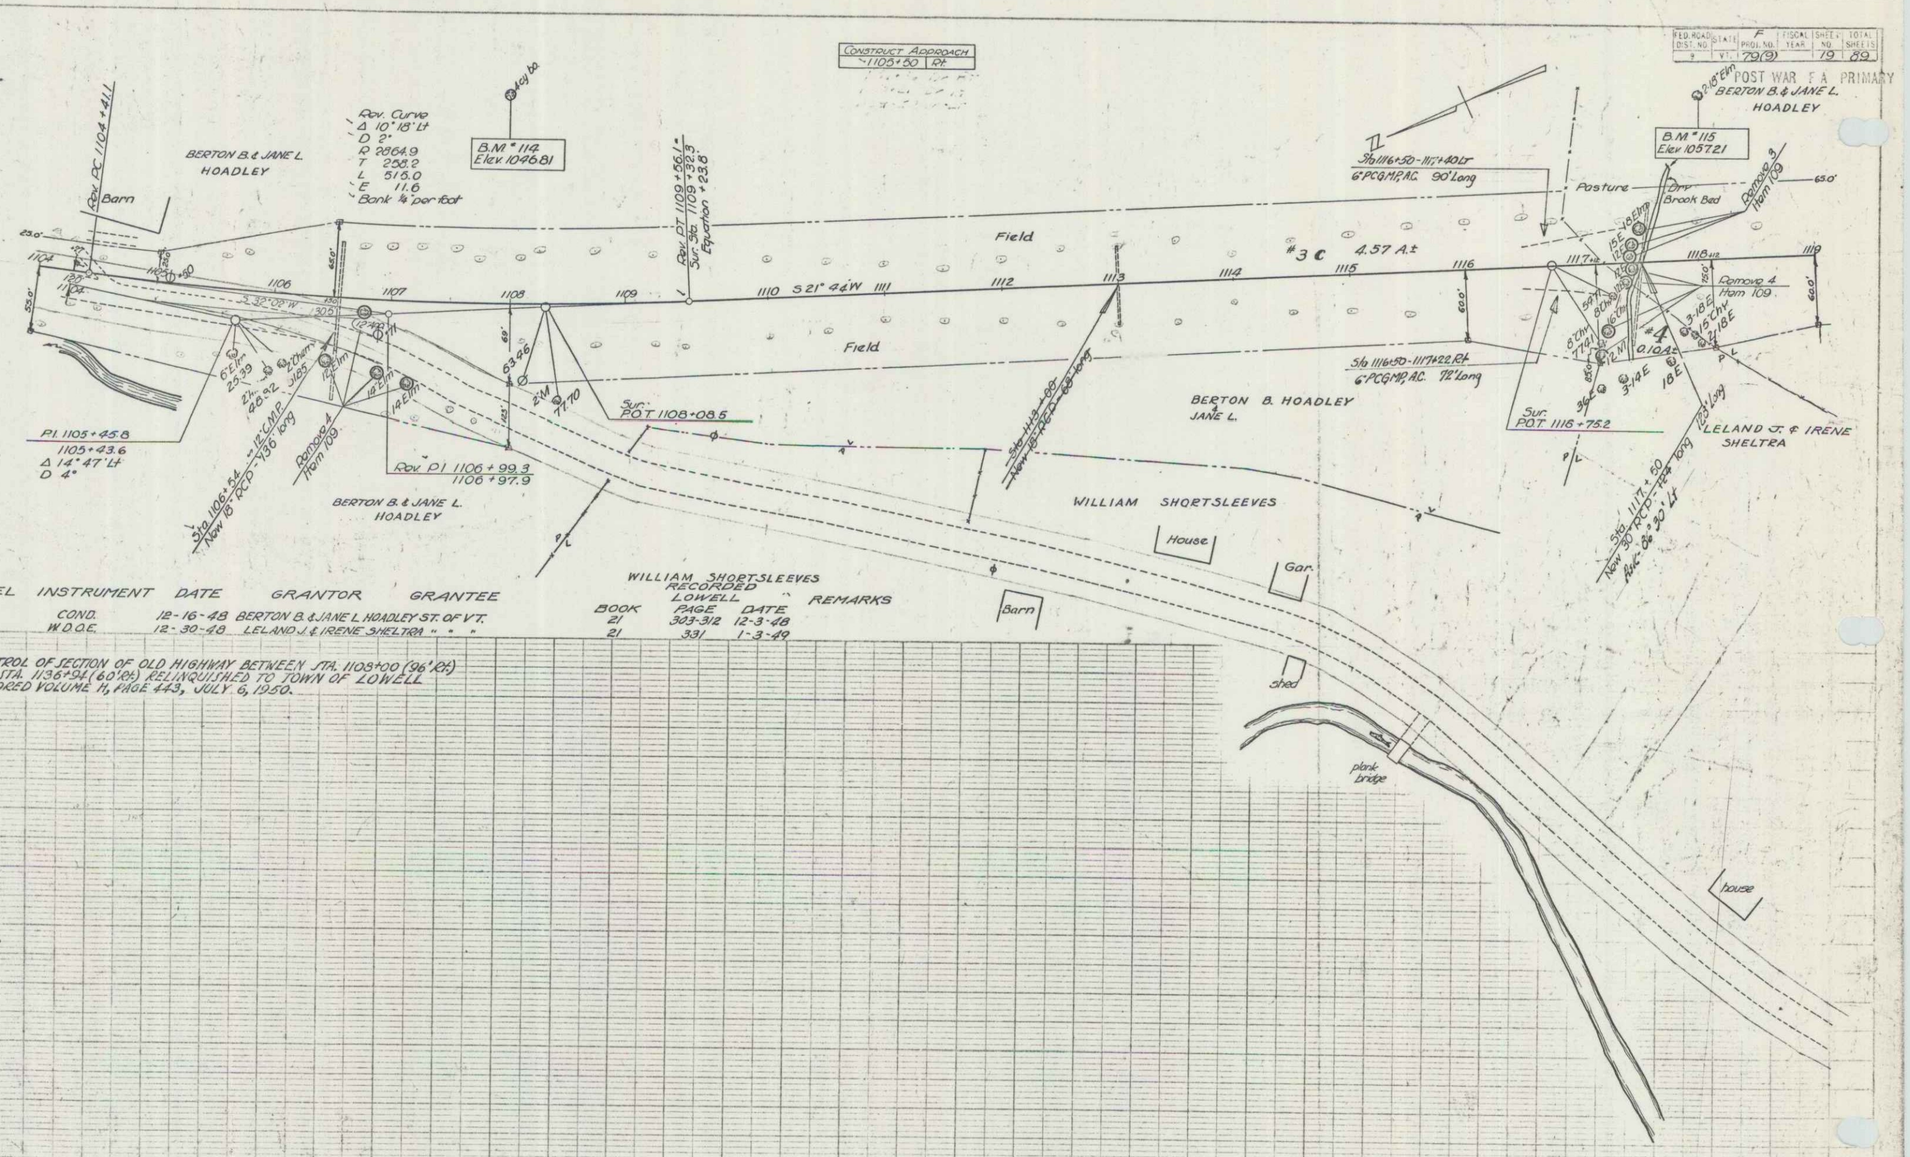


| PARCEL | INSTRUMENT | DATE | GRANTOR | GRANTEE |
|---|---|---|---|---|
| 3C | COND. | 12-16-48 | BERTON B. & JANE L. HOADLEY | ST. OF VT. |
| 4 | W.D.O.E. | 12-30-48 | LELAND J. & IRENE SHELTRA | " " " |

WILLIAM SHORTSLEEVES RECORDED LOWELL "

| BOOK | PAGE | DATE | REMARKS |
|---|---|---|---|
| 21 | 303-312 | 12-3-48 | |
| 21 | 331 | 1-3-49 | |

CONTROL OF SECTION OF OLD HIGHWAY BETWEEN STA. 1108+00 (96' Rt) AND STA. 1136+94 (60' Rt) RELINQUISHED TO TOWN OF LOWELL RECORDED VOLUME H, PAGE 443, JULY 6, 1950.

LOWELL
Series F no 79(9)
Sheet 19 of 89 sheets

4