FED. ROAD DIST. NO.	STATE	F PROJ. NO.	FISCAL YEAR	SHEET NO.	TOTAL SHEETS
1	VT.	79(9)		24	89

POST WAR F A PRIMARY

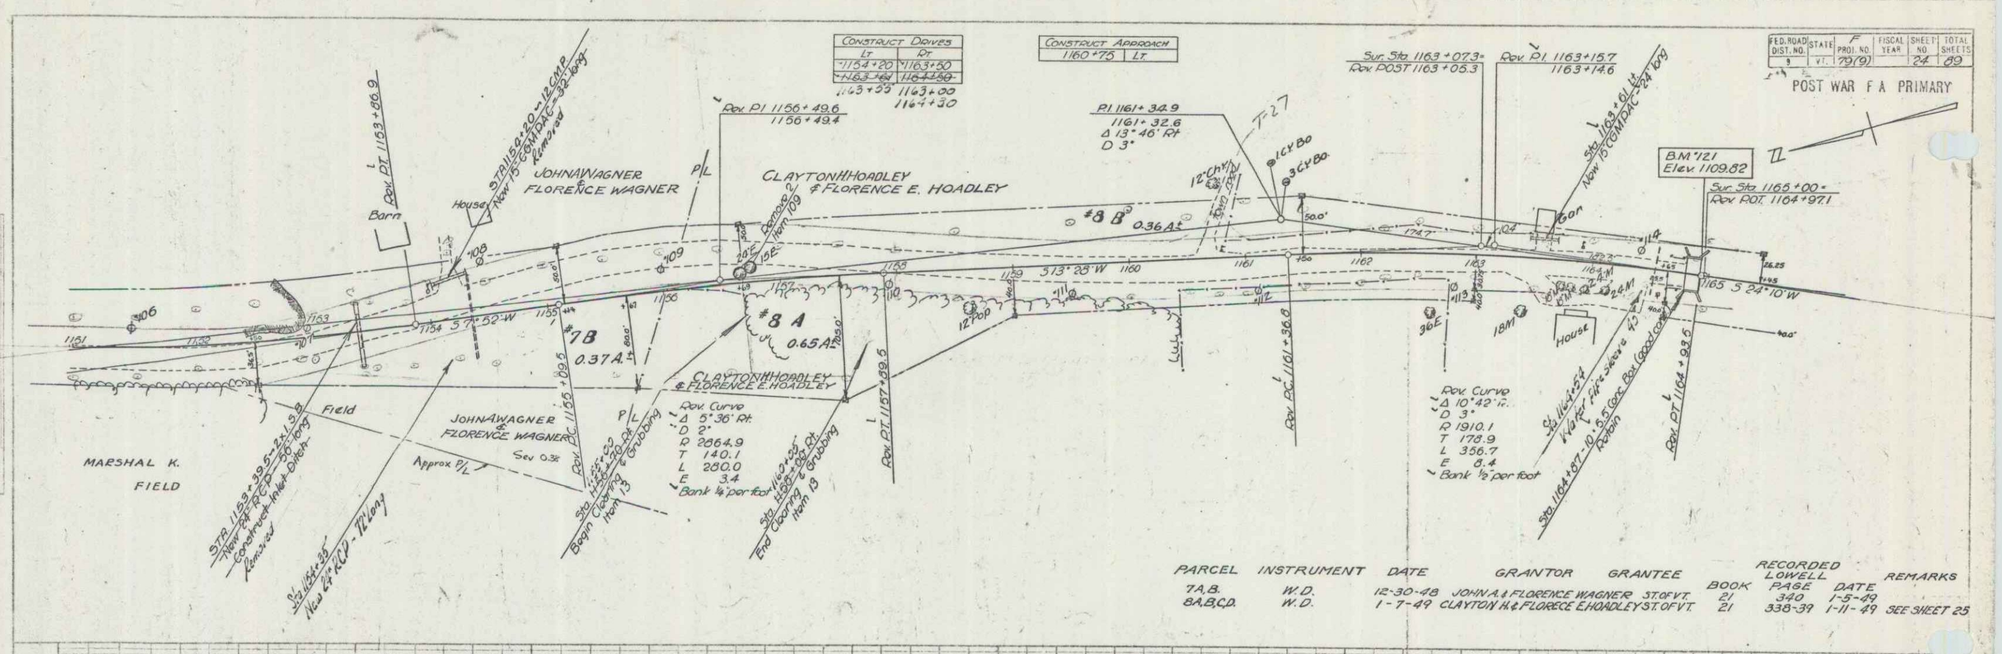

PARCEL	INSTRUMENT	DATE	GRANTOR	GRANTEE	RECORDED LOWELL BOOK	PAGE	DATE	REMARKS
7A,B.	W.D.	12-30-48	JOHN A. & FLORENCE WAGNER	ST. OF VT.	21	340	1-5-49	
8A,B,C,D.	W.D.	1-7-49	CLAYTON H. & FLORECE E. HOADLEY	ST. OF VT.	21	338-39	1-11-49	SEE SHEET 25

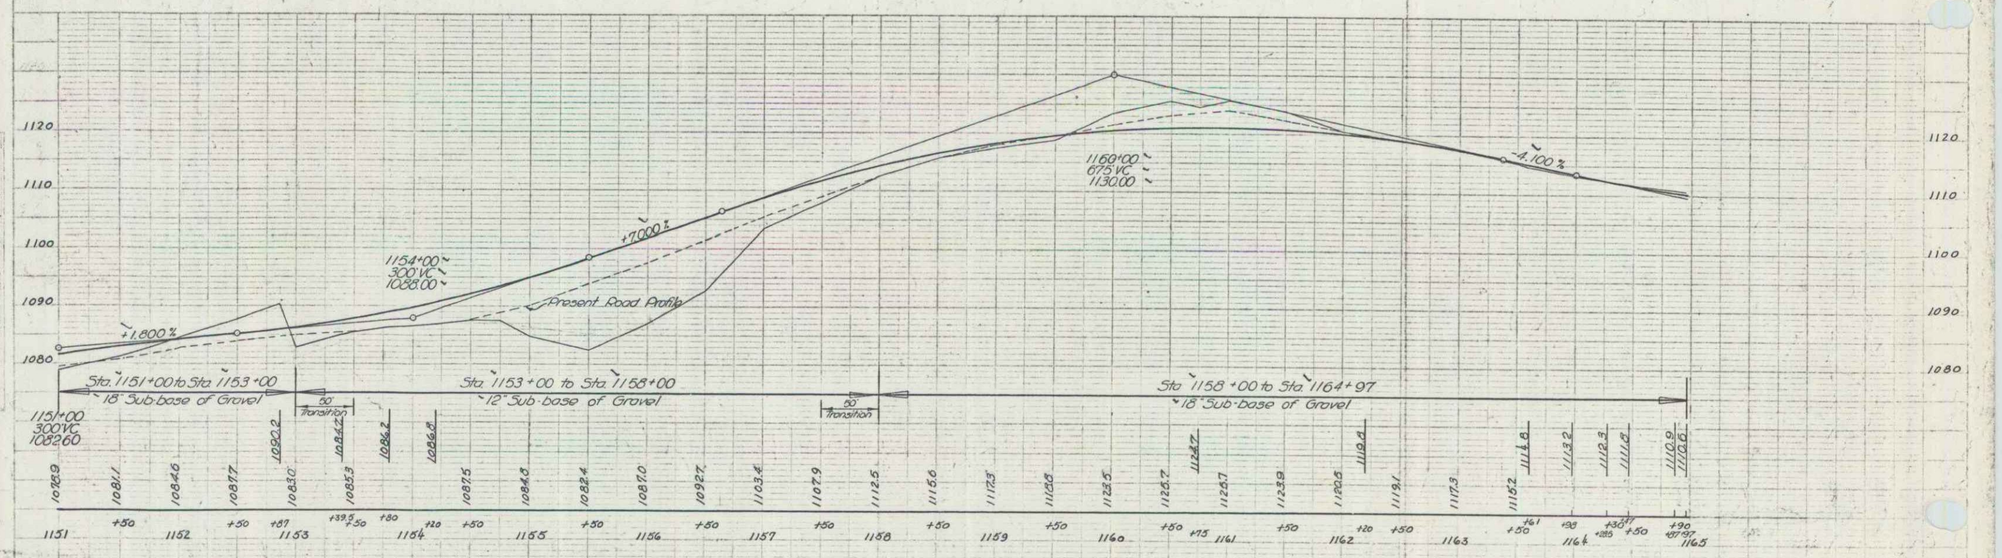

BM #121 Spot on bridge abutment 15' Lt. sta. 1164+93.5 Elev. 1109.82

LOWELL
Series F no. 79(9)
Sheet 24 of 89 sheets

7