PARCEL	INSTRUMENT	DATE	GRANTOR	GRANTEE	RECORDED WESTFIELD BOOK	PAGE	DATE	REMARKS
A	W.D.O.E	12-11-40	MARCEL & JOSEPHINE LAPLUME	ST. OF VT.	74	450-1	12-27-40	

PROJ. NO.	STATE	FED. AID NO.	F.A. PROJ. NO.	TOTAL SHEETS	SHEET NO.	U.S. SHEETS
1			79 E (1)	104A1	14	102

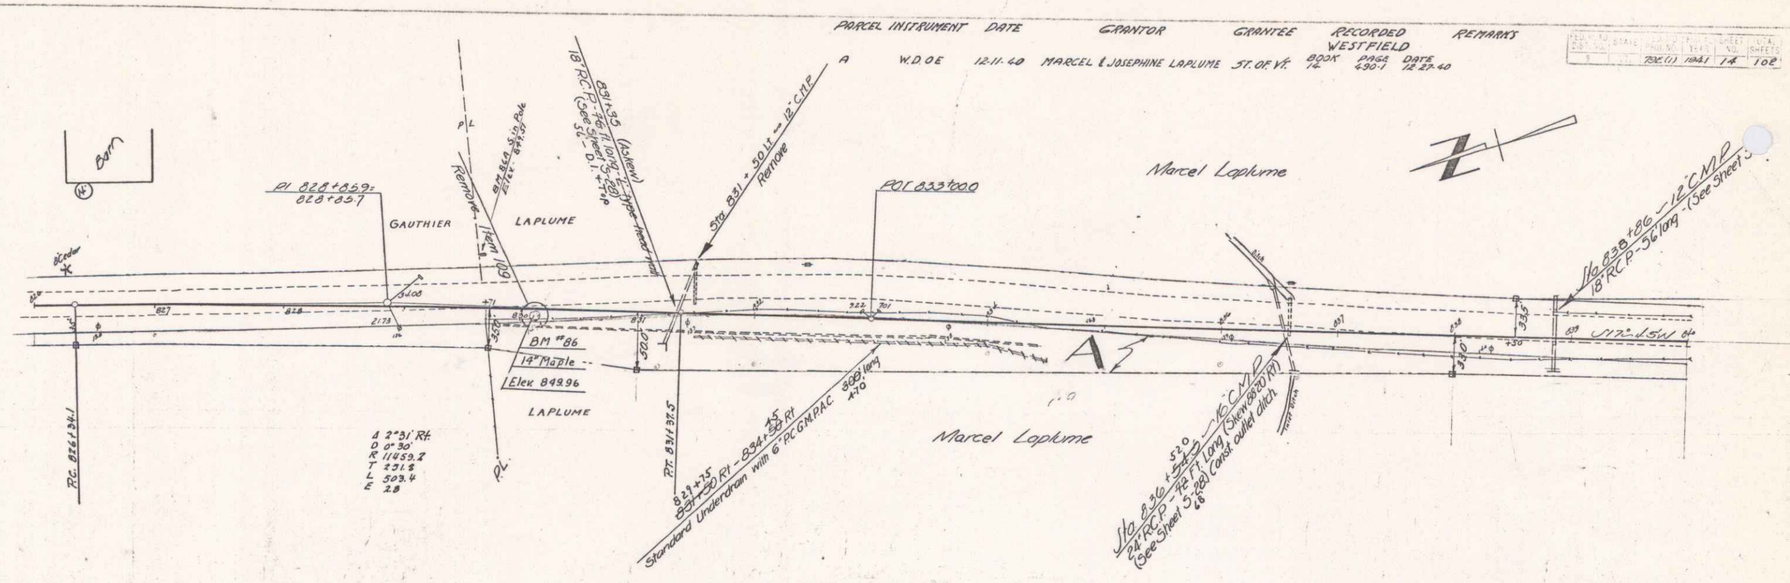

11