PARCEL	INSTRUMENT	DATE	GRANTOR	GRANTEE	RECORDED LOWELL BOOK	PAGE	DATE	REMARKS
B.C.	WDOE	7-21-61	R.E. GIBNEY	ST OF VT	26	346	7-28-61	

Δ 22°09' Lt
D 7°
R 819.0
T 160.3
L 316.4
E 15.3

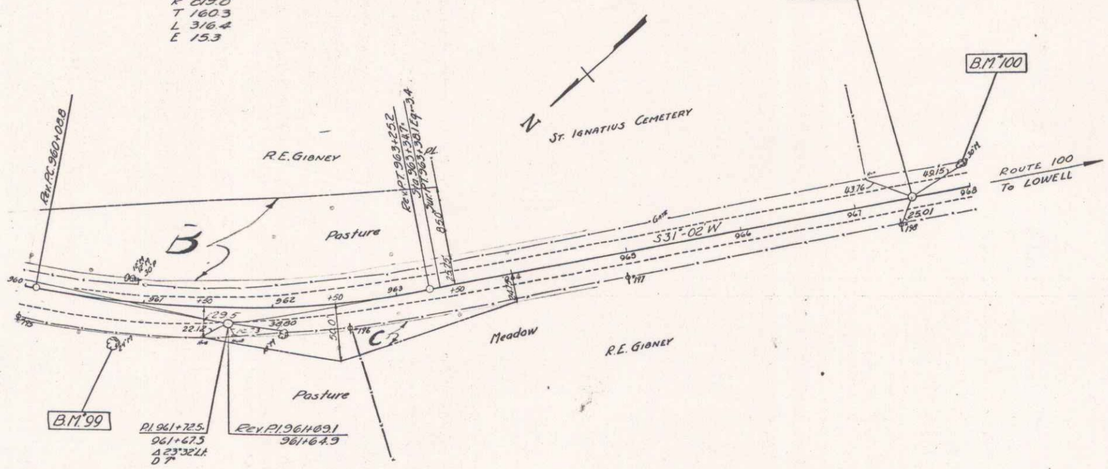

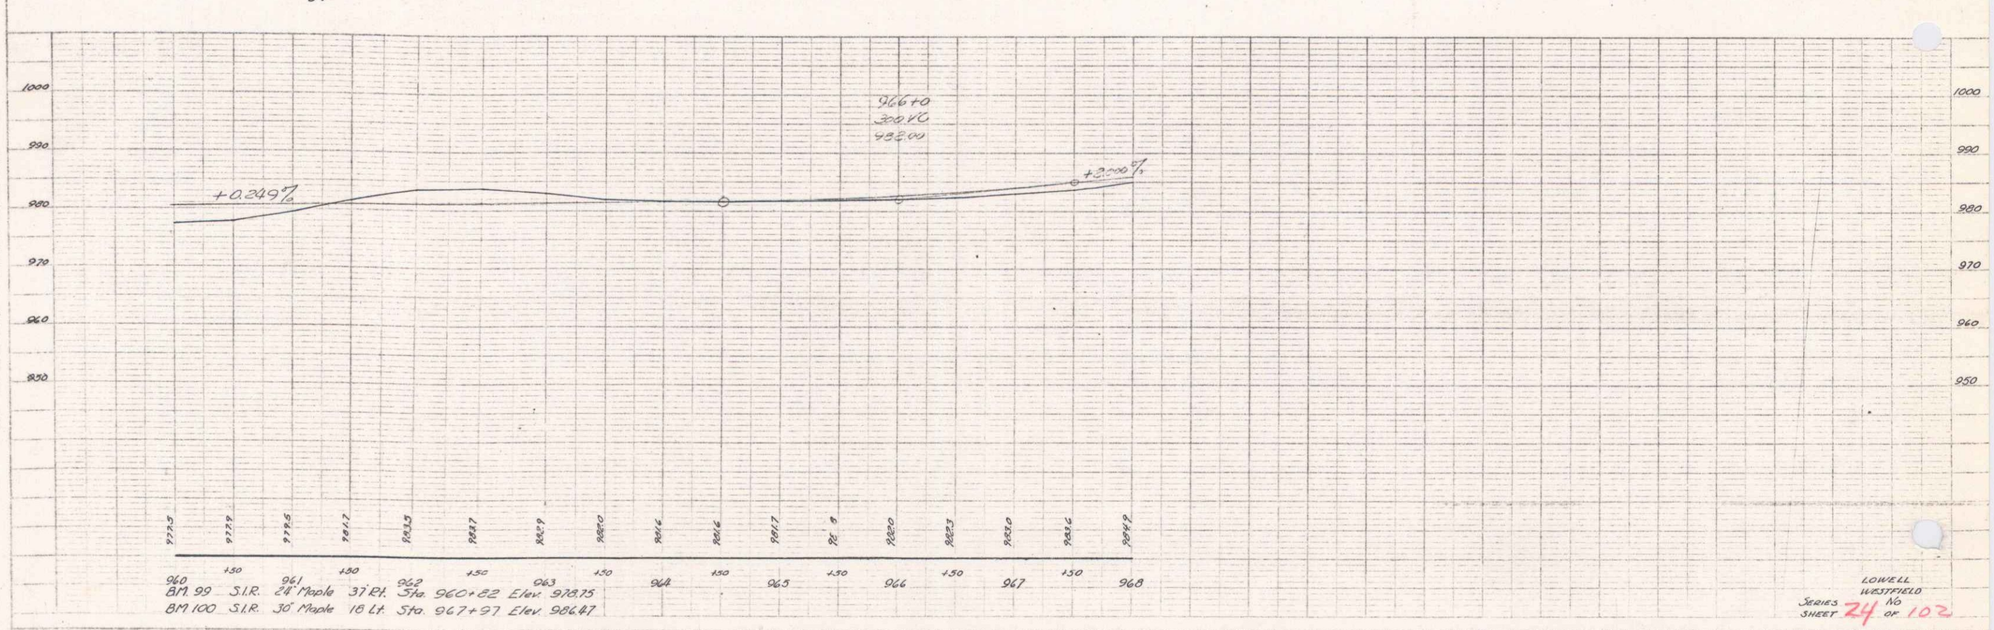

BM 99 S.I.R. 28" Maple 37' Rt. Sta. 960+82 Elev. 978.75
BM 100 S.I.R. 30" Maple 18' Lt. Sta. 967+97 Elev. 986.47

LOWELL
WESTFIELD
SERIES NO
SHEET 24 OF 102

24

21