


PARCEL	INSTRUMENT	DATE	GRANTOR	GRANTEE	RECORDED WESTFIELD BOOK PAGE DATE	REMARKS
A	WDOE	12-11-40	DENNIS DYER	ST. OF VT.	14 517-518 7-4-41	

Δ 7°43' Lt
D 2"
E 6.5
Do not bank

Δ 14°36' Lt
D 5"
R 146.3
T 146.8
L 292.0
E 9.4

798(1) 1941 4 9

PLAT
E. B. WILSON
L. LOWELL
Hood

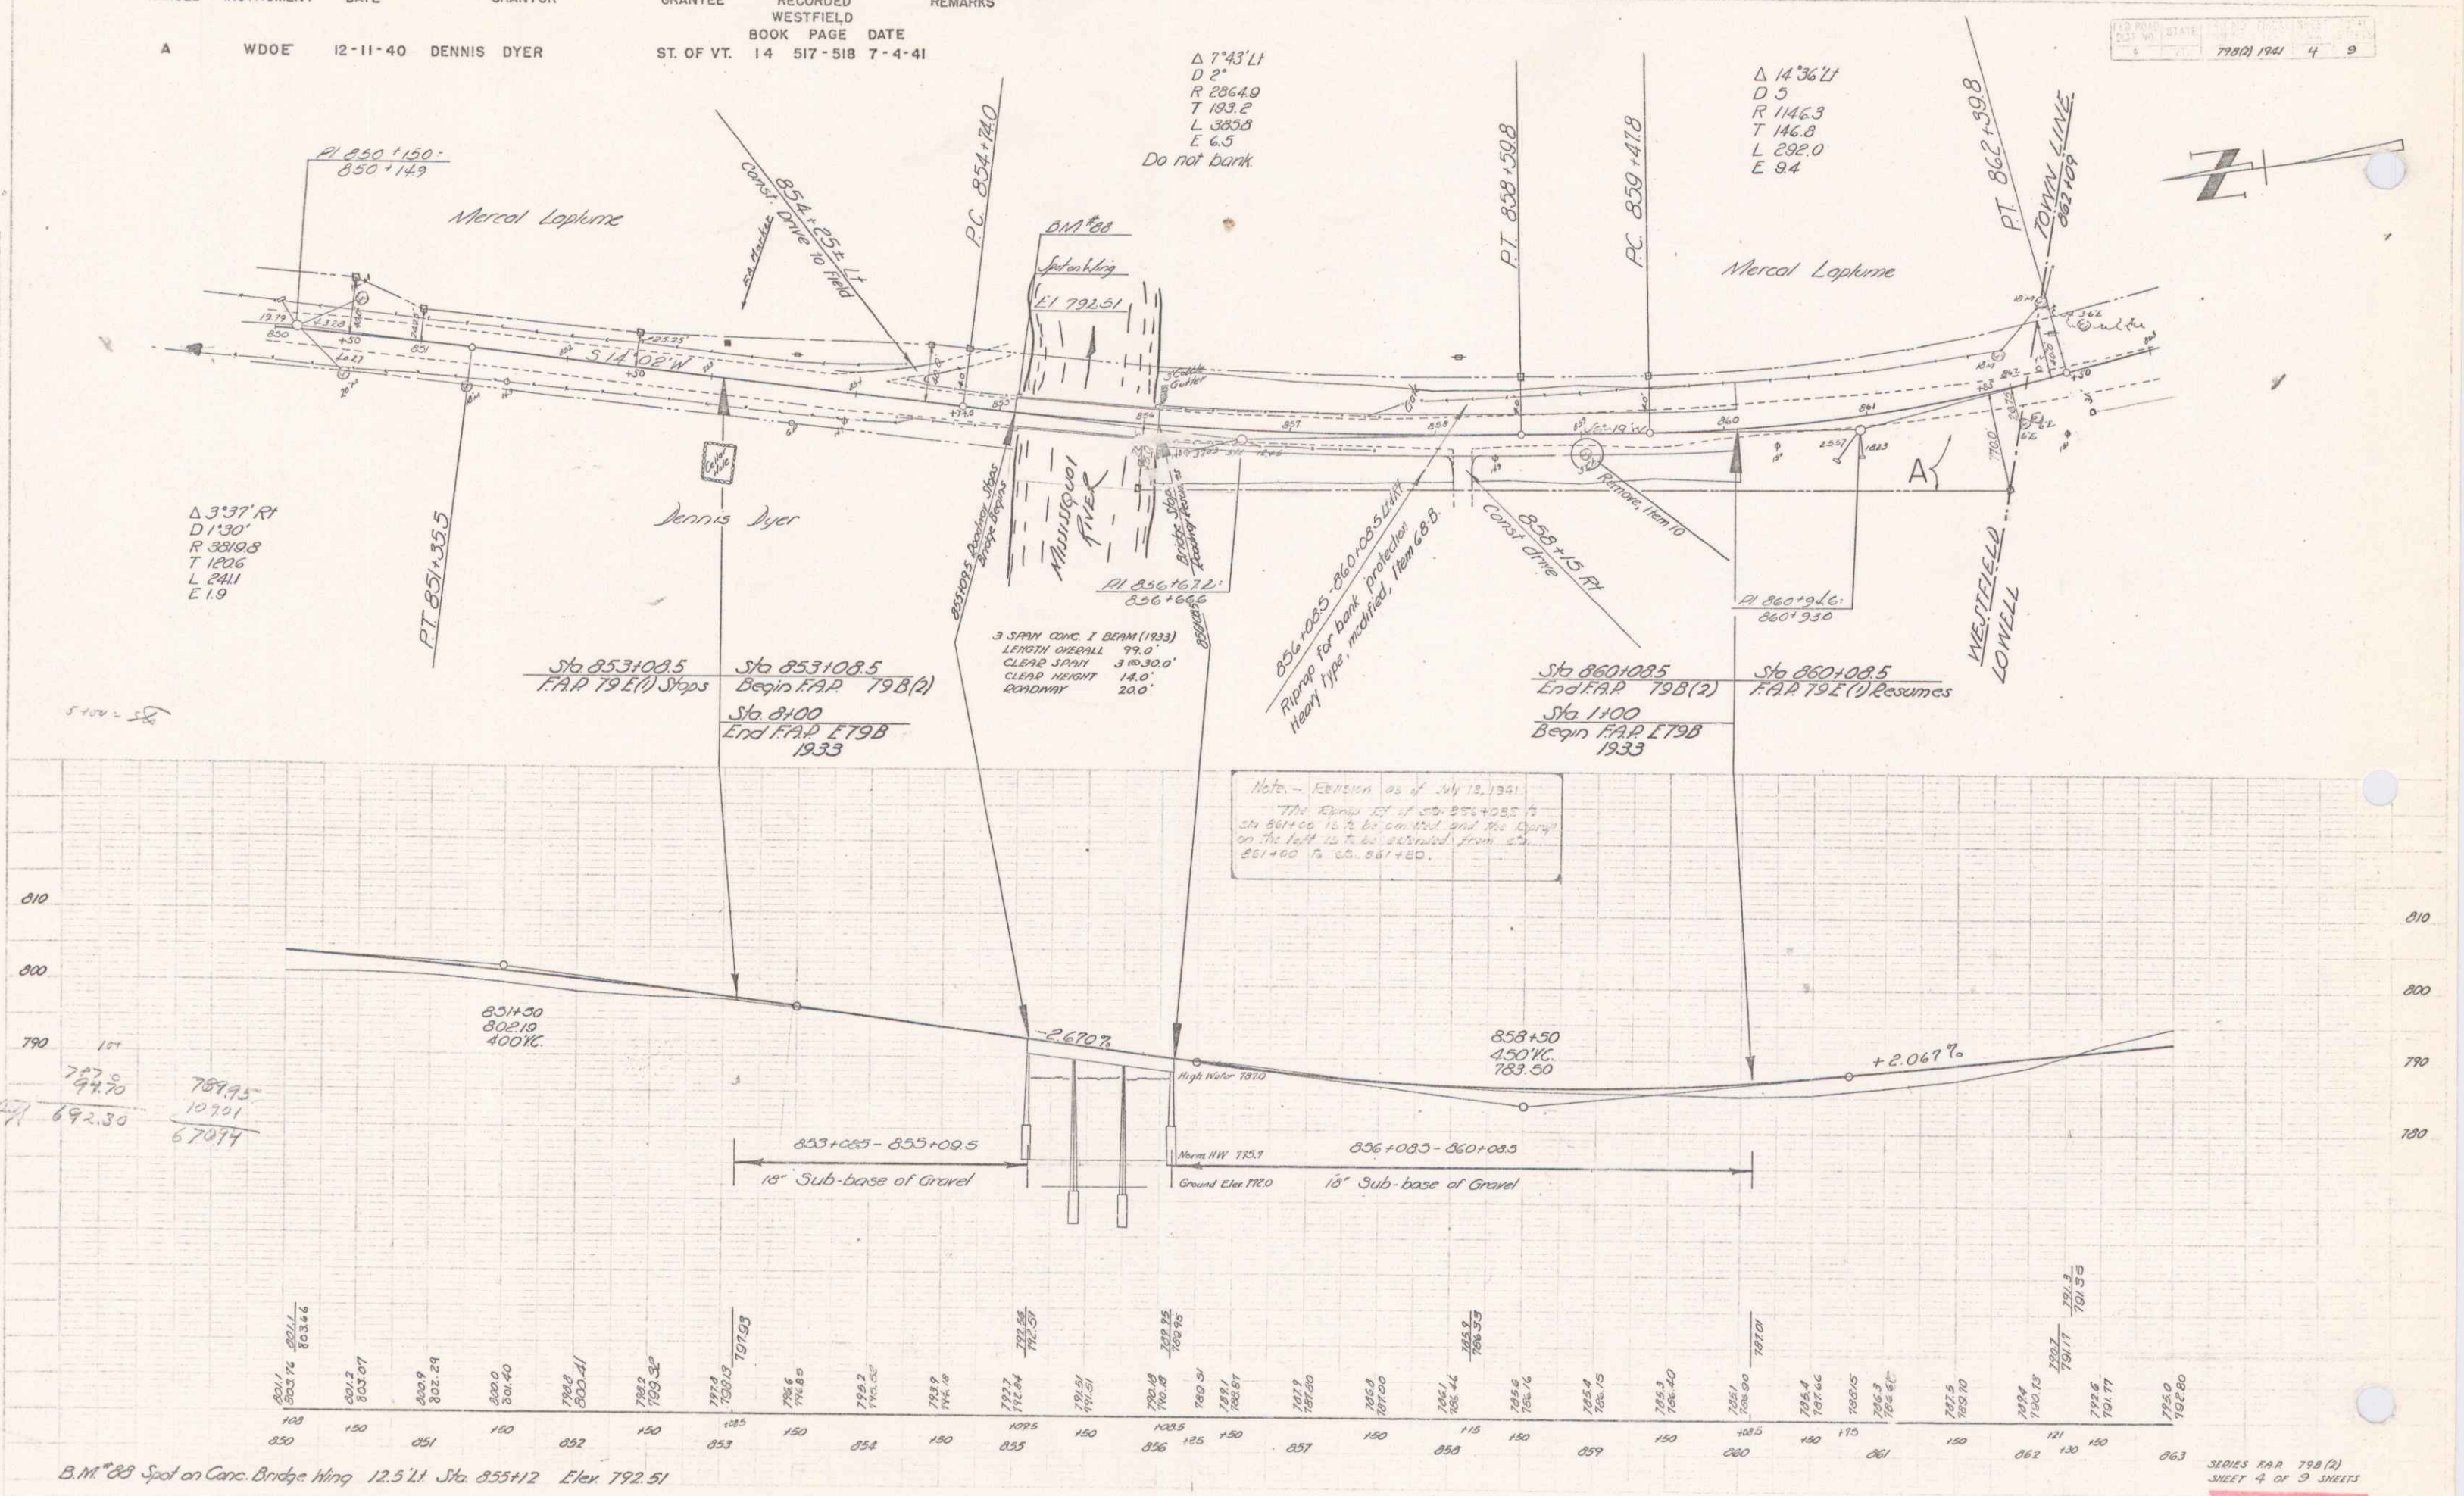

787.95
794.70
692.30
789.95
10701
67074

B.M. 88 Spot on Conc. Bridge Wing 12.5 Lt Sta. 855+12 Elev 792.51

SERIES MAP 798(2)
SHEET 4 OF 9 SHEETS