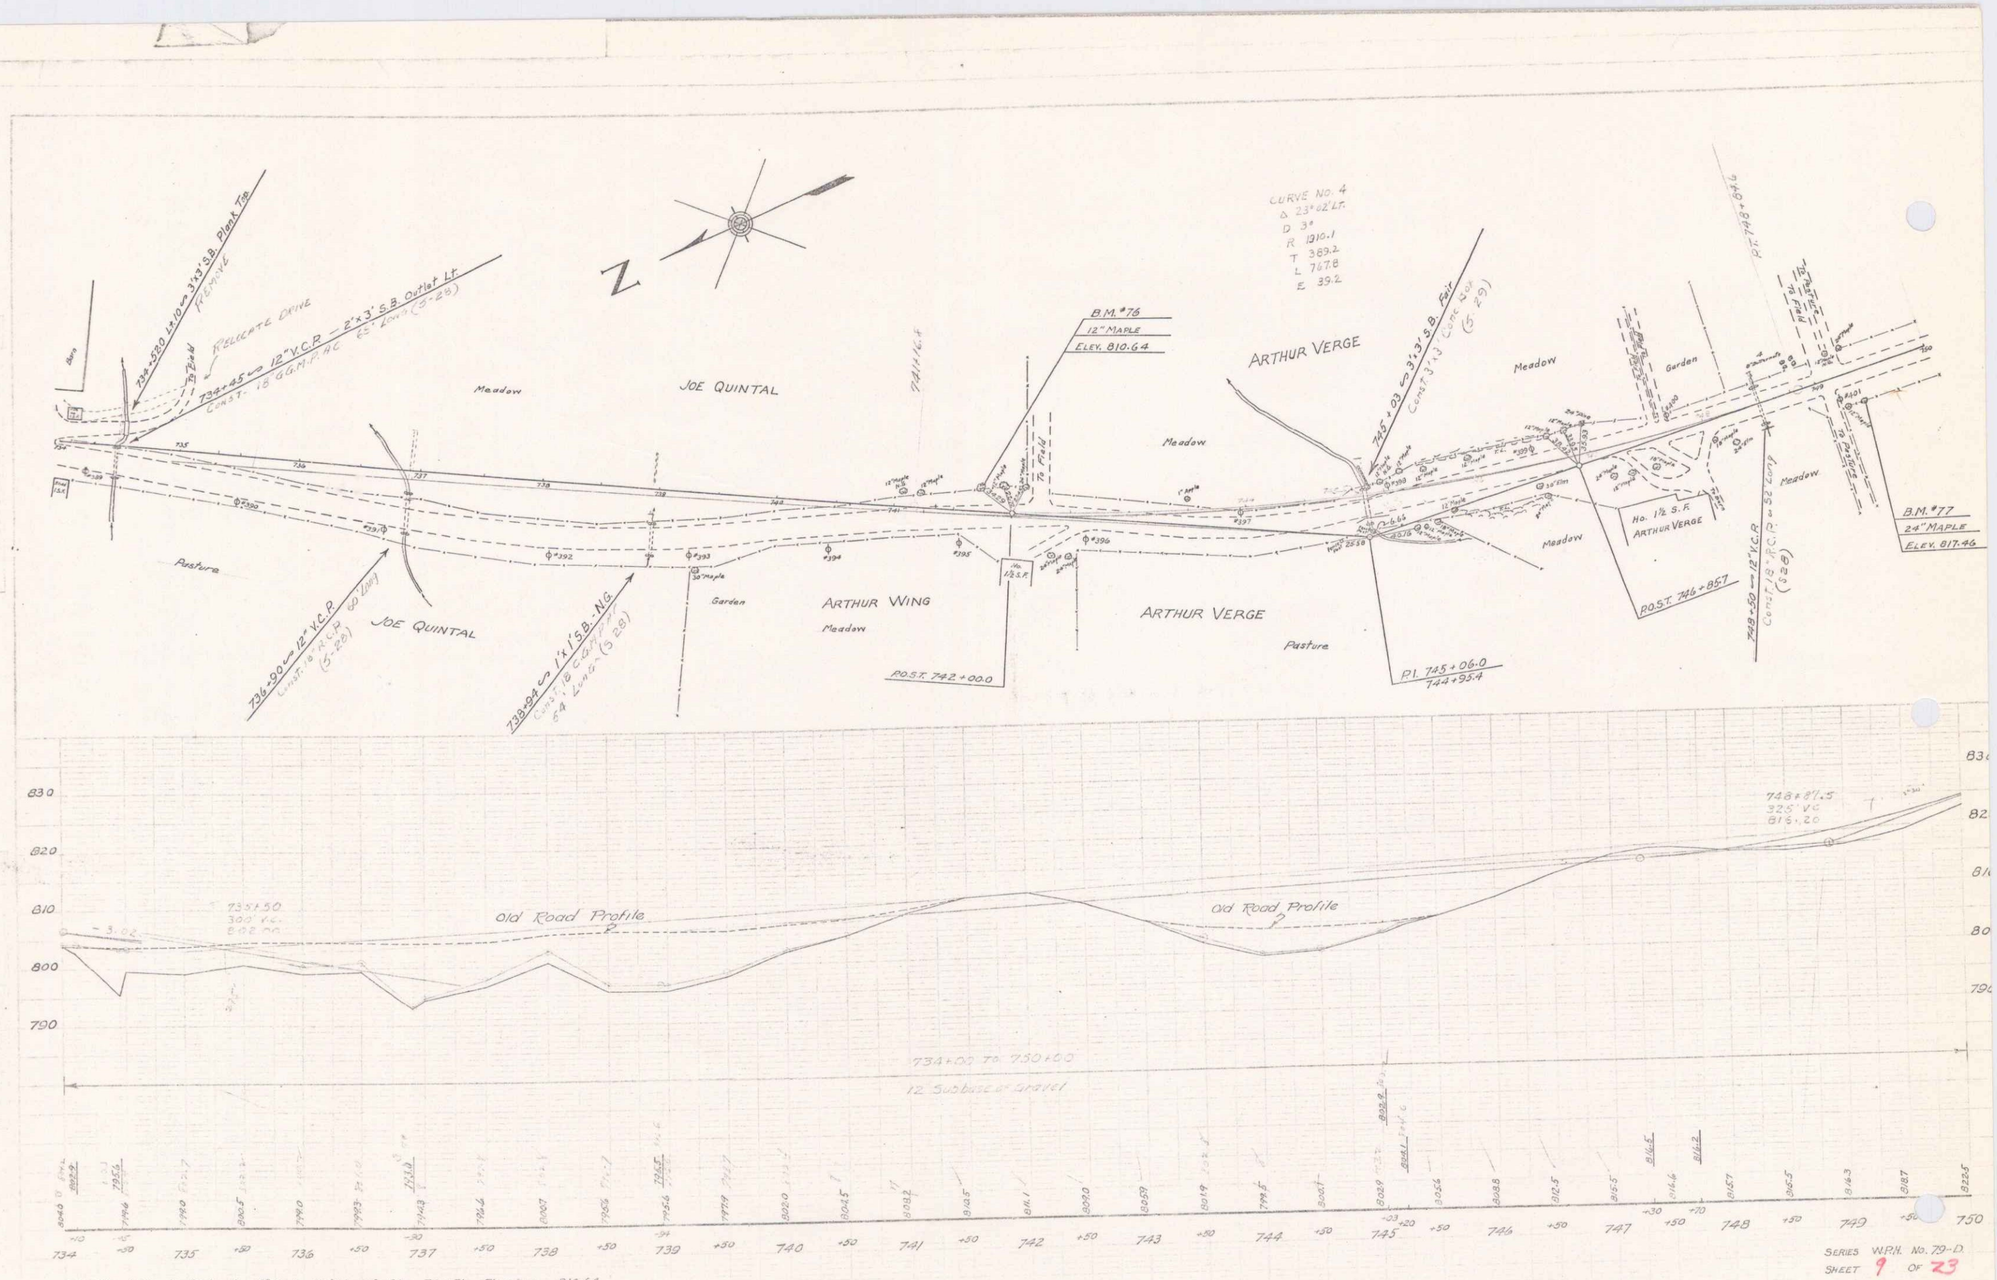

B.M. #76 Spike in Root of 12" Maple 20' Lt. of Sta 741+71 Elevation 810.64
B.M. #77 Spike in Root of 12" Maple 28' Rt. of Sta 749+34 Elevation 817.46

9 7