FED. ROAD PROJ. NO.	STATE	N.H. PROJ. NO.	FISCAL YEAR	SHEET NO.
3	VT	79-C (1935)	1935	5

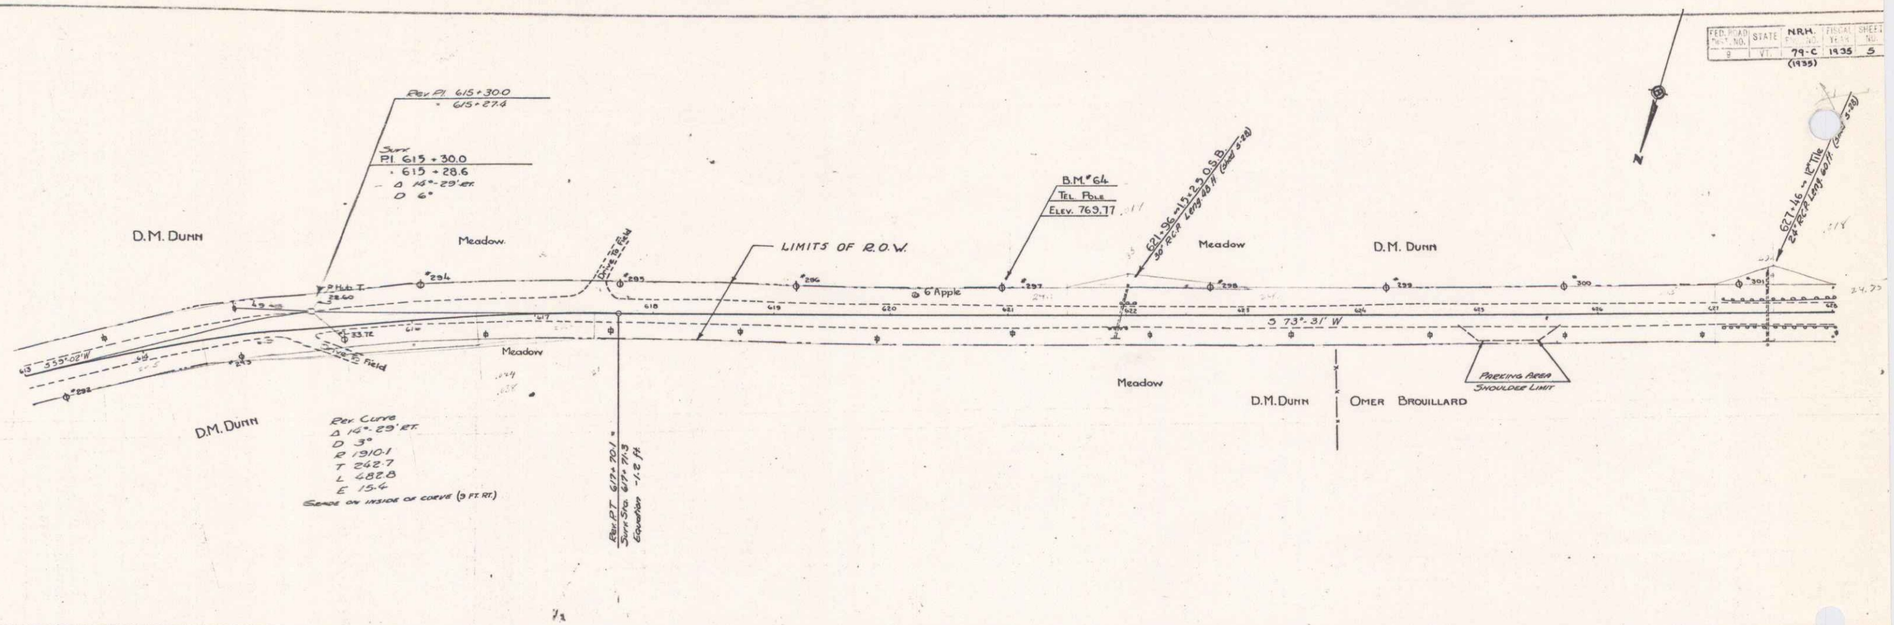

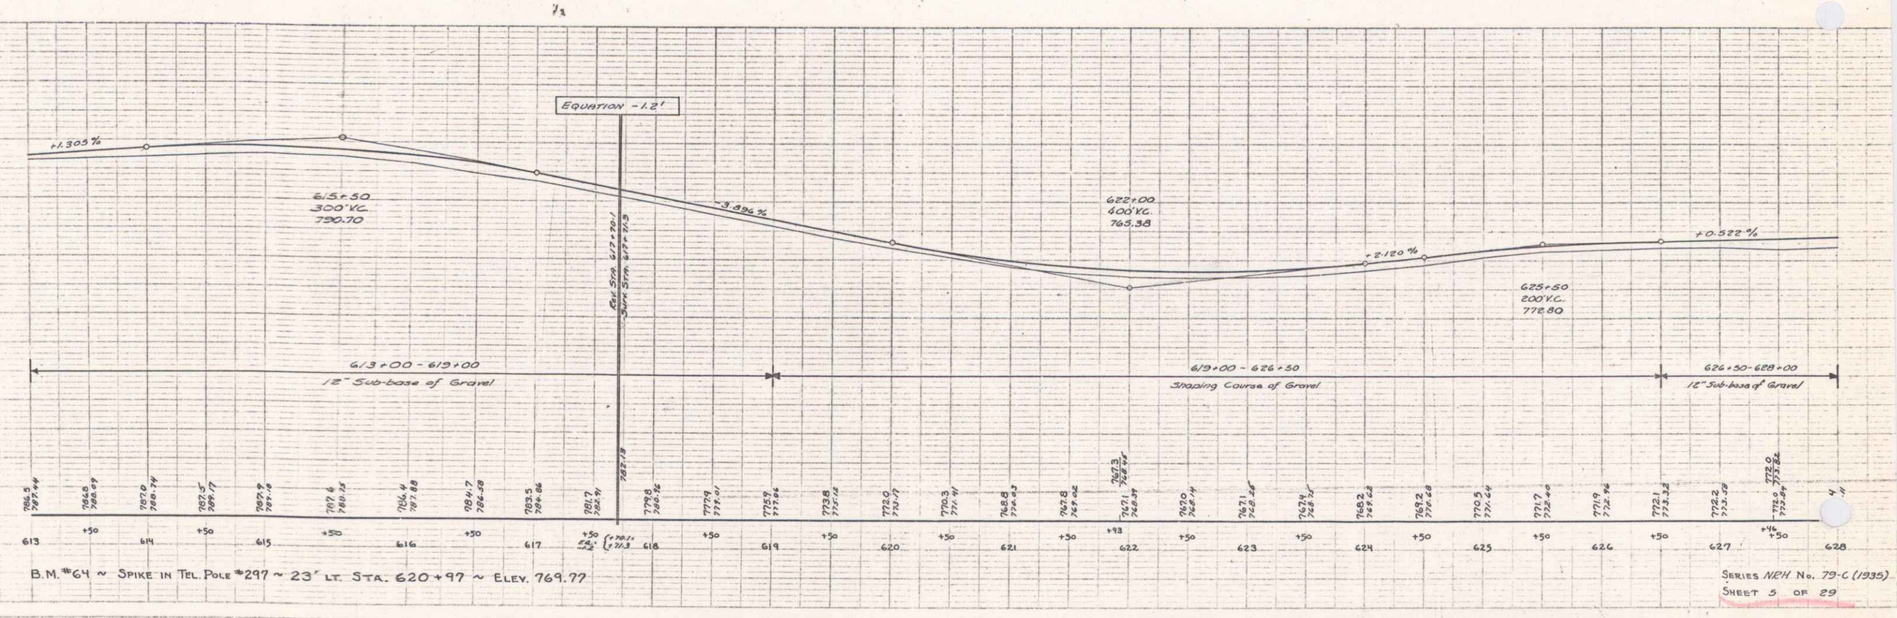

B.M. #64 ~ Spike in Tel. Pole #297 ~ 23' Lt. Sta. 620+97 ~ Elev. 769.77

Series N.H. No. 79-C (1935)
Sheet 5 of 29

3