STATE NRH
79 C 1935
(1935)

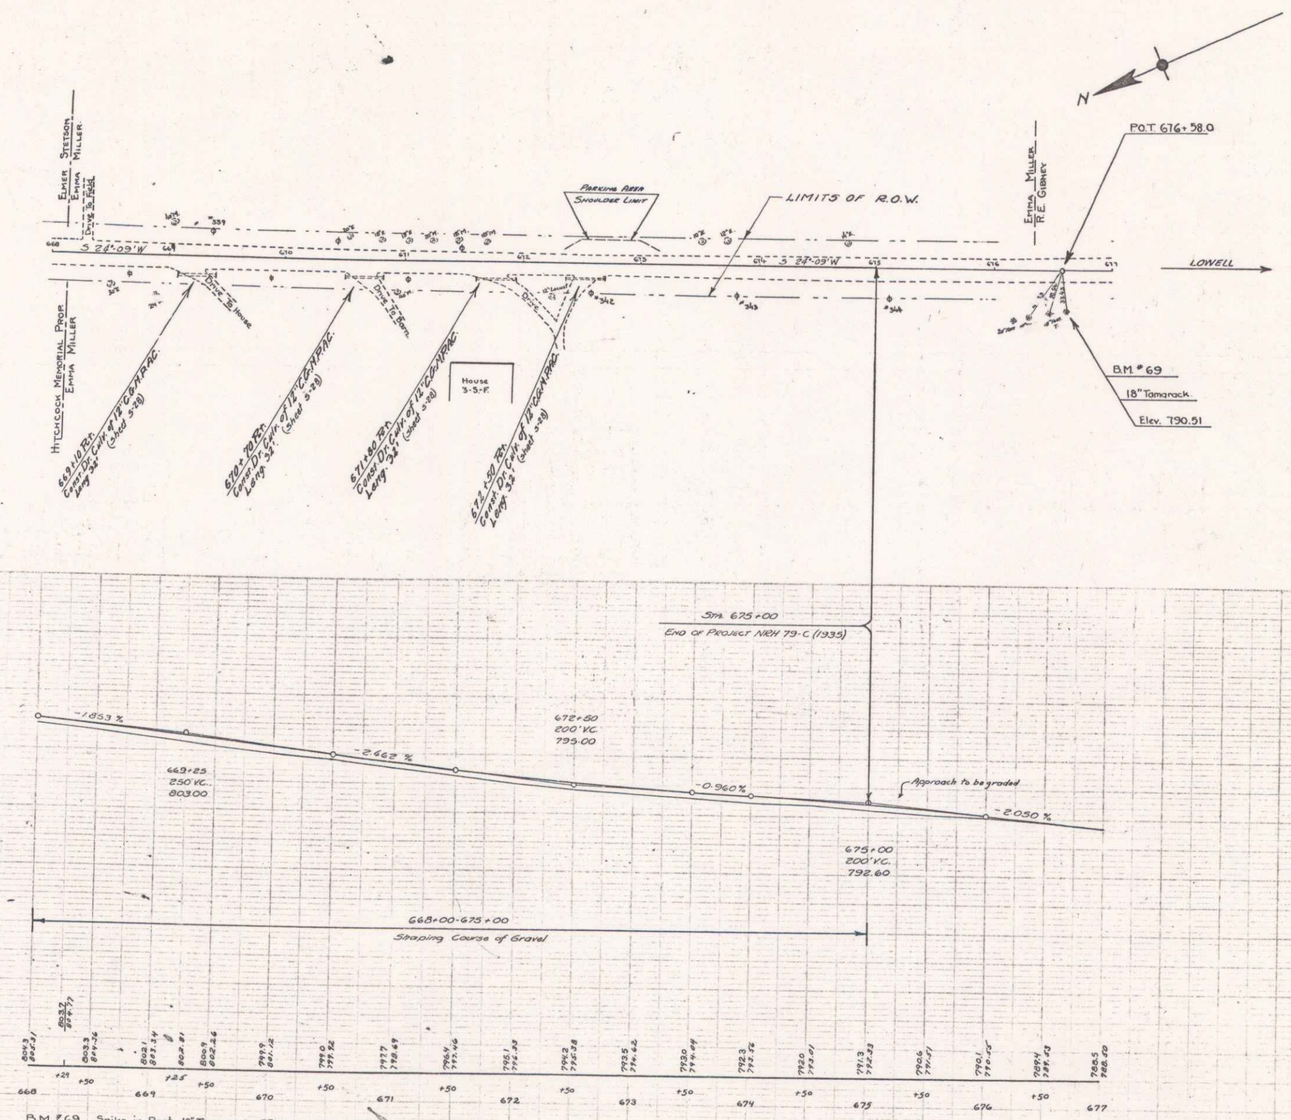

LEACH THOMAS 12-34 12-34

Series NRH No. 79C (1935)
Sheet 9 of 29

7