STATE				
	VT	10-T	1934	8	34

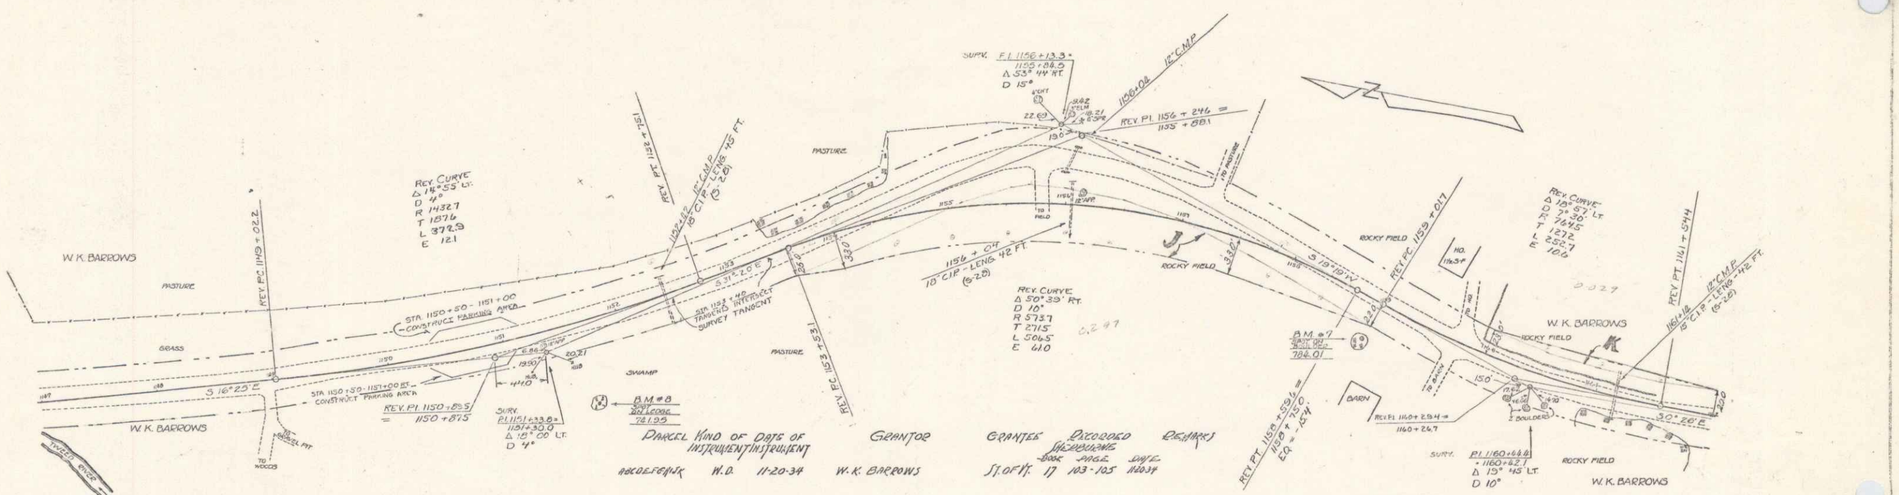

PARCEL NO.	KIND OF INSTRUMENT	DATE OF INSTRUMENT	GRANTOR	GRANTEE	RECORDED BOOK	RECORDED PAGE	DATE	REMARKS
8BCDEFGHIJK	W.D.	11-20-34	W.K. BARROWS	St. of Vt.	17	103-105	11-20-34	

5