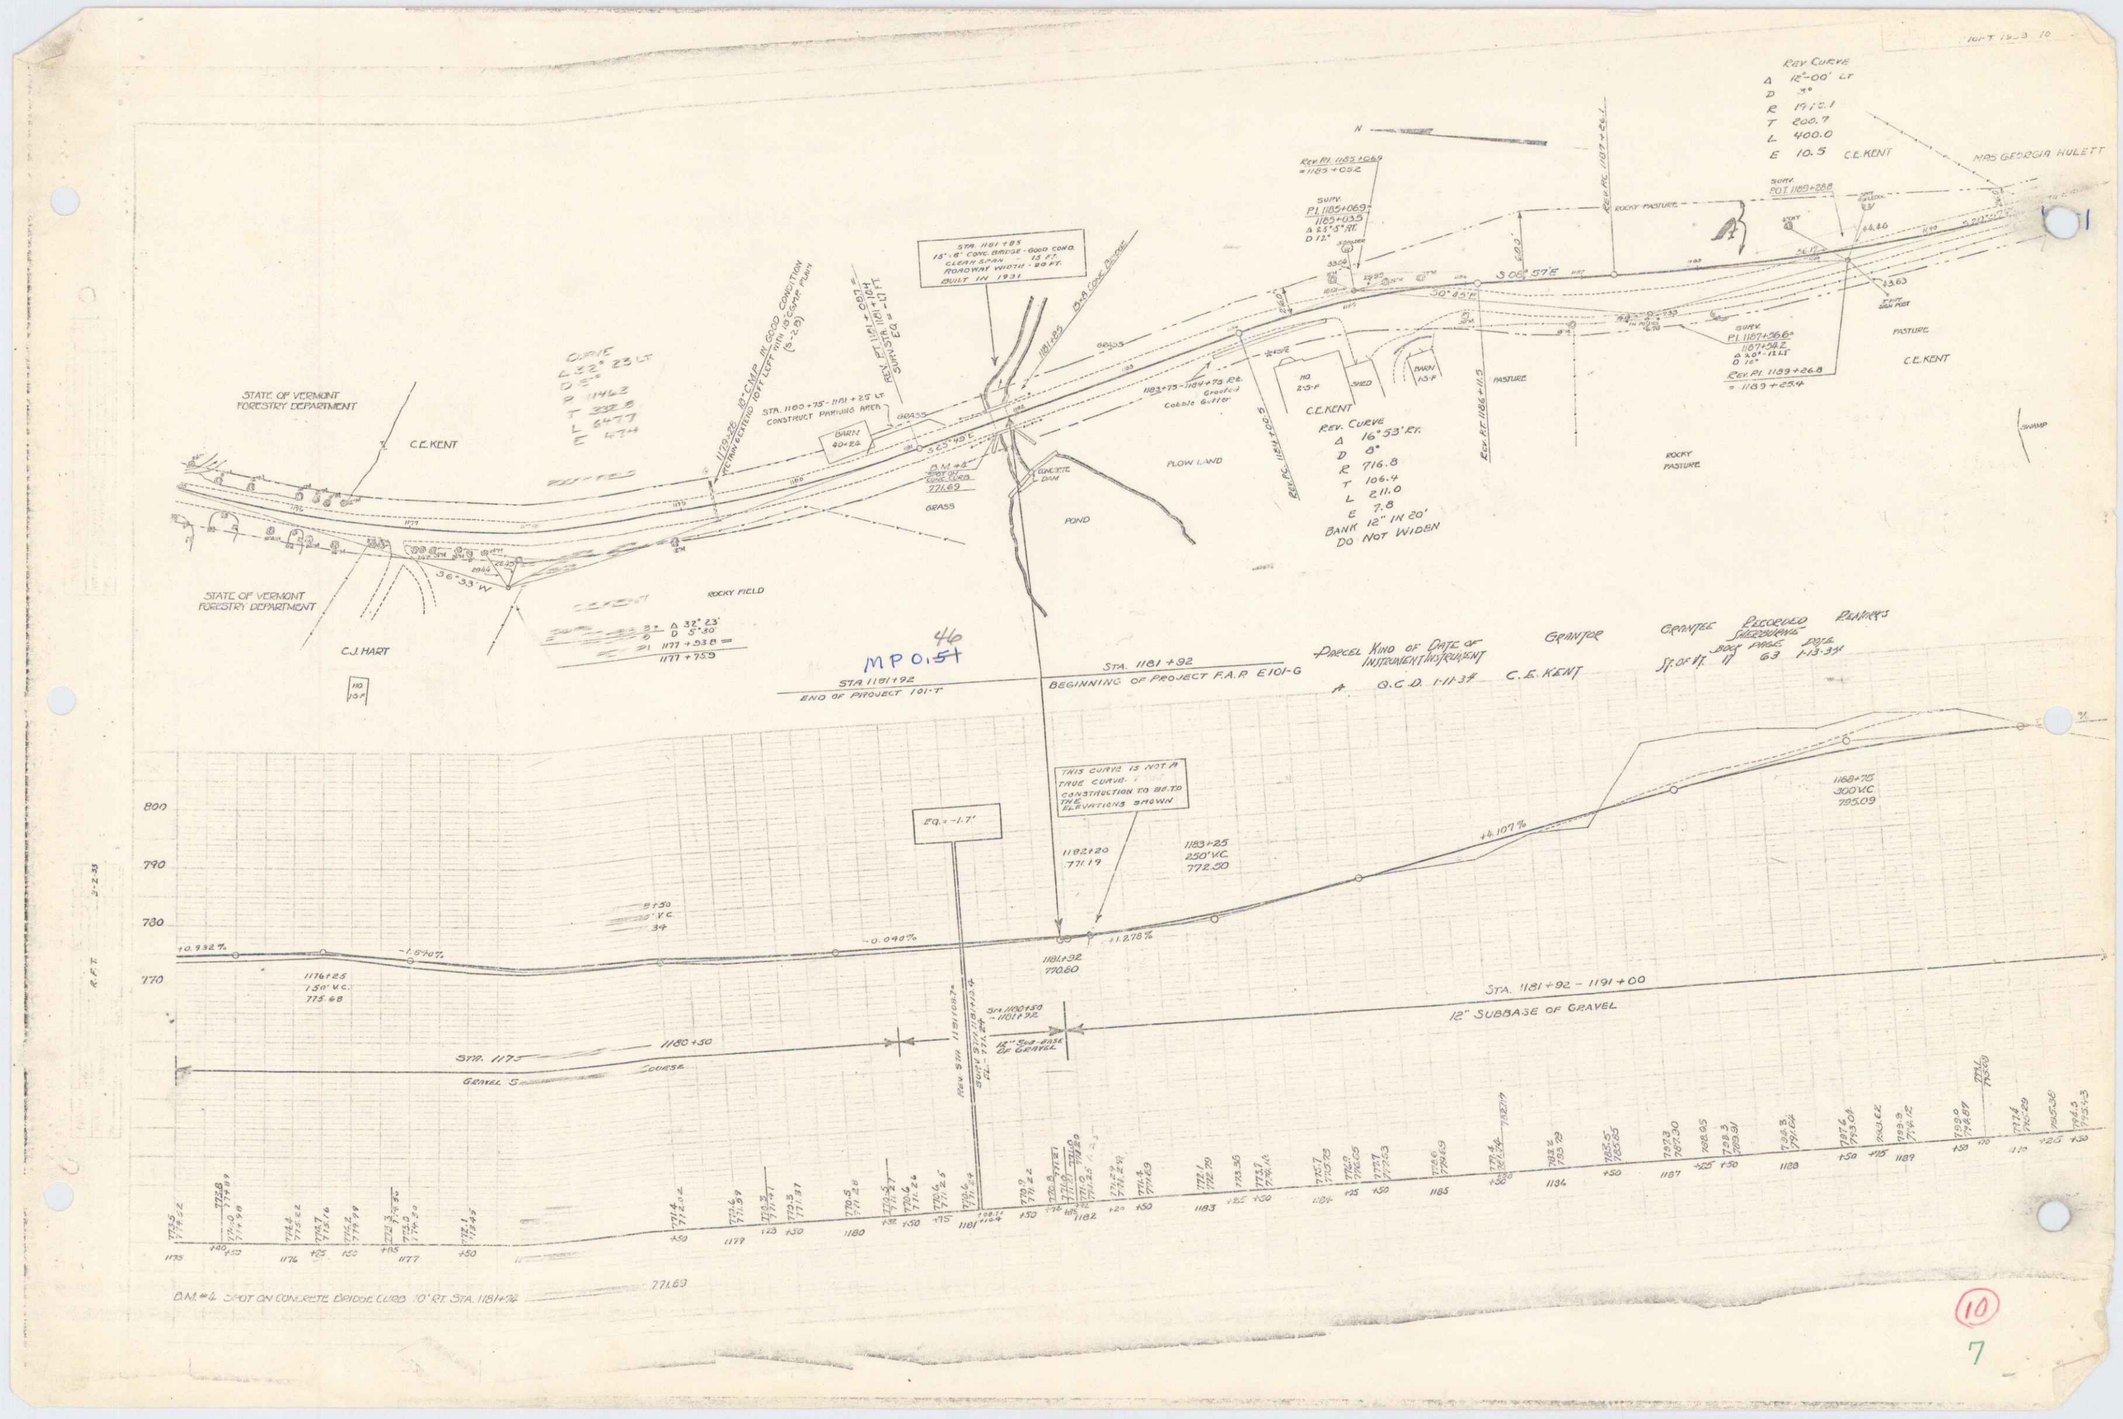
Rev. Curve
Δ 12°-00' Lt
D 4°
R 1431.1
T 200.7
L 400.0
E 10.5
C.E. KENT
MRS GEORGIA HULETT
STATE OF VERMONT FORESTRY DEPARTMENT
C.E. KENT
C.J. HART
STA. 1181 + 85
15' 'B' CONC. BRIDGE - GOOD COND.
CLEAR SPAN - 15 FT.
ROADWAY WIDTH - 20 FT.
BUILT IN 1931
CONCRETE DAM
POND
PLOW LAND
ROCKY FIELD
ROCKY PASTURE
PASTURE
SWAMP
Rev. Curve
Δ 16°53' Rt.
D 8°
R 716.8
T 106.4
L 211.0
E 7.8
BANK 12" IN 20'
DO NOT WIDEN
STA. 1181 + 92
END OF PROJECT 101-T
BEGINNING OF PROJECT F.A.P. E101-G
Parcel Kind of Instrument Date of Instrument Grantor Grantee Recorded Reference Book Page
A Q.C.D. 1-11-34 C.E. KENT
Sf. of Vt. 11 63 1-13-34
THIS CURVE IS NOT A TRUE CURVE. CONSTRUCTION TO BE TO THE ELEVATIONS SHOWN
EQ. = -1.7'
STA. 1181 + 92 - 1191 + 00
12" SUBBASE OF GRAVEL
GRAVEL SURFACE
D.M. #4 SPOT ON CONCRETE BRIDGE CURB 10' RT. STA. 1181+74
77.63
MP 0.51
46
10
7